PARENT PARCEL: 05-00-032-000-003

CHILD PARCEL:

STARTING POINT: West line of O.L. 32 & cL of Milan-Elyria Rd.

NO. 22491-S

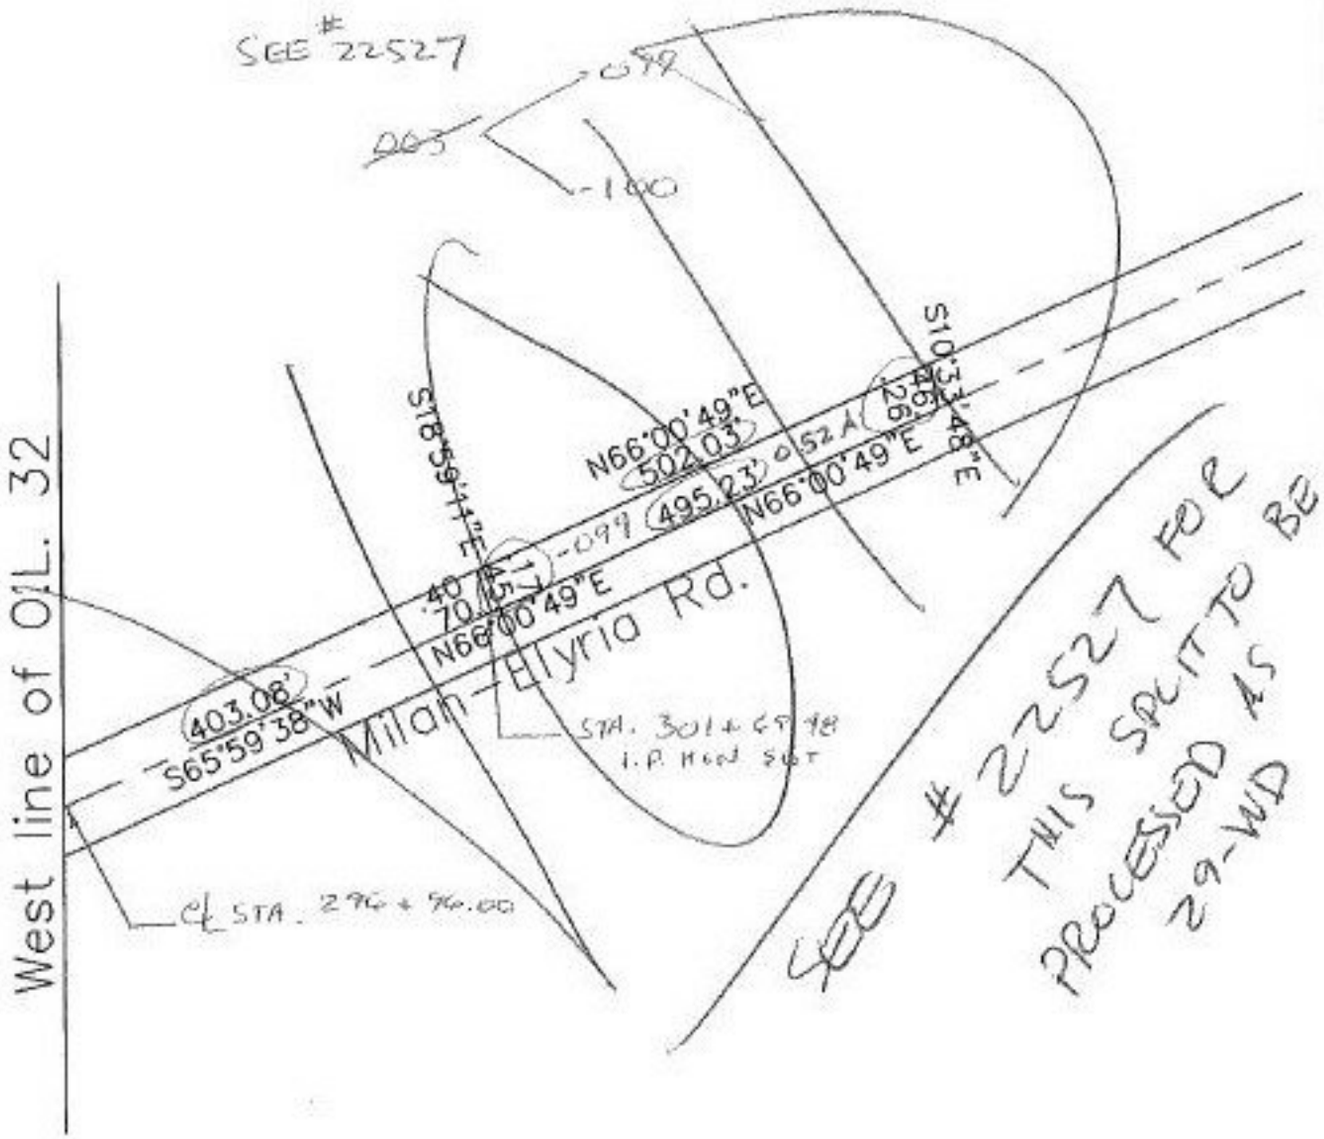

SPLITS/DEEDS PROCESSED

LORAIN COUNTY TAX MAP DEPARTMENT

226 MIDDLE AVE. ELYRIA, OHIO

SURVEYED BY: ODOT

CLOSURE: 0.02:10,000

MAP PAGE(S): 05-00-032-A

APPROVED BY: kac DATE: 4/10/98

SCALE: 1" = 200 PRIOR INSTRUMENT: