PARENT PARCEL: 07-00-016-104-165

CHILD PARCEL: 07-00-016-104-166, 167

STARTING POINT: W. line of Pitts Blvd. & NE corner of S/L 1 in Wil-lou Acres Subd. No. 1

NO. 22496

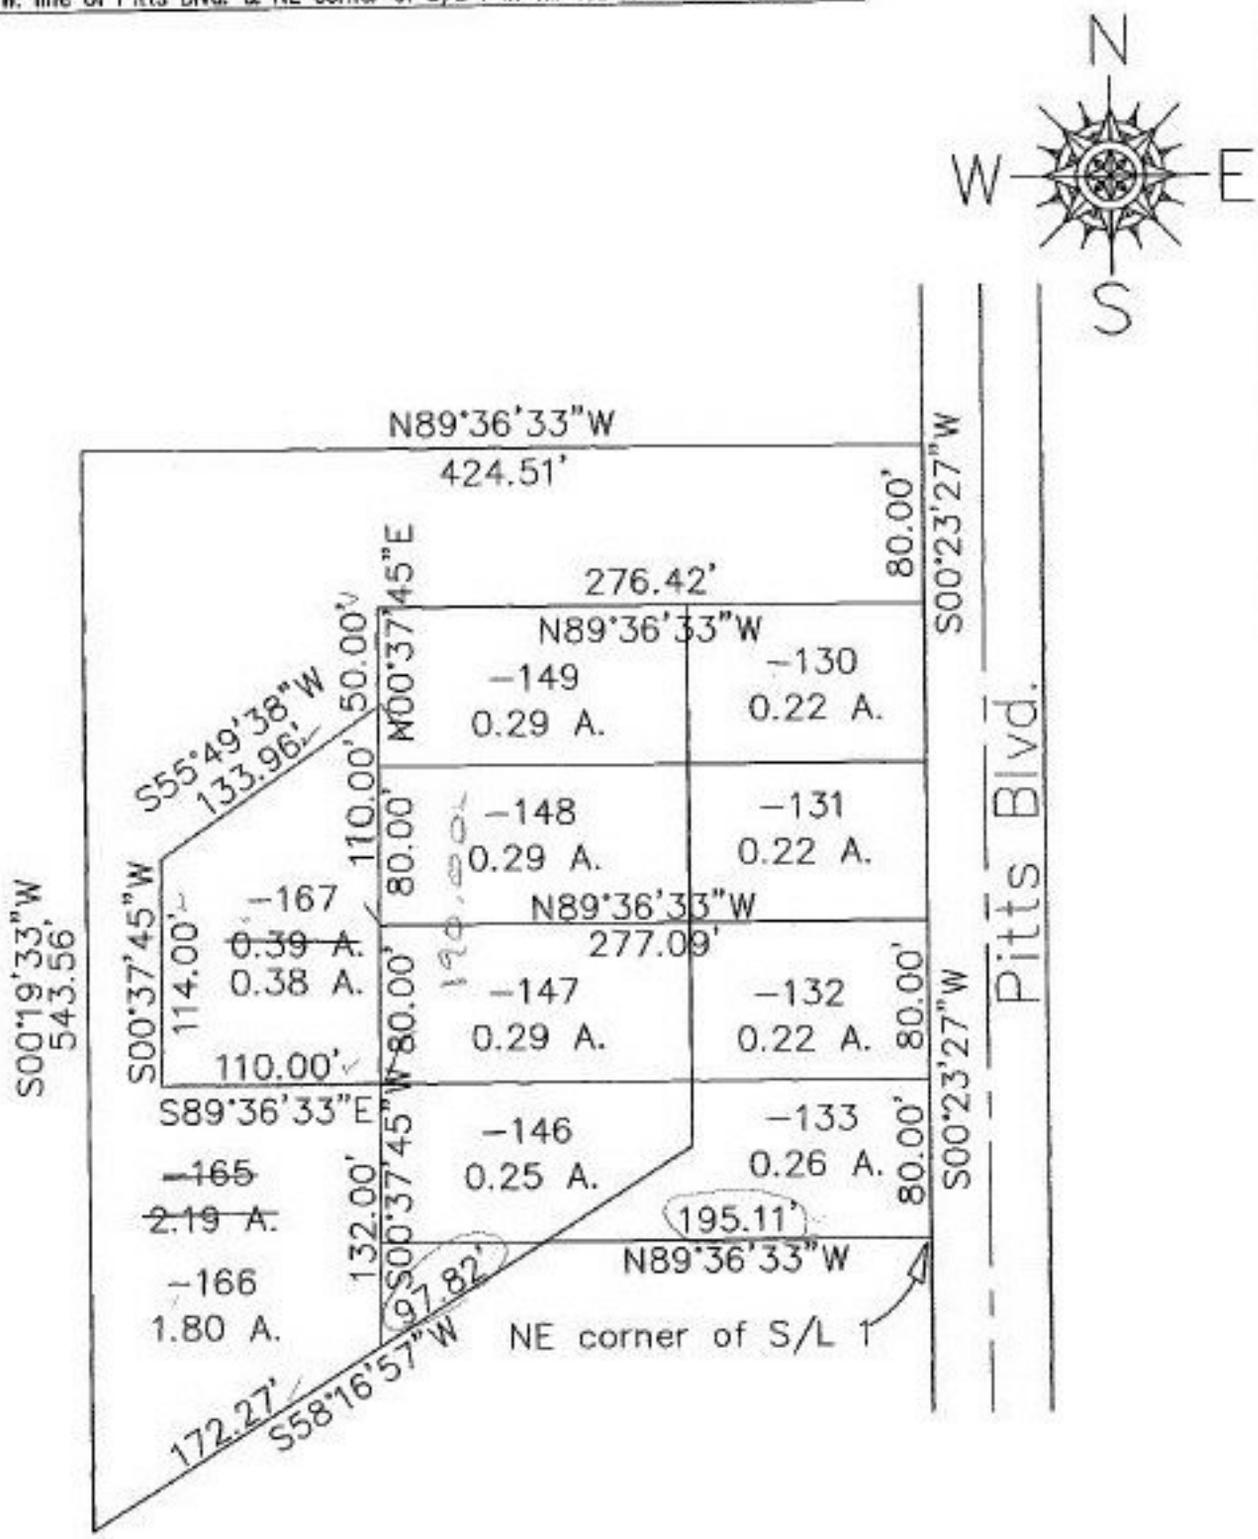

SPLITS/DEEDS PROCESSED

LORAIN COUNTY TAX MAP DEPARTMENT
226 MIDDLE AVE. ELYRIA, OHIO

SURVEYED BY: Dane A. Haponek

CLOSURE: 0.02:10,000

MAP PAGE(S): 07-00-016-B

APPROVED BY: kac DATE: 4/10/98

SCALE: 1"= 100 PRIOR INSTRUMENT: DV 1042/904