PARENT PARCEL: 08-15-017-000-013, 016, & 017

CHILD PARCEL: 08-15-017-000-020 THRU -023

STARTING POINT: CL. OF GARFIELD RD. & N.E. CORNER OF O.L. 17

NO. 22503

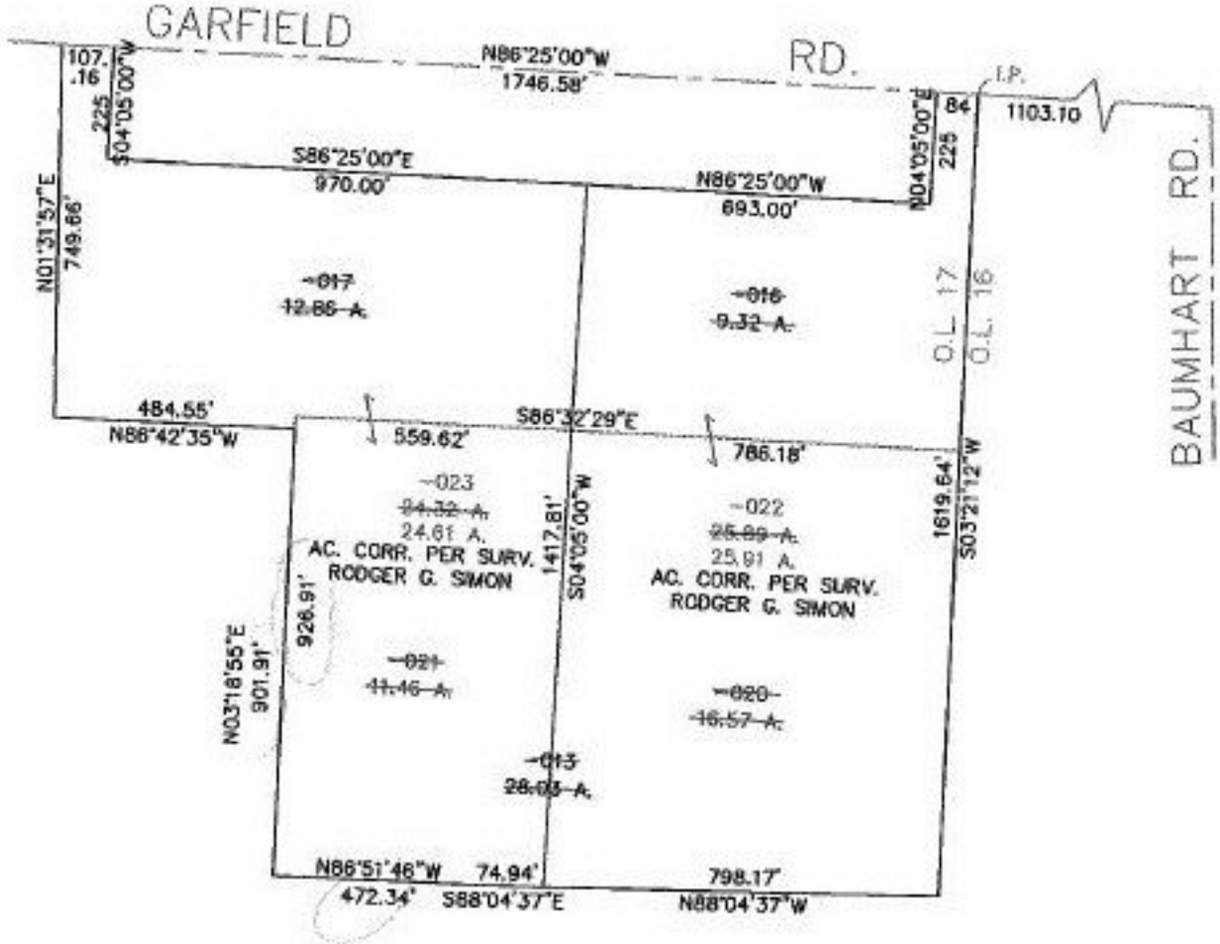


SPLITS/DEEDS PROCESSED

LORAIN COUNTY TAX MAP DEPARTMENT
226 MIDDLE AVE. ELYRIA, OHIO

SURVEYED BY: RODGER G. SIMON

CLOSURE: 0.05 : 10,000

MAP PAGE(S): 8-H

APPROVED BY: TJS DATE: 05/21/98

SCALE: 1" = 400 PRIOR INSTRUMENT: DV 881/913