PARENT PARCEL: 05-00-018-101-055
CHILD PARCEL: 05-00-018-101-056, 057
STARTING POINT: cL of North Lake St. & cL of West Martin St.

NO. 22504

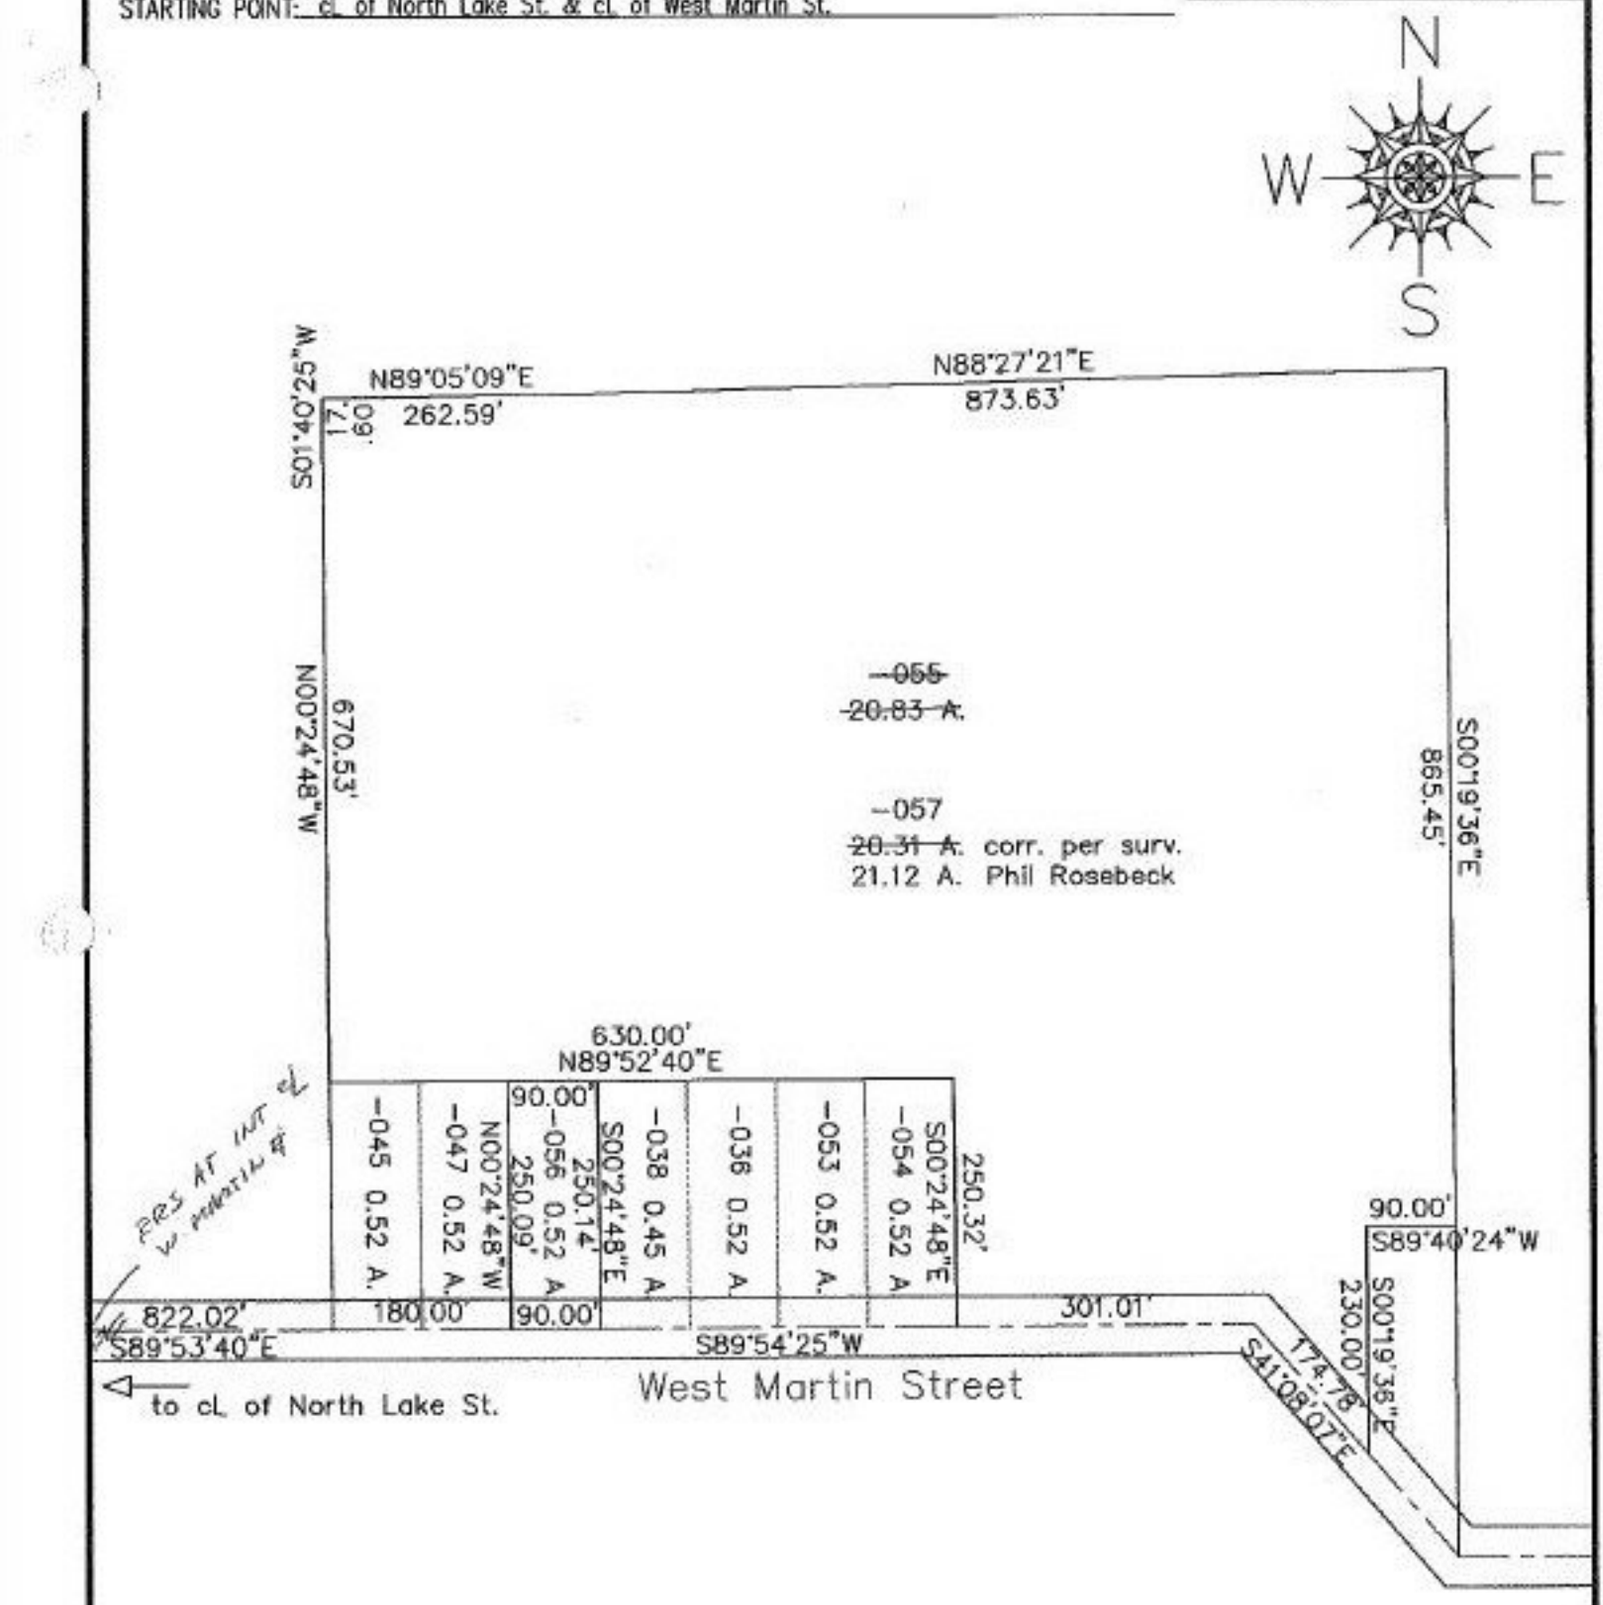

SPLITS/DEEDS PROCESSED

LORAIN COUNTY TAX MAP DEPARTMENT
226 MIDDLE AVE. ELYRIA, OHIO

SURVEYED BY: Phillip Rosebeck
CLOSURE: 0.06:10,000
MAP PAGE(S): 05-00-018-A & B
APPROVED BY: kac DATE: 4/22/98
SCALE: 1"= 200 PRIOR INSTRUMENT: OR 1346/673