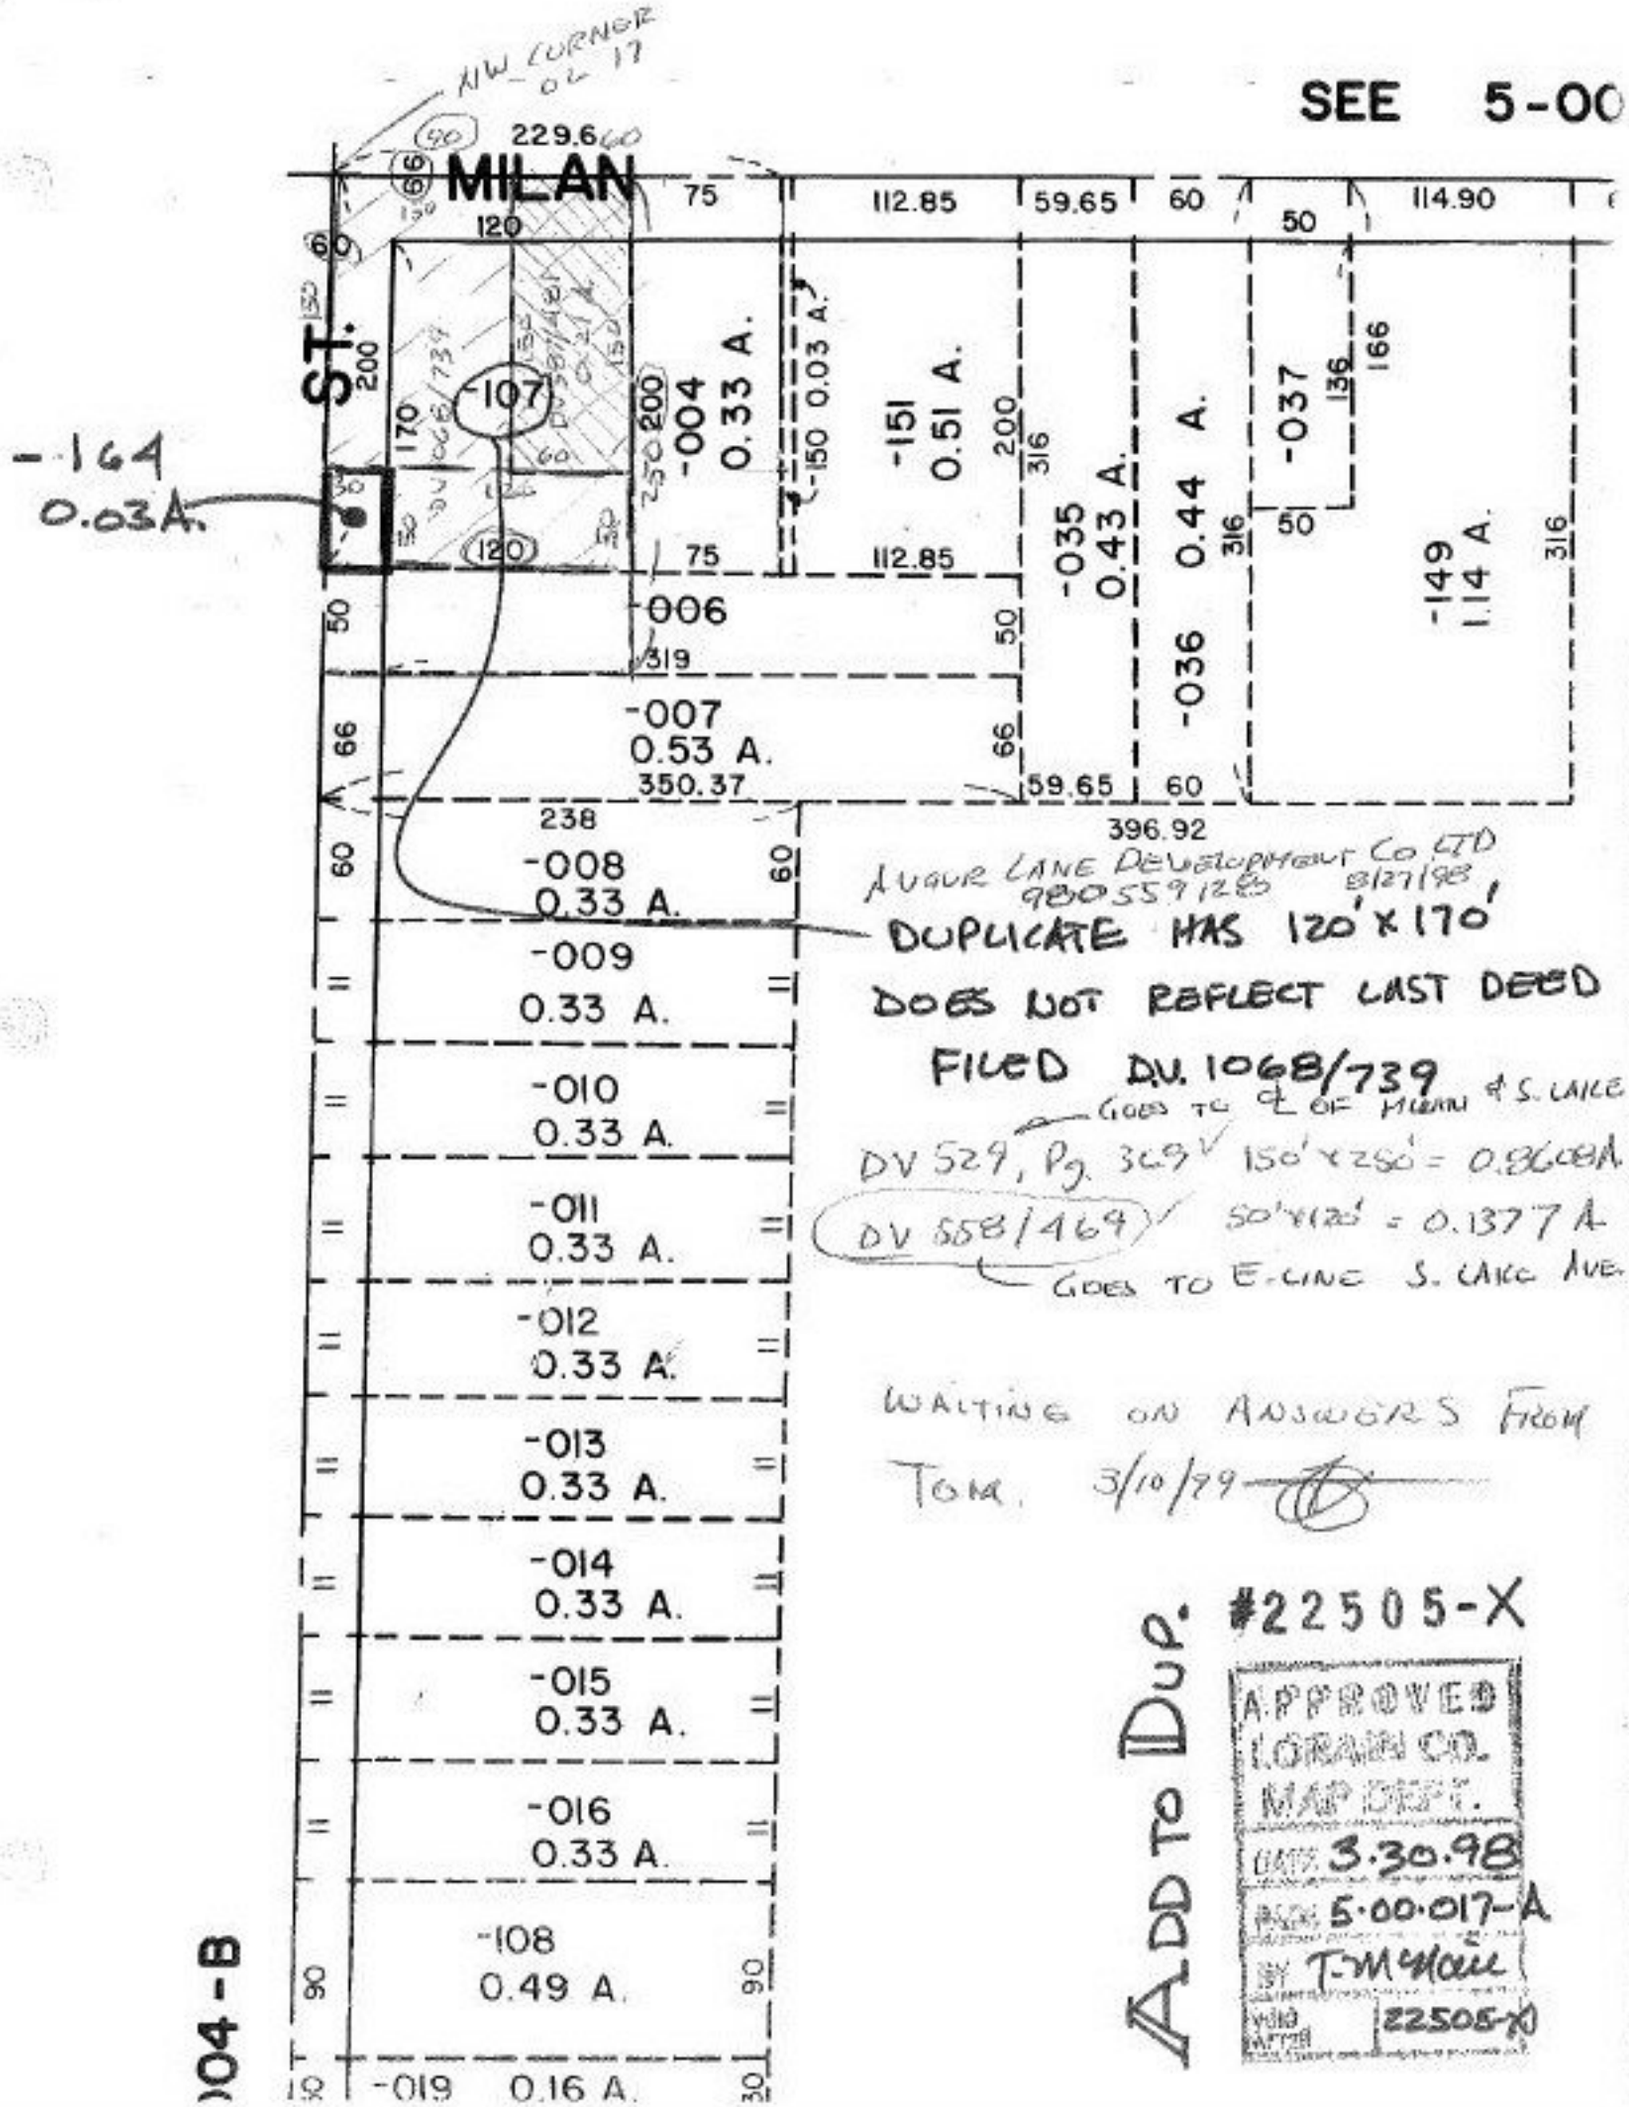

AUGUR LANE DEVELOPMENT CO LTD
980559128 8/27/98

DUPLICATE HAS 120' x 170'
DOES NOT REFLECT LAST DEED
FILED D.V. 1068/739

GOES TO ℄ OF MILAN & S. LAKE

DV 529, Pg. 369 150' x 250' = 0.8608A

DV 558/469 50' x 120' = 0.1377 A

GOES TO E-LINE S. LAKE AVE.

WAITING ON ANSWERS FROM
TOM. 3/10/99

ADD TO DUP.

#22505-X

APPROVED
LORAIN CO.
MAP DEPT.
DATE 3.30.98
PAGE 5.00.017-A
BY T. McNair
VOID AFTER 22505-X