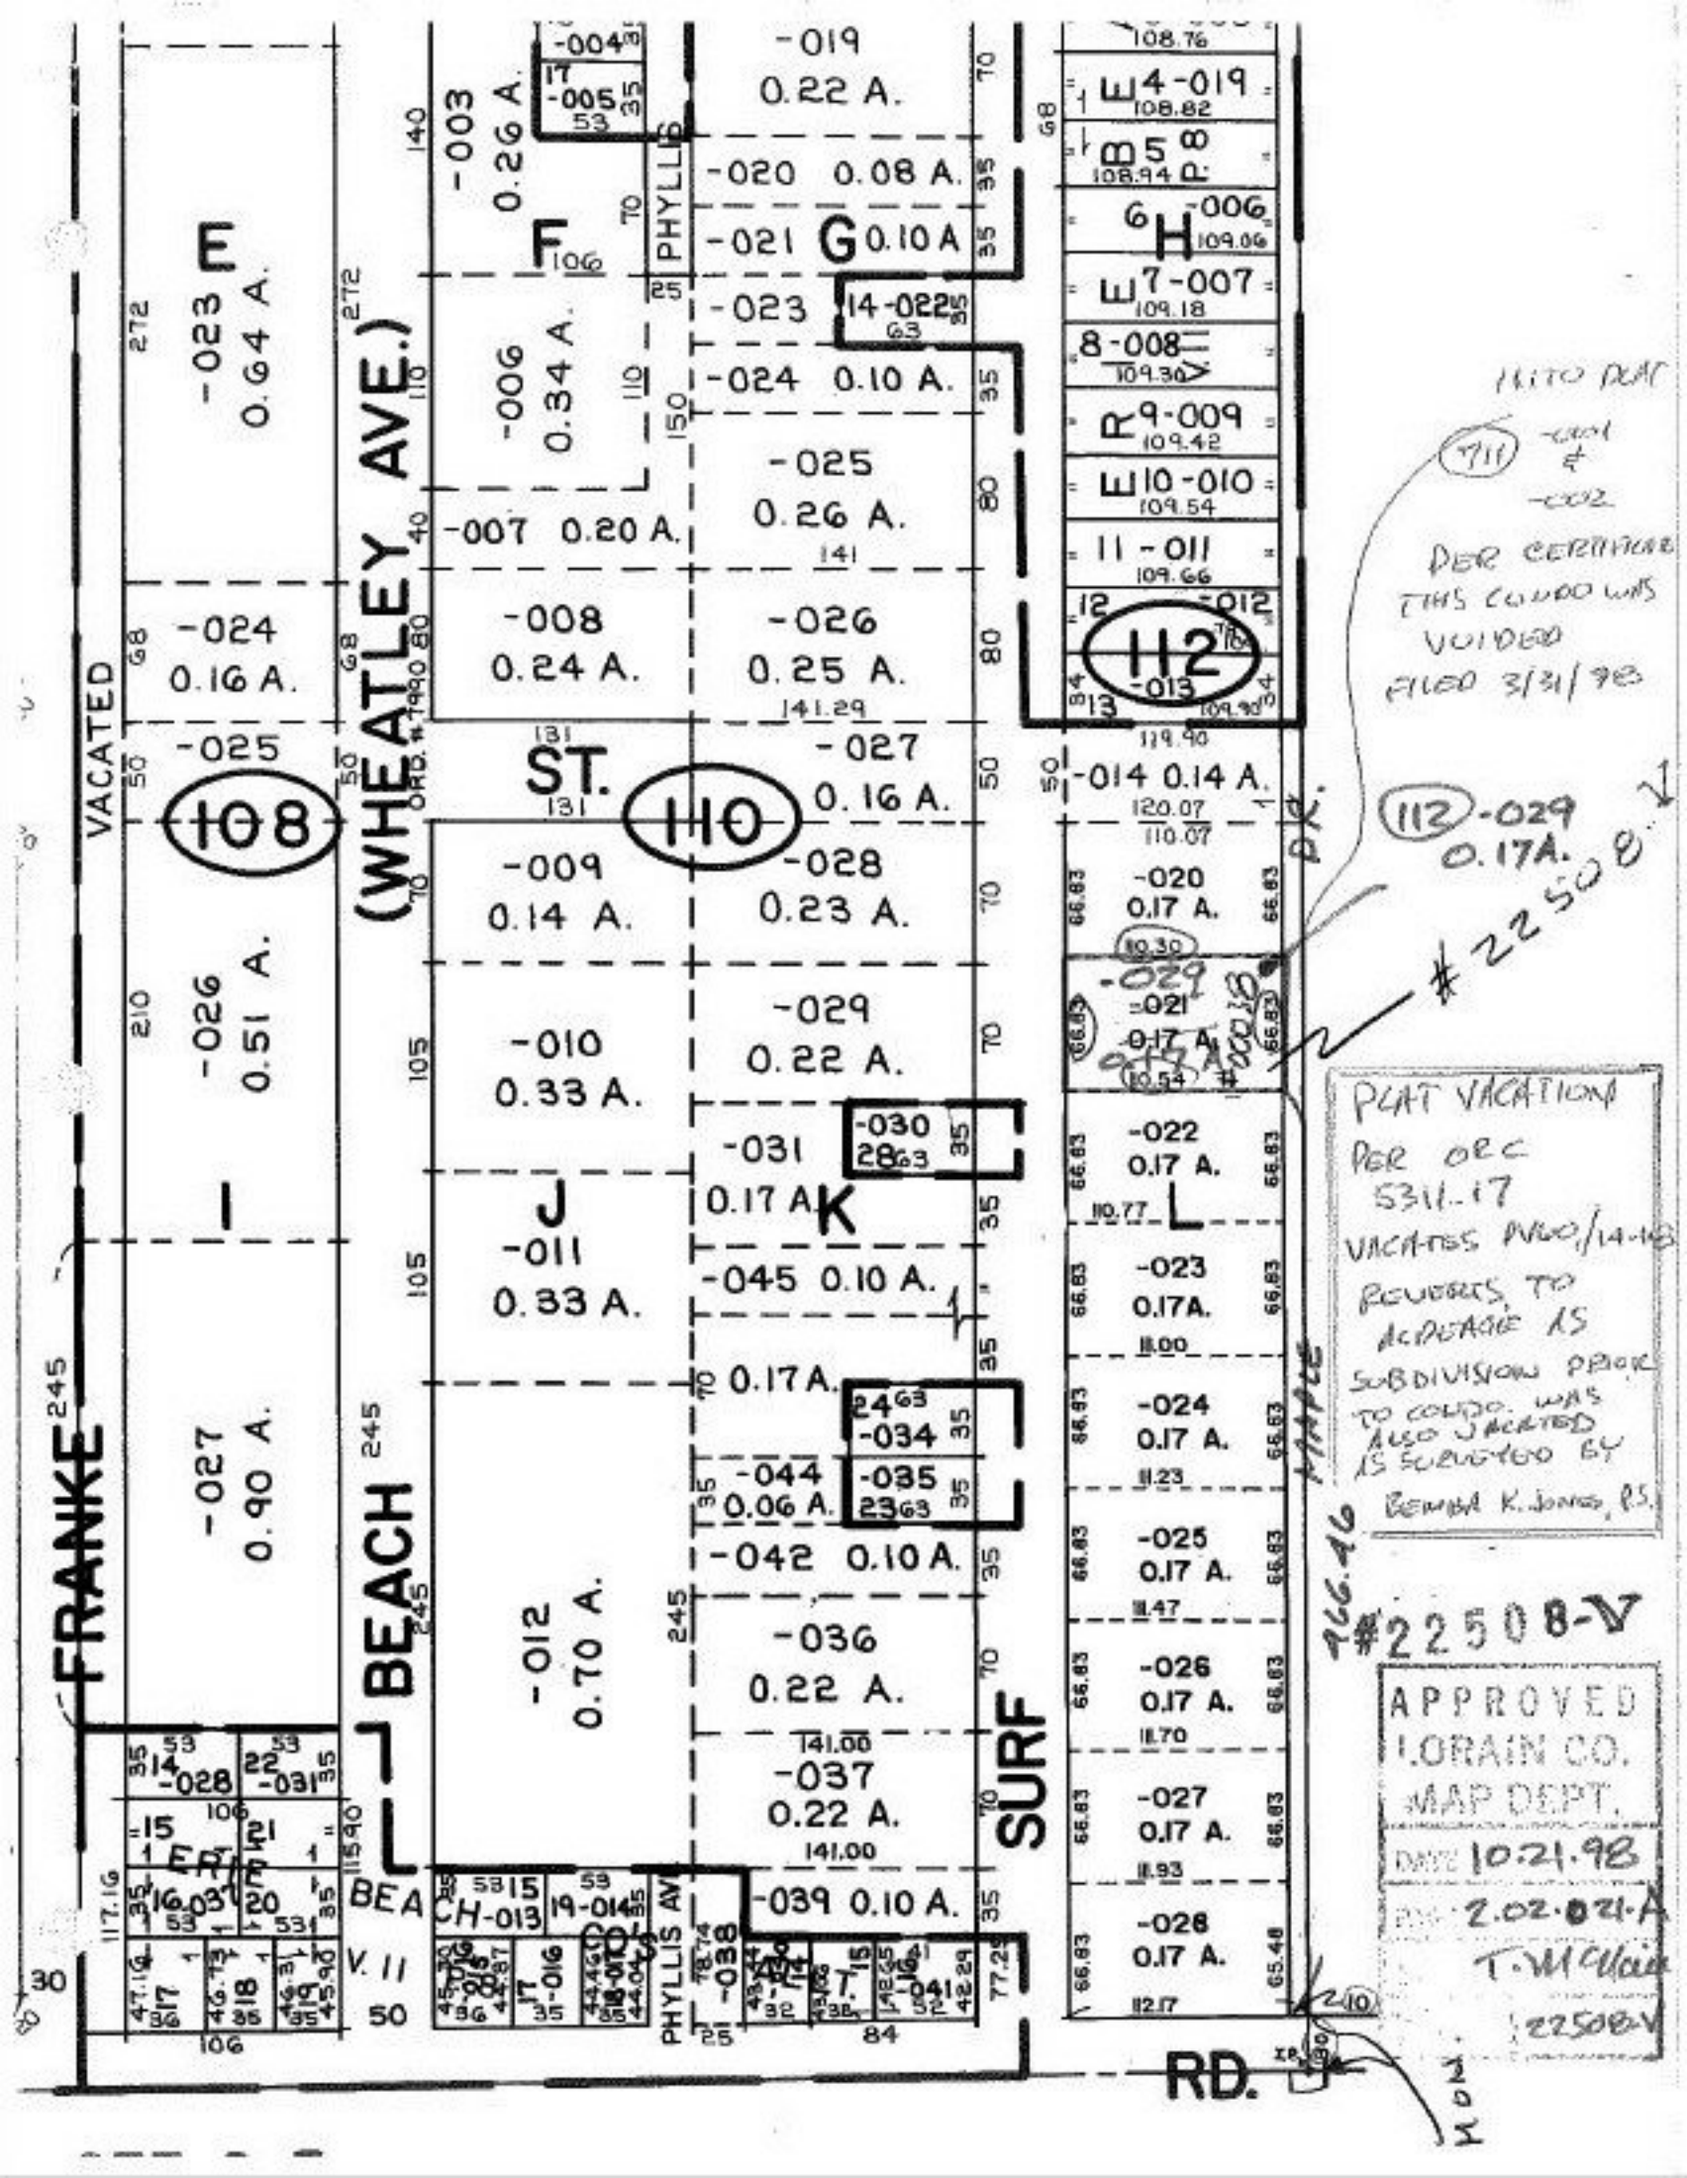
FRANKE
BEACH
SURF
RD.
(WHEATLEY AVE.)
VACATED
ST.
PHYLLIS AVE
MAPLE
108
110
112
-023 E 0.64 A.
-024 0.16 A.
-025
-026 0.51 A.
-027 0.90 A.
-003 0.26 A.
-004
-005
-019 0.22 A.
-020 0.08 A.
-021 G 0.10 A
-022
-006 0.34 A.
-007 0.20 A.
-008 0.24 A.
-009 0.14 A.
-010 0.33 A.
-011 0.33 A.
-012 0.70 A.
-025 0.26 A.
-026 0.25 A.
-027 0.16 A.
-028 0.23 A.
-029 0.22 A.
-030
-031 0.17 A
-045 0.10 A.
-034
-035
-044 0.06 A.
-042 0.10 A.
-036 0.22 A.
-037 0.22 A.
-039 0.10 A.
-038
-041
-013
-014
-015
-016
-017
-018
-028
-031
E 4-019 108.82
B 5 P. 8 108.94
H -006 109.06
E 7-007 109.18
8-008 109.30
R 9-009 109.42
E 10-010 109.54
11-011 109.66
12 -012
13 -013
-014 0.14 A.
-020 0.17 A.
-021 0.17 A.
-022 0.17 A.
-023 0.17A.
-024 0.17 A.
-025 0.17 A.
-026 0.17 A.
-027 0.17 A.
-028 0.17 A.
112-029 0.17A.
#22508
PLAT VACATION
PER ORC 5311.17
VACATES PLAT 14-18
REVERTS TO ACREAGE AS SUBDIVISION PRIOR TO CONDO. WAS ALSO VACATED IS SURVEYED BY
BRENDA K. JONES, P.S.
APPROVED
LORAIN CO.
MAP DEPT.
DATE 10.21.98
2.02.021-A
T. McClain
#22508-V
VOIDED
FILED 3/31/98
DER CERTIFICATE
THIS CONDO WAS
111TO PLAT
711
-001
&
-002