

AIN

67

SEE 4


AVON-CHESTER

3129.34 to E Rd.

2251  
4-00-003-C

SEE R/7-31-86

|                 |
|-----------------|
| APPROVED        |
| LORAIN CO.      |
| MAP DEPT.       |
| DATE 11/15/68   |
| PG# 4-00-004F   |
| BY TRJ. Kelling |

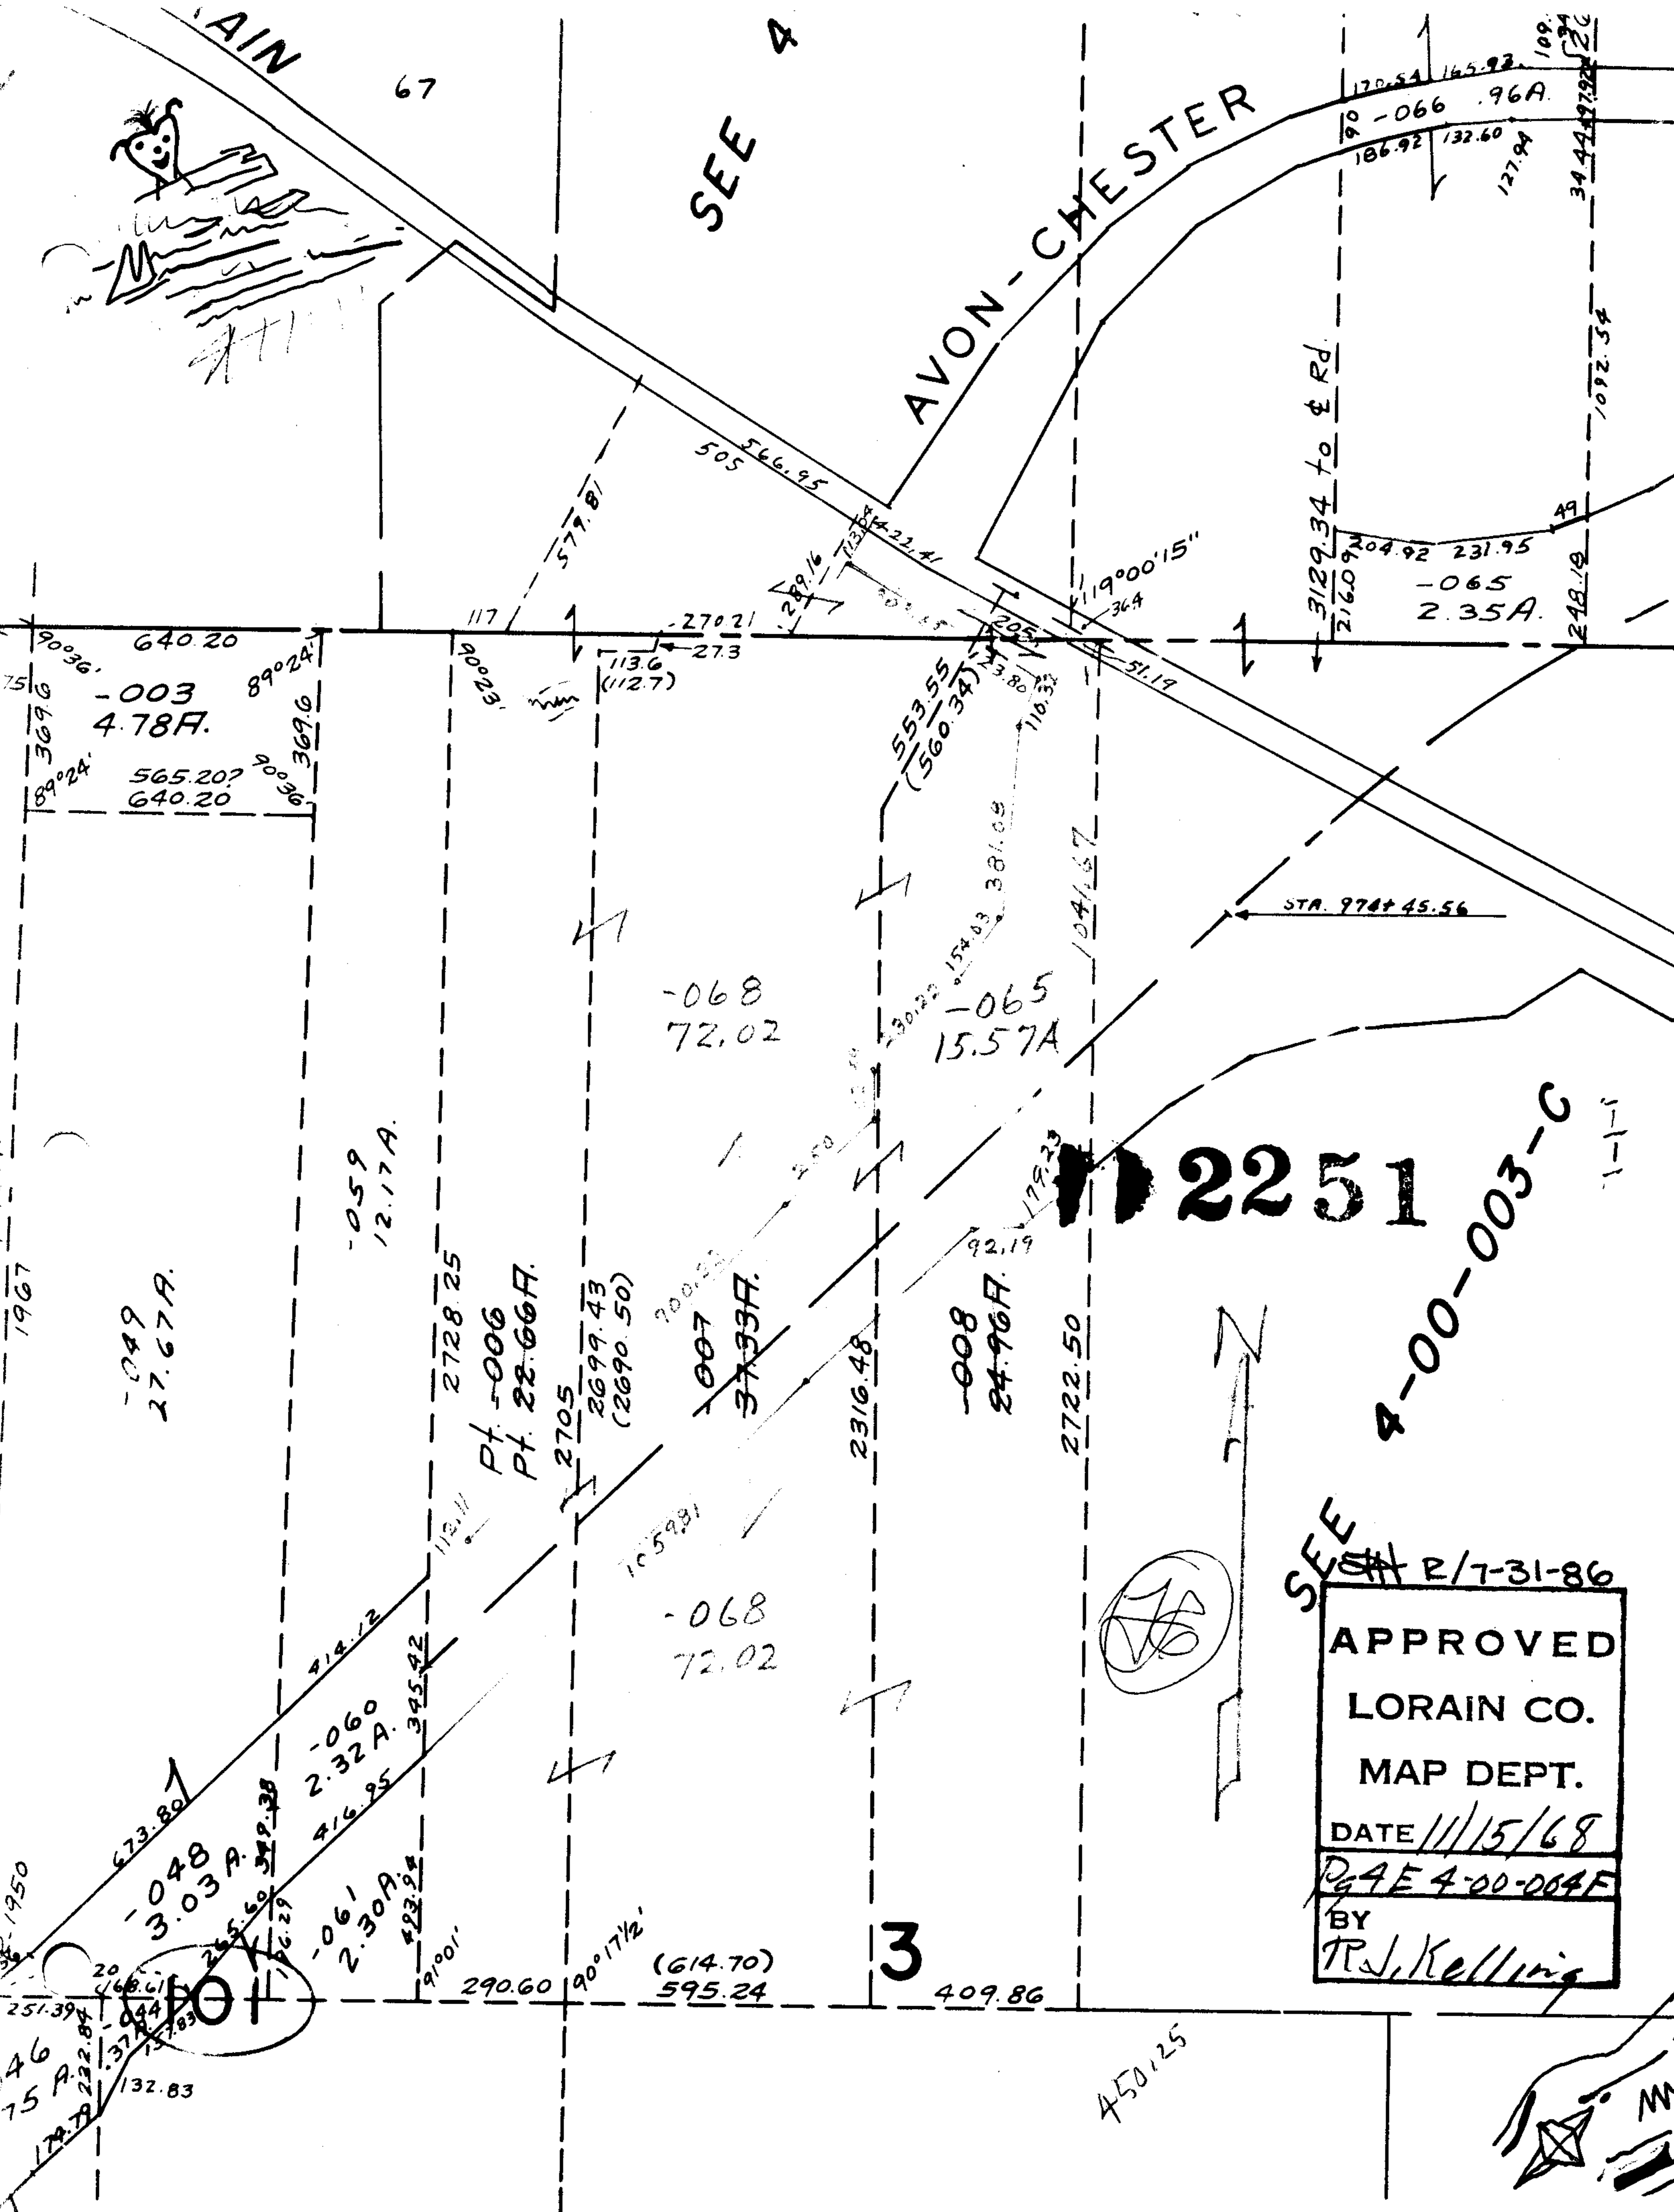

90°36'  
369.6  
-003  
4.78F.  
89°02'4\"/>

-068  
72.02

-065  
15.57A

-049  
27.67A.

-059  
12.17A.

PT. -006  
PT. 22.66F.

2705  
2699.43  
(2690.50)

-007  
37.93F.

-008  
24.96F.

-068  
72.02

-060  
2.32A.

-061  
2.30A.

(614.70)  
595.24

3

409.86

450.25

