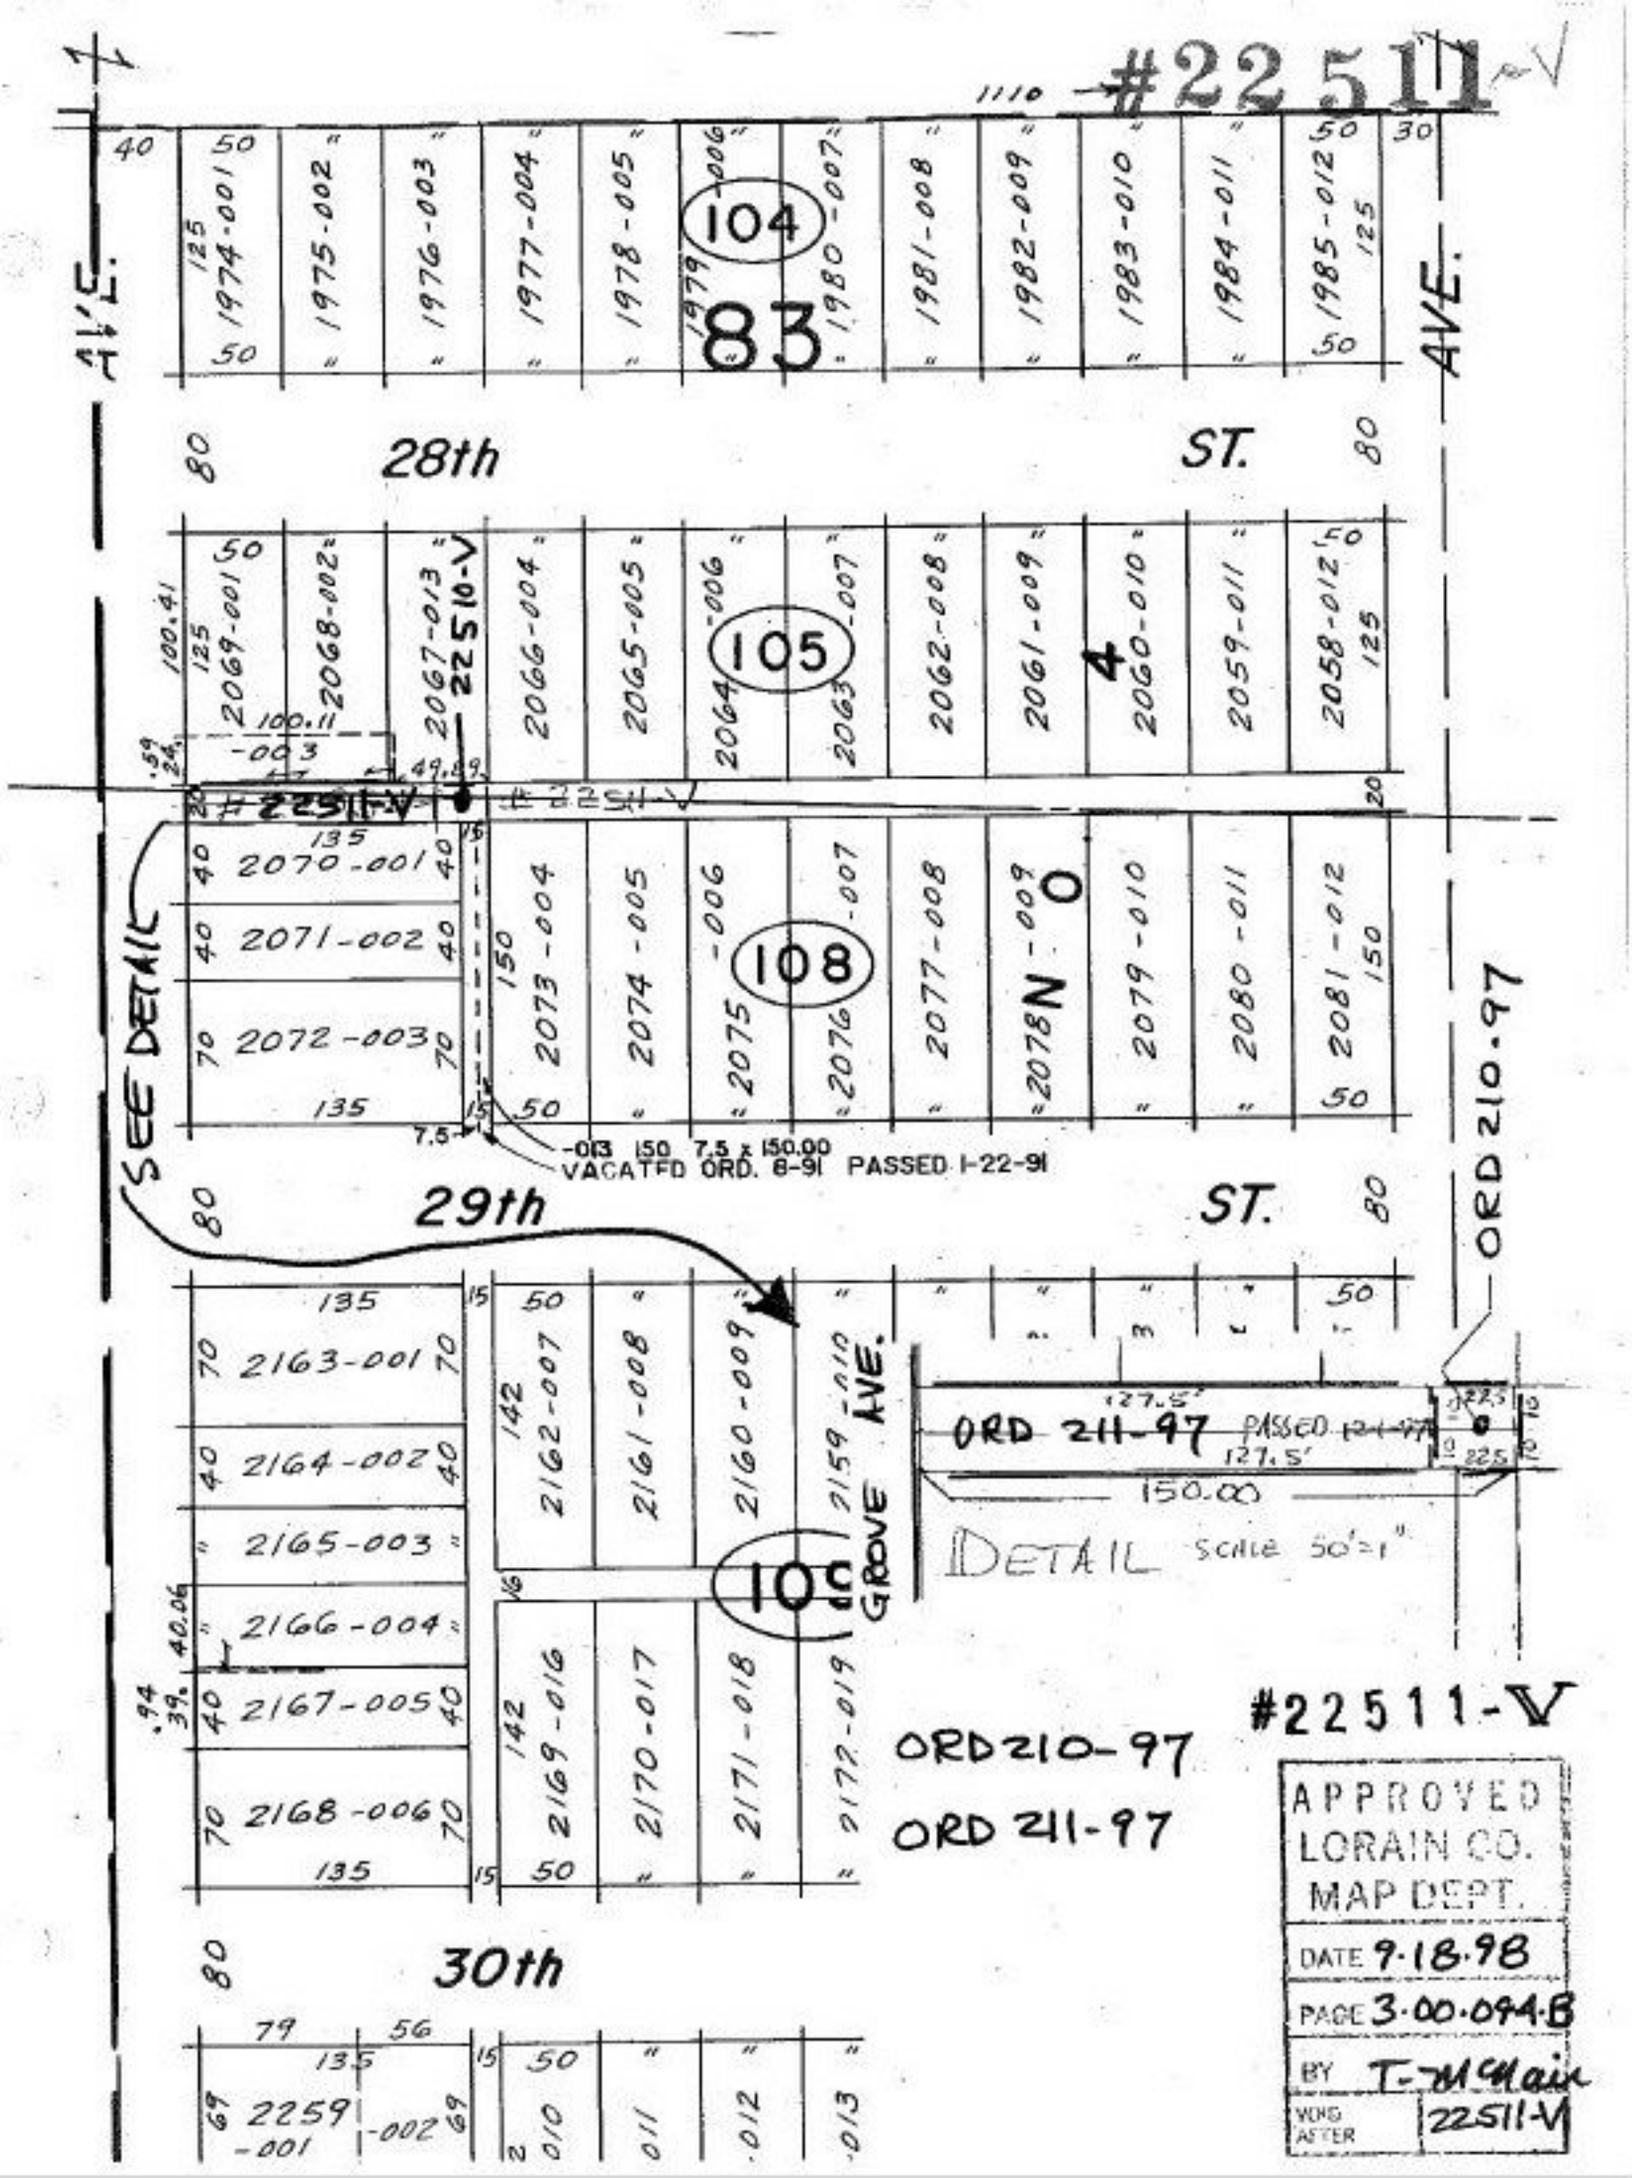
#22511-V
1110
AVE.
28th ST.
29th ST.
30th
104
83
105
108
109
4
N 0
22510-V
#22511-V
SEE DETAIL
-013 150 7.5 x 150.00
VACATED ORD. 8-91 PASSED 1-22-91
ORD 210-97
ORD 211-97 PASSED 12-1-97
127.5'
150.00
DETAIL SCALE 50'=1"
GROVE AVE.
ORD 210-97
ORD 211-97
#22511-V
APPROVED
LORAIN CO.
MAP DEPT.
DATE 9-18-98
PAGE 3-00-094-B
BY T-McMain
VOID AFTER 22511-V