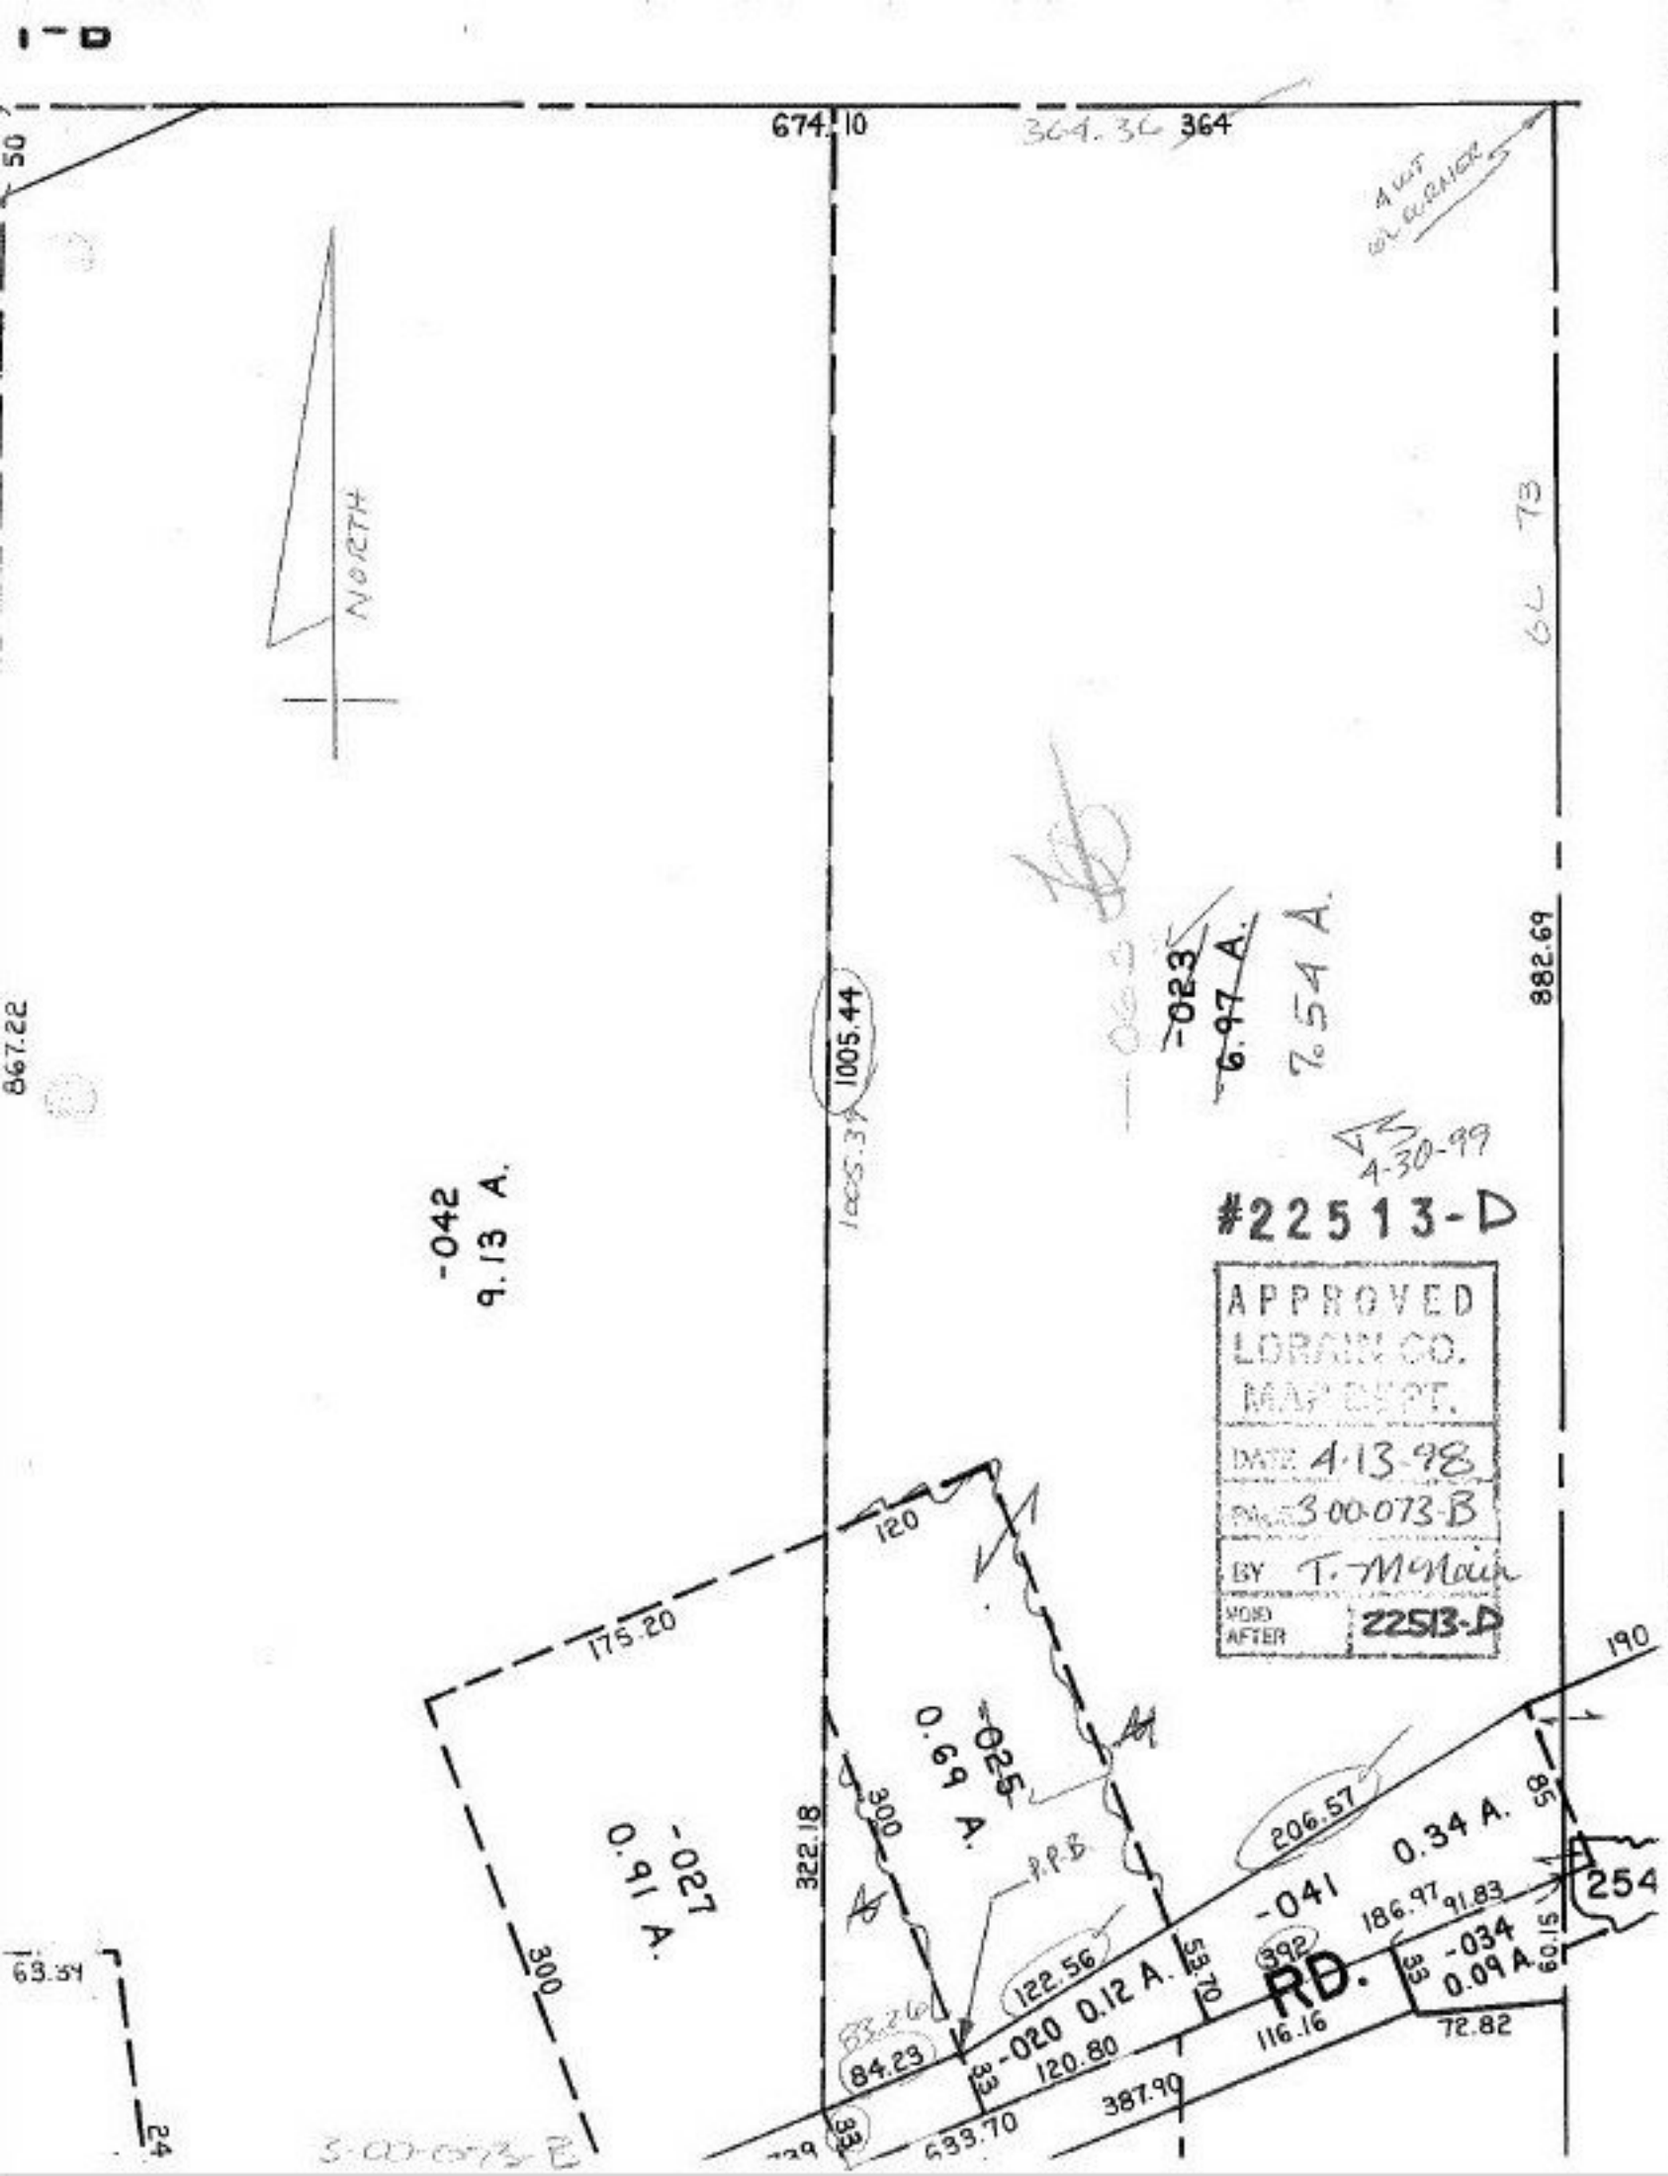

674.10
364.36
364
NORTH
867.22
882.69
1005.44
1005.39
-042
9.13 A.
-023
6.97 A.
7.54 A.
4-30-99
#22513-D
APPROVED
LORAIN CO.
MAP DEPT.
DATE 4-13-98
PAGE 3-00-073-B
BY T. McNair
VOID AFTER 22513-D
120
175.20
-025
0.69 A.
-027
0.91 A.
322.18
300
P.P.B.
206.57
-041
0.34 A.
186.97
91.83
254
RD.
-034
0.09 A.
60.15
72.82
122.56
-020 0.12 A.
120.80
53.70
392
116.16
387.90
84.23
633.70
63.34
3-00-073-B
190
85