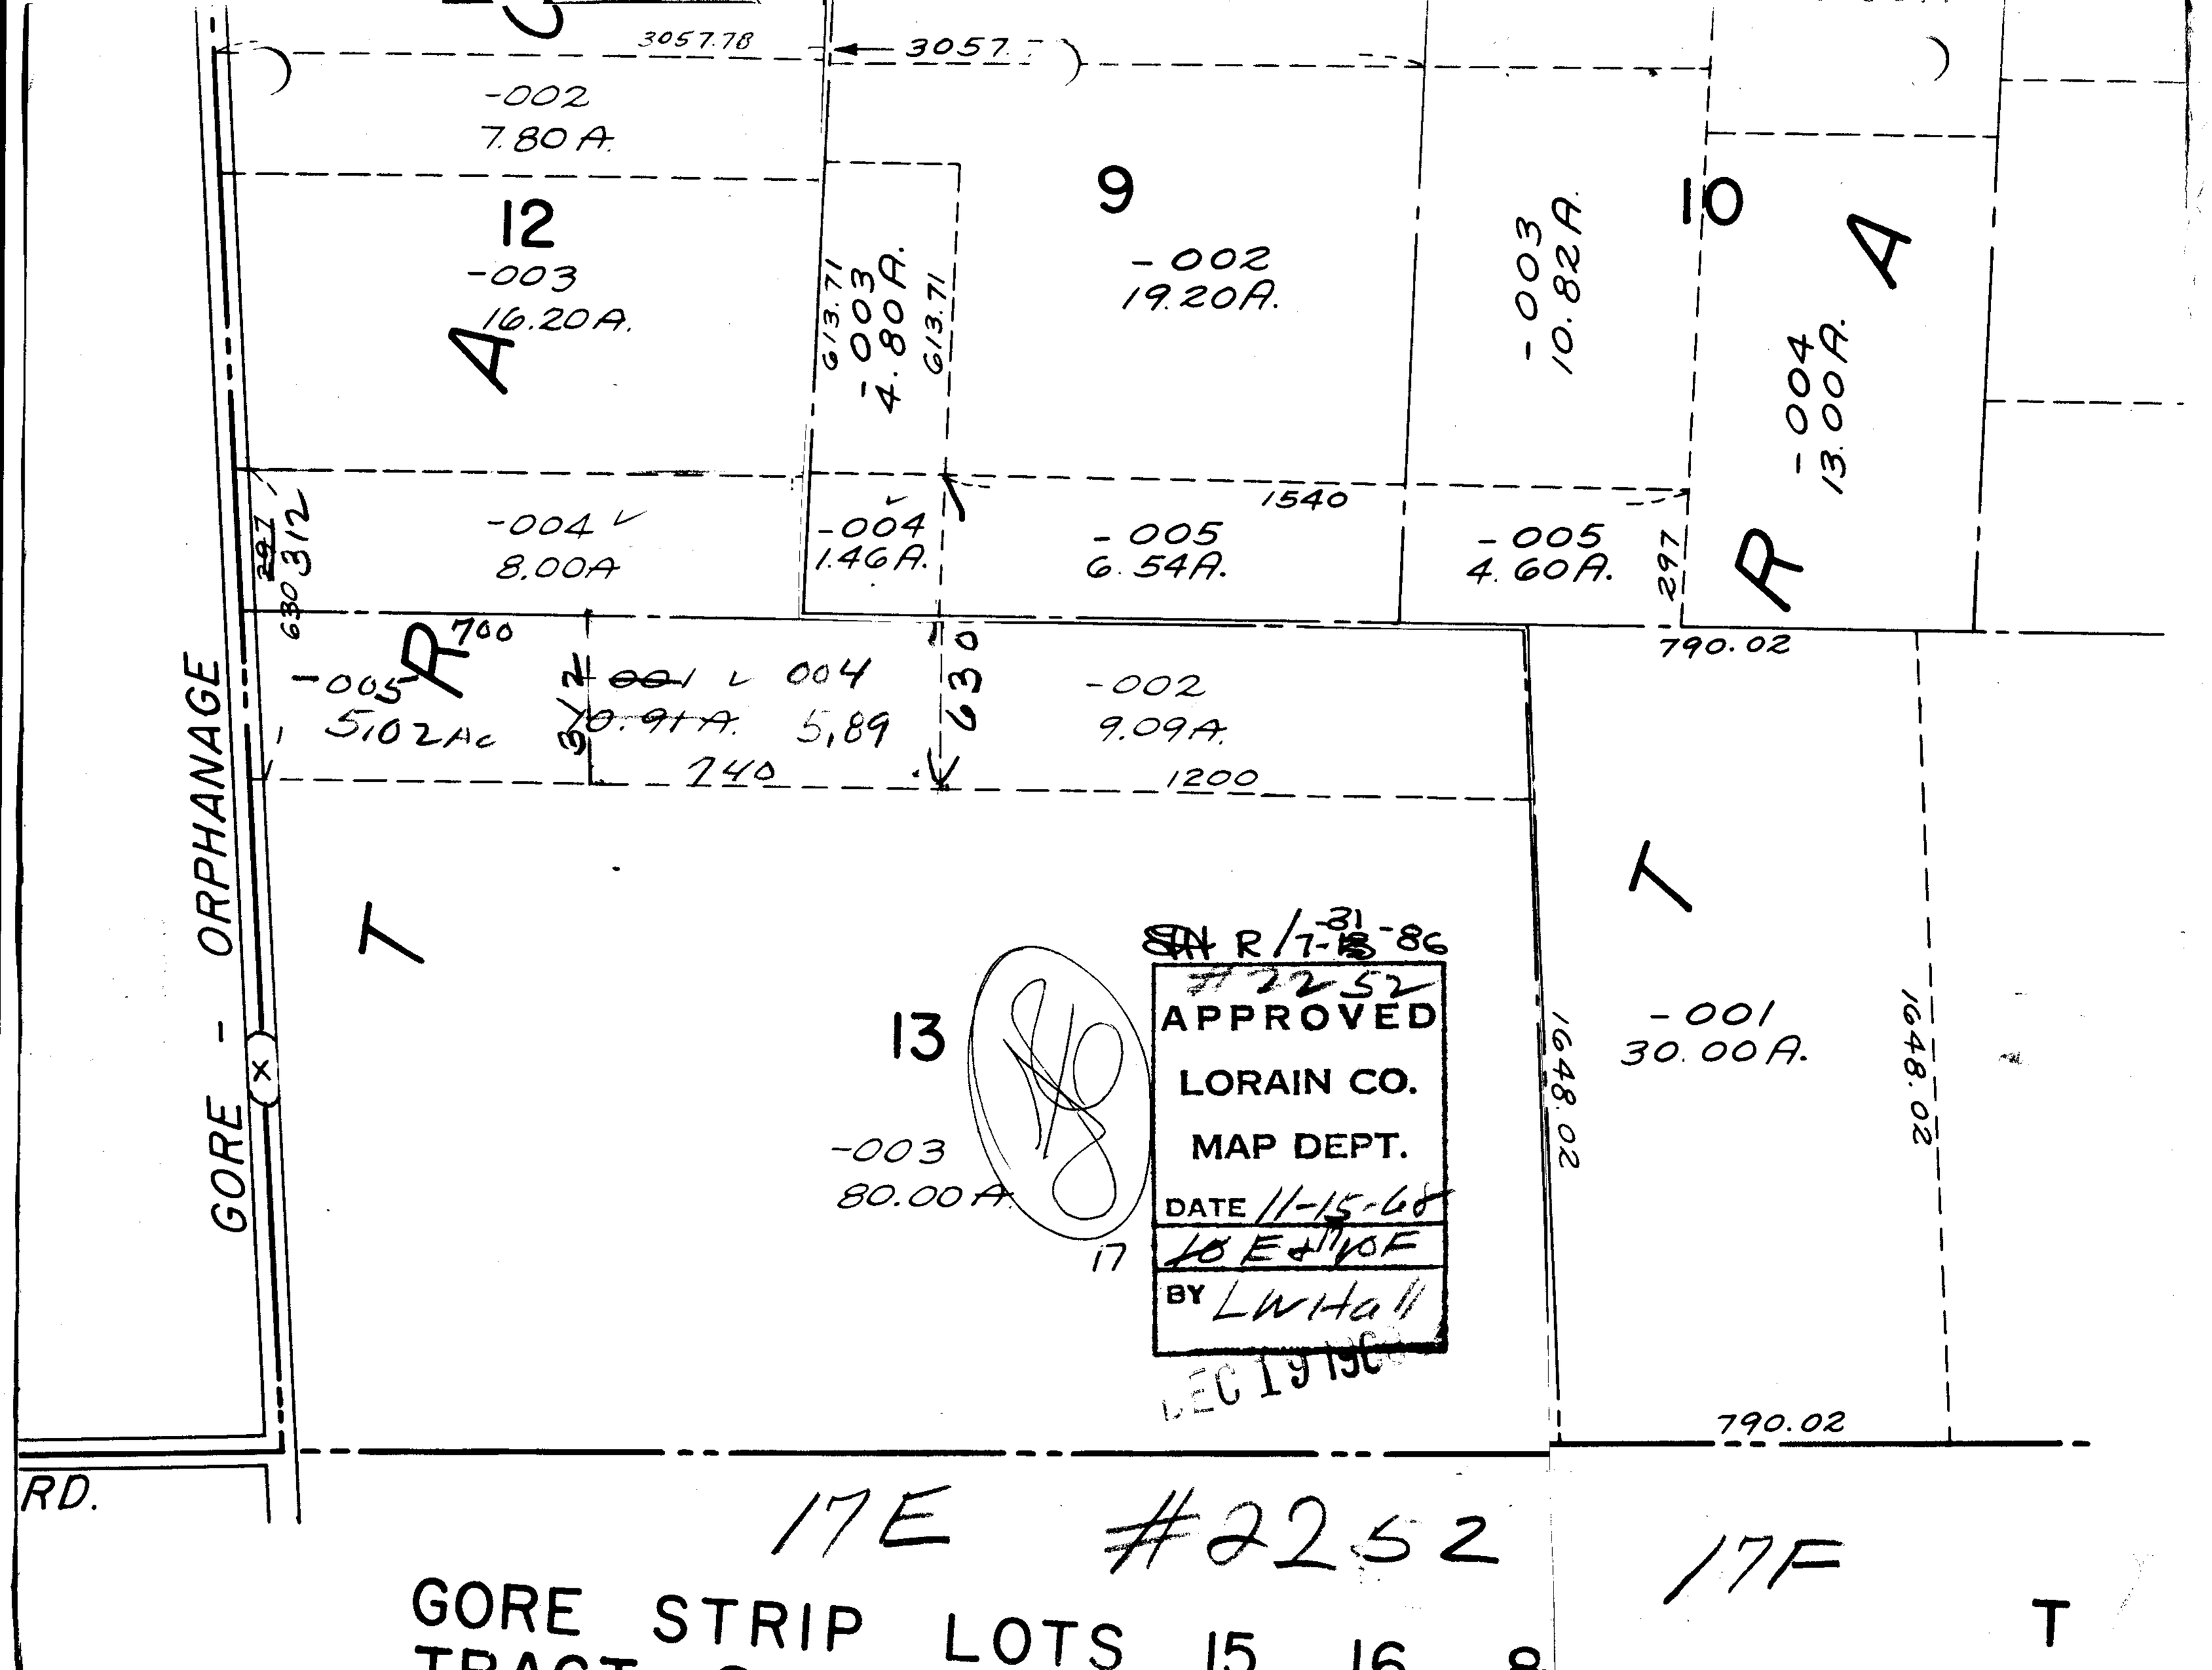

3057.78
3057.
-002
7.80 A.
12
-003
16.20 A.
A
613.71
-003
4.80 A.
613.71
9
-002
19.20 A.
-003
10.82 A.
10
A
-004
13.00 A.
R
1540
-004
8.00 A
-004
1.46 A.
-005
6.54 A.
-005
4.60 A.
297
312
630
700
R
-005
5.02 Ac
312
~~-001~~
~~0.91 A.~~
004
5.89
630
740
-002
9.09 A.
1200
790.02
GORE - ORPHANAGE
T
T
13
-003
80.00 A.
17
R/7-31-86
#2252
APPROVED
LORAIN CO.
MAP DEPT.
DATE 11-15-68
10E & 10F
BY LWHall
DEC 19 1968
1648.02
-001
30.00 A.
1648.02
790.02
RD.
17E
#2252
17F
T
GORE STRIP LOTS 15 16 8