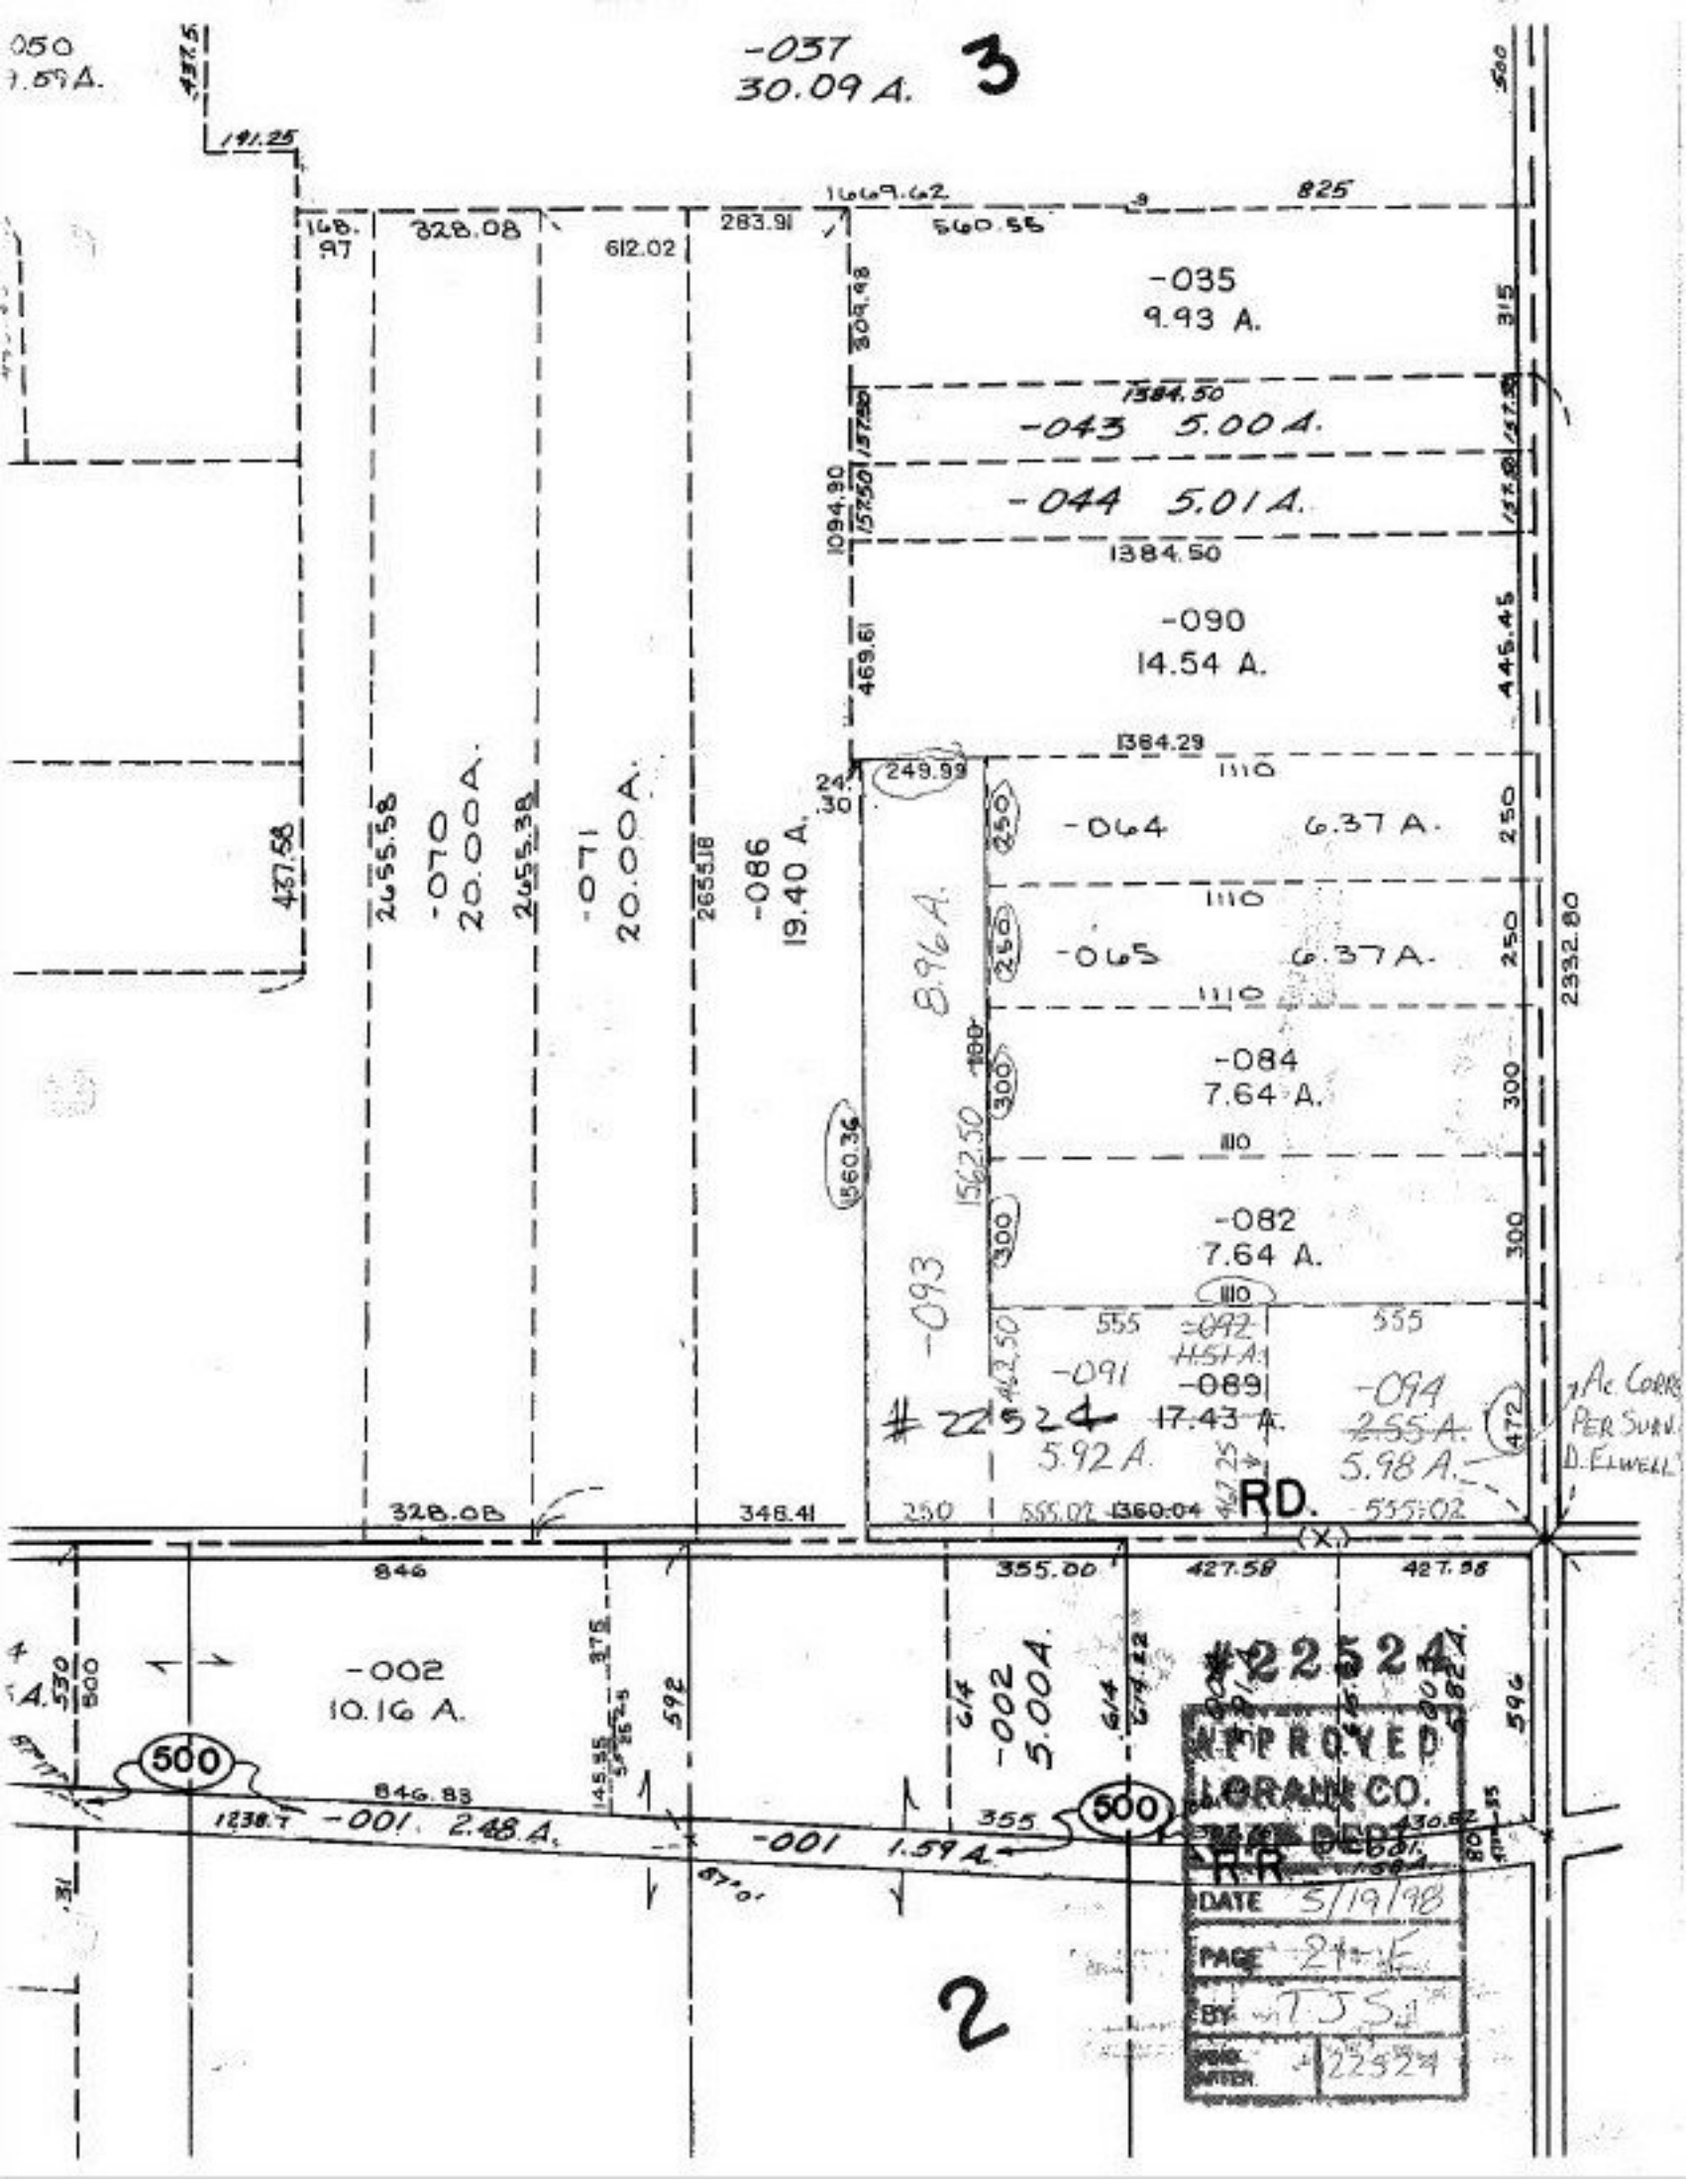
050
1.59 A.
-037
30.09 A.
3
191.25
1669.62
825
168.97
328.08
612.02
283.91
560.55
-035
9.93 A.
309.98
315
1384.50
-043 5.00 A.
-044 5.01 A.
1094.90
1384.50
-090
14.54 A.
469.61
445.45
1384.29
249.99
-064 6.37 A.
-065 6.37 A.
-084
7.64 A.
-082
7.64 A.
2332.80
437.58
2655.58
-070
20.00 A.
2655.38
-071
20.00 A.
2655.18
-086
19.40 A.
8.96 A.
-093
1562.50
560.36
-091
5.92 A.
-089
17.43 A.
-094
2.55 A.
5.98 A.
#22524
1 Ac. Corr.
PER SURV.
D. ELWELL
328.08
346.41
555.07
560.04
555.02
RD.
846
355.00
427.58
427.58
-002
10.16 A.
-002
5.00 A.
500
846.83
1238.7
-001 2.48 A.
-001 1.59 A.
355
430.62
APPROVED
L.CRAIN CO.
DATE 5/19/98
PAGE 21-E
BY TJS
#22524
2