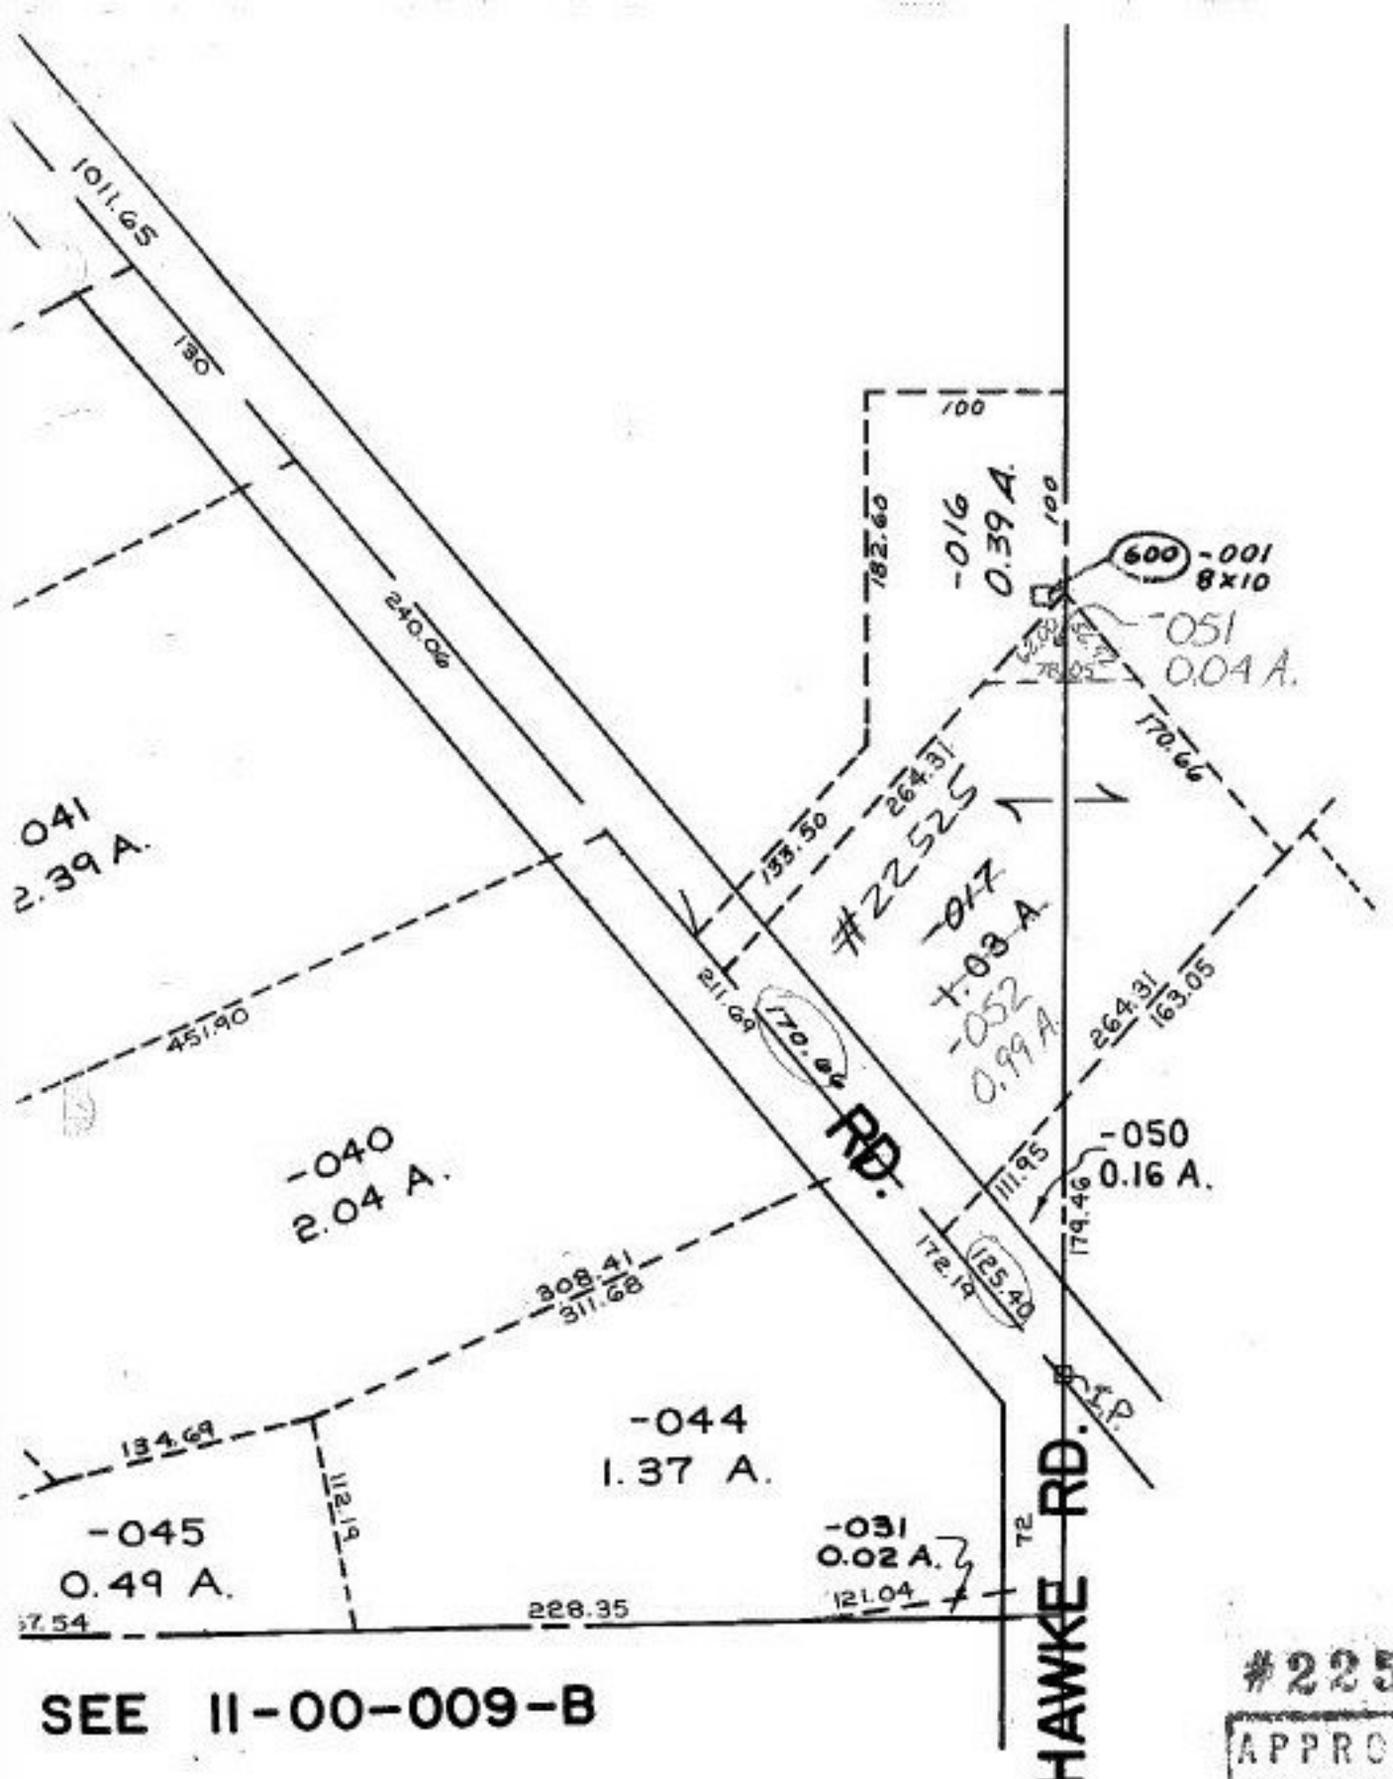

SEE 11-00-009-B

#22525

APPROVED
LORAIN CO.
MAP DEPT.

DATE 5/19/98

PAGE 11-00-010-B

BY TJS

22525