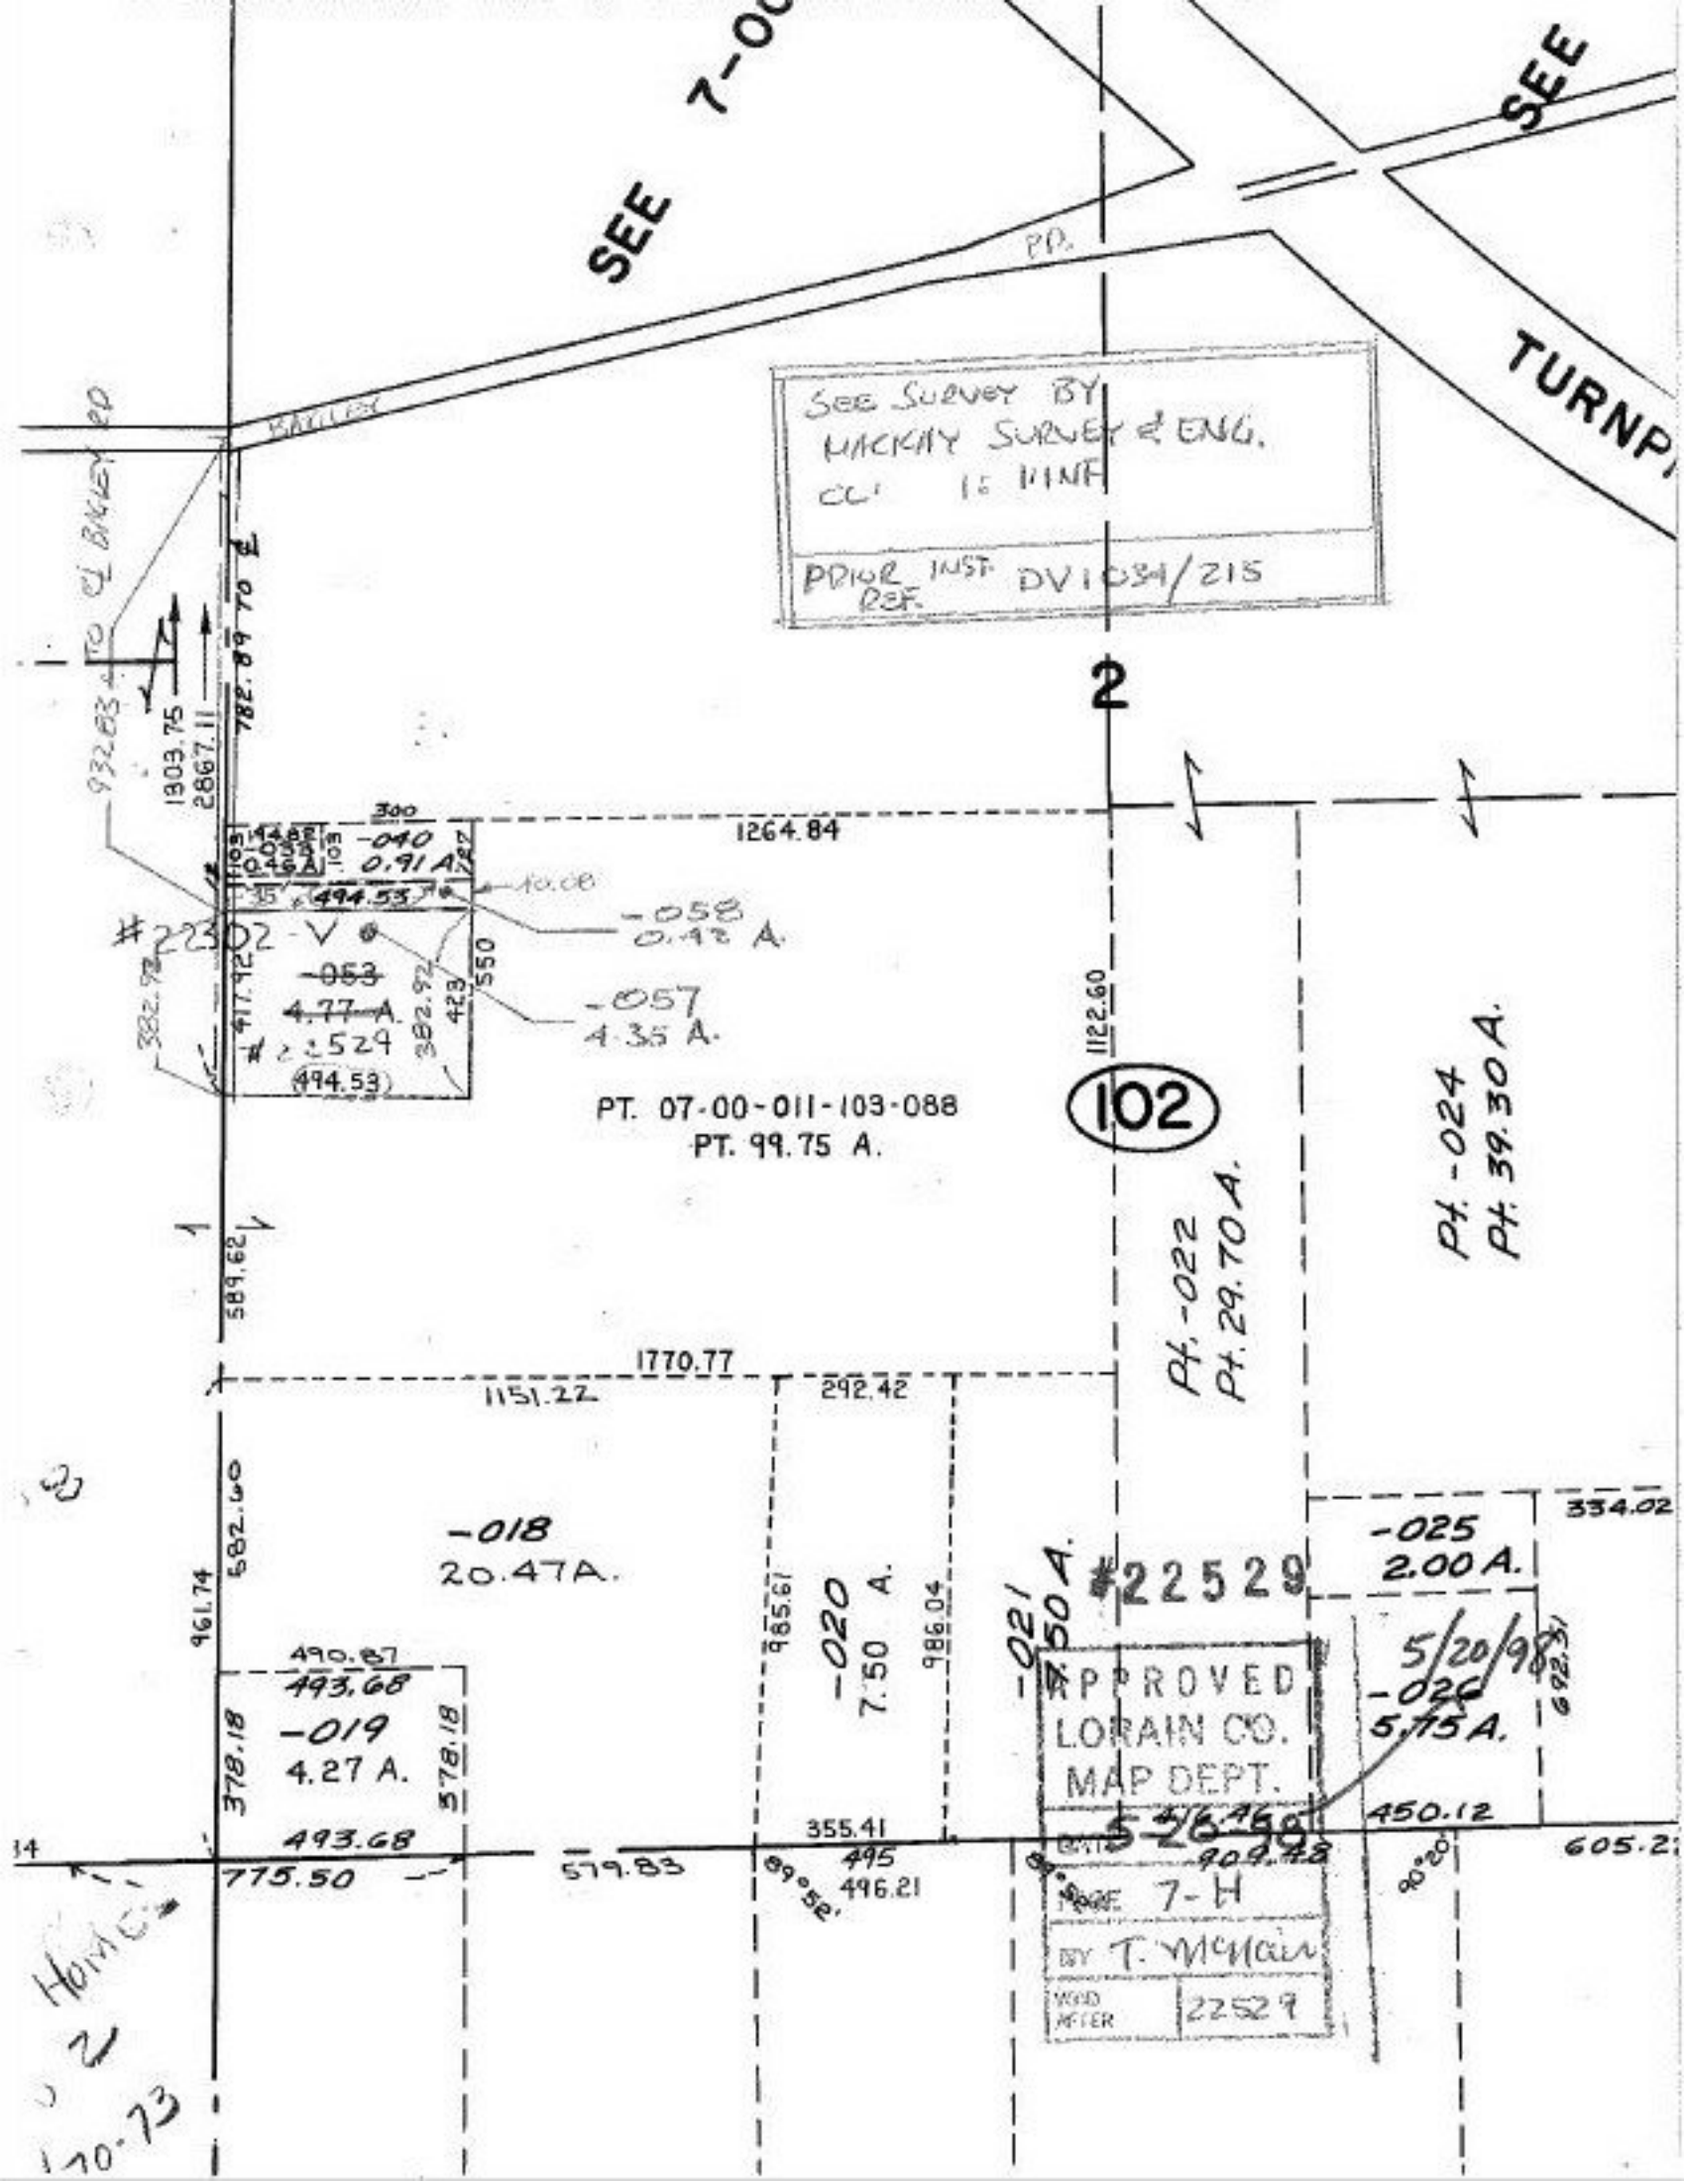
SEE 7-00
SEE
TURNP
PD.
BAGLEY
SEE SURVEY BY
MACKAY SURVEY & ENG.
PRIOR INST. REF. DV1034/215
2
1264.84
-040
0.91 A.
494.53
-058
0.42 A.
#22302-V
-053
4.77 A.
#22529
494.53
-057
4.35 A.
1122.60
PT. 07-00-011-103-088
PT. 99.75 A.
102
Pt. -022
Pt. 29.70 A.
Pt. -024
Pt. 39.30 A.
589.62
1770.77
1151.22
292.42
-018
20.47A.
-020
7.50 A.
-021
7.50 A.
#22529
-025
2.00 A.
334.02
-026
5.75 A.
5/20/98
APPROVED
LORAIN CO.
MAP DEPT.
5-26-98
PAGE 7-H
BY T. McNair
VOID AFTER 22529
490.87
493.68
-019
4.27 A.
493.68
775.50
579.83
355.41
495
496.21
450.12
605.2
Home
2
70-73