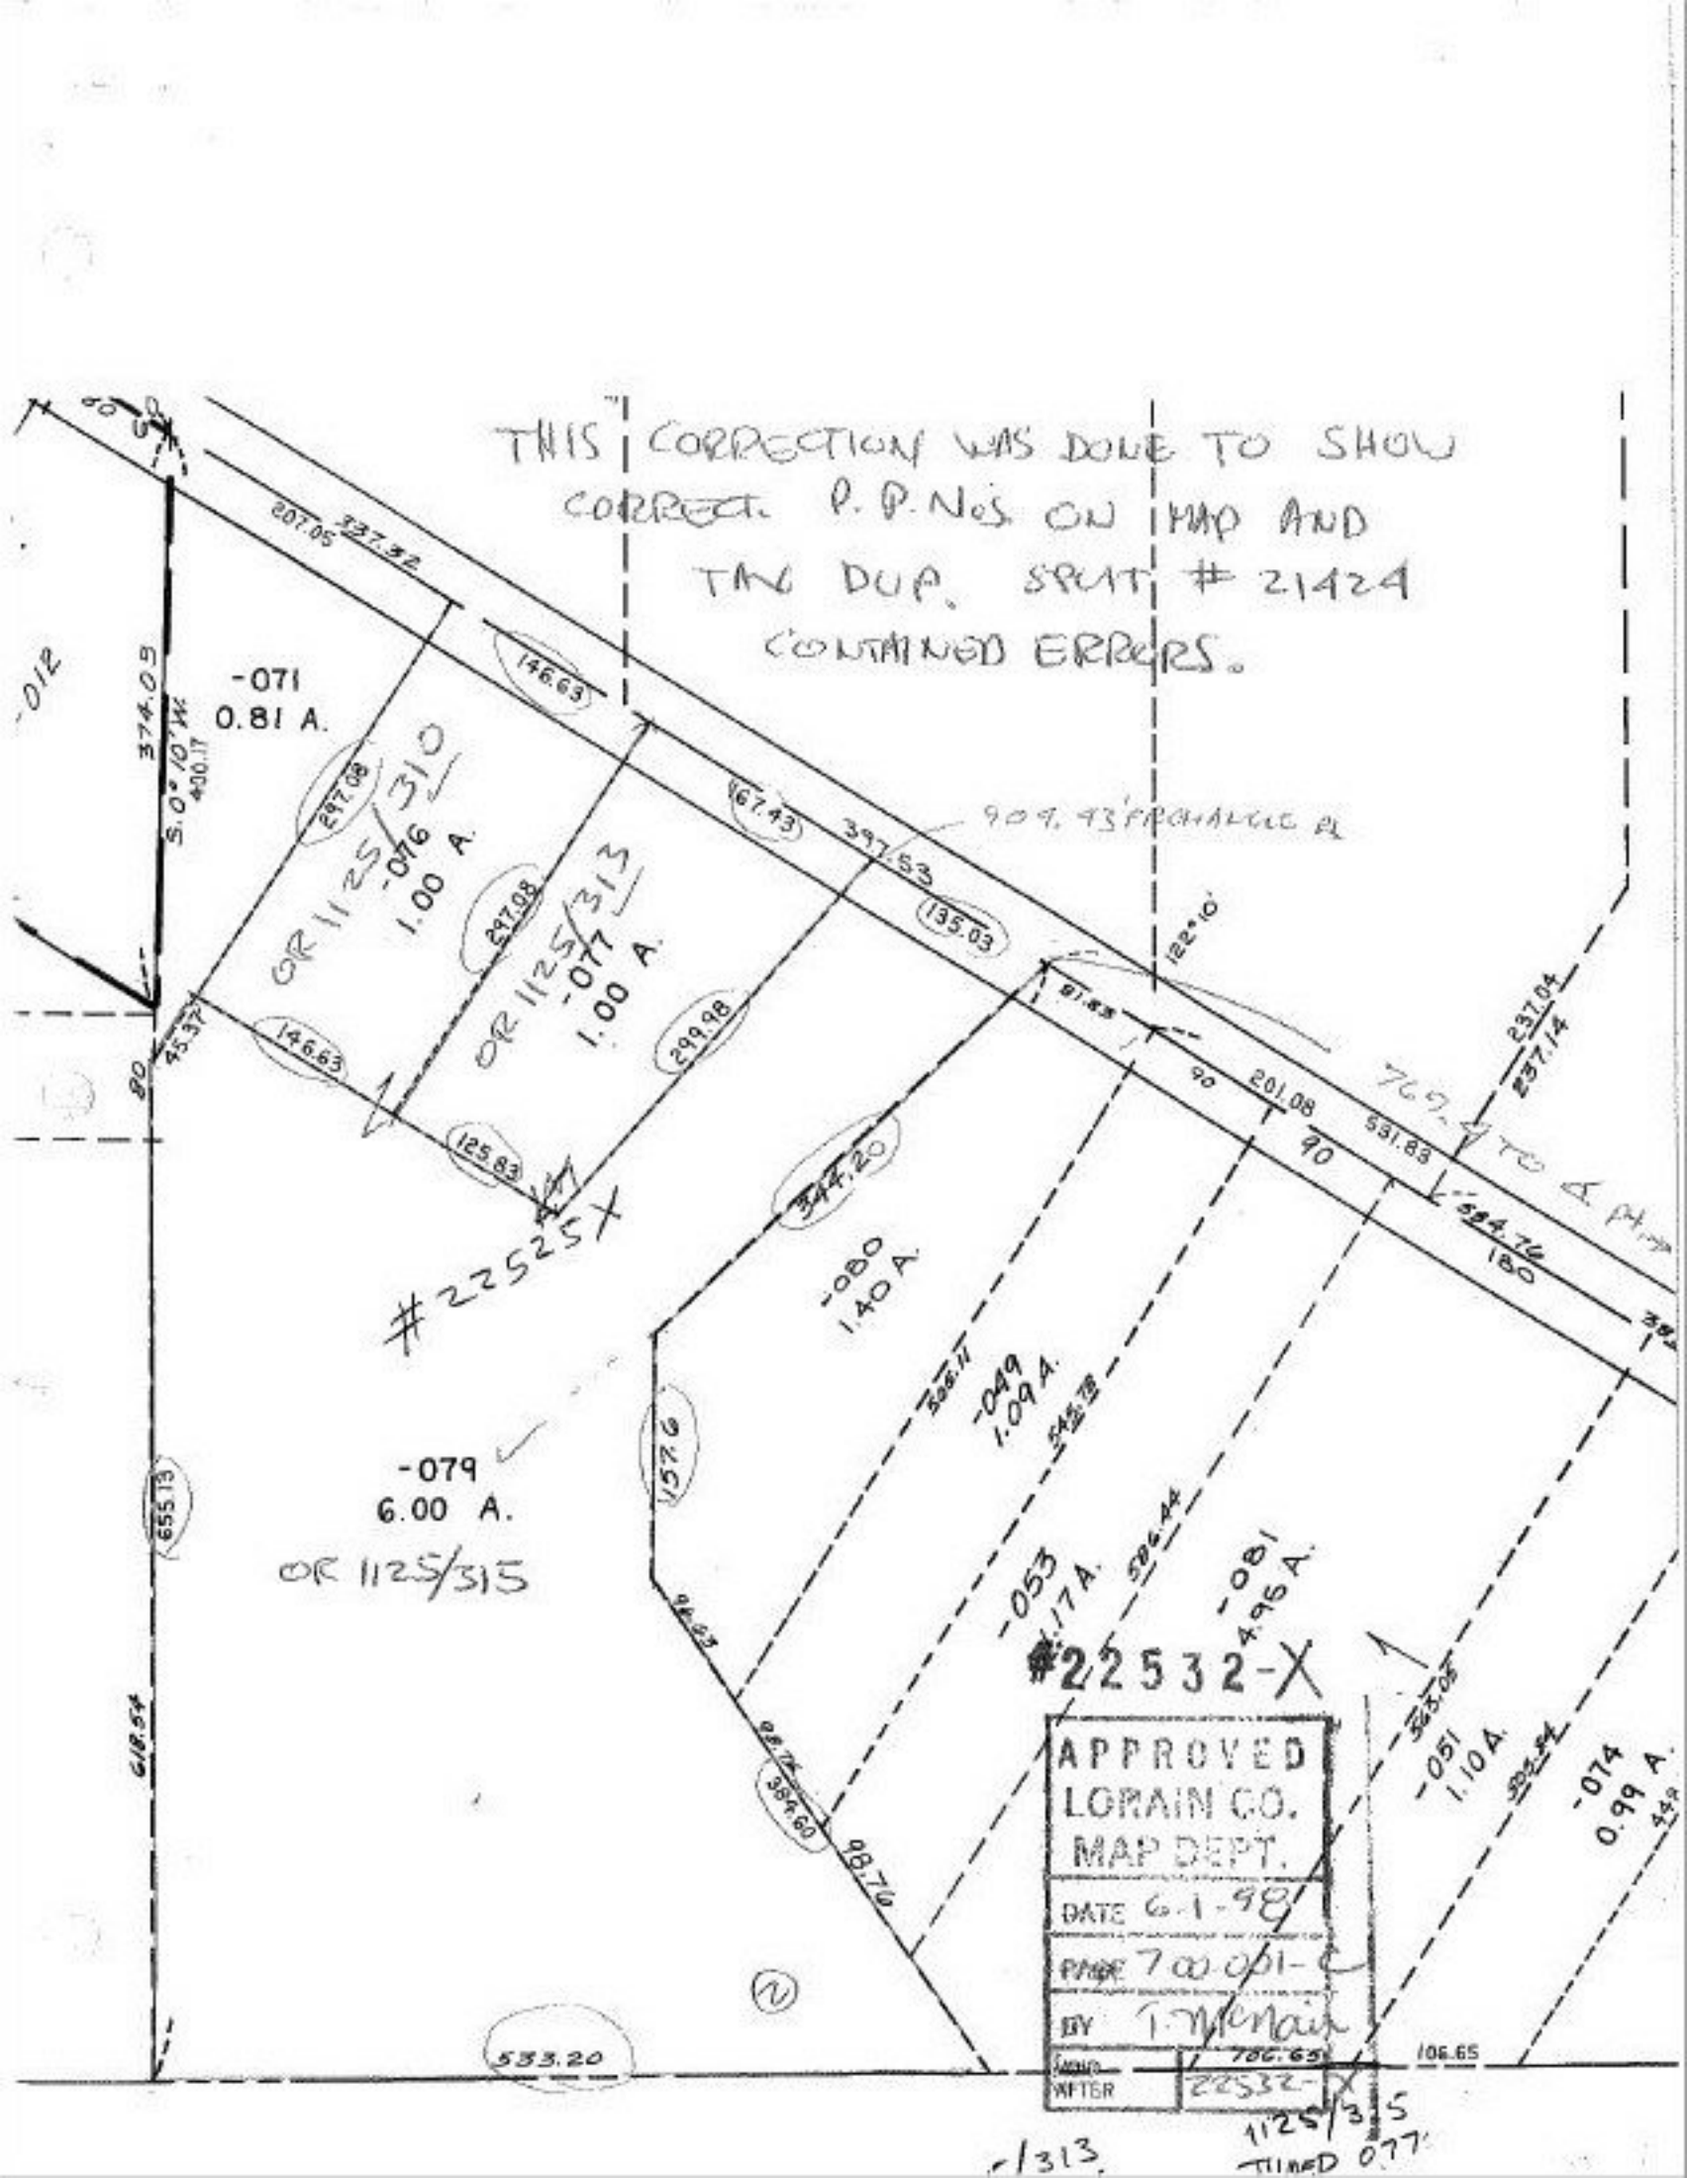
THIS CORRECTION WAS DONE TO SHOW CORRECT P.P.Nos. ON MAP AND TAX DUP. SPLIT # 21424 CONTAINED ERRORS.
-071
0.81 A.
OR 1125/310
-076
1.00 A.
OR 1125/313
-077
1.00 A.
-080
1.40 A.
-049
1.09 A.
-079
6.00 A.
OR 1125/315
#22525X
#22532-X
-053
1.17 A.
-081
4.96 A.
-051
1.10 A.
-074
0.99 A.
APPROVED
LORAIN CO.
MAP DEPT.
DATE 6-1-98
BY T. McNair
WATER 22532-
1125/315
TIMED 077
-1313.