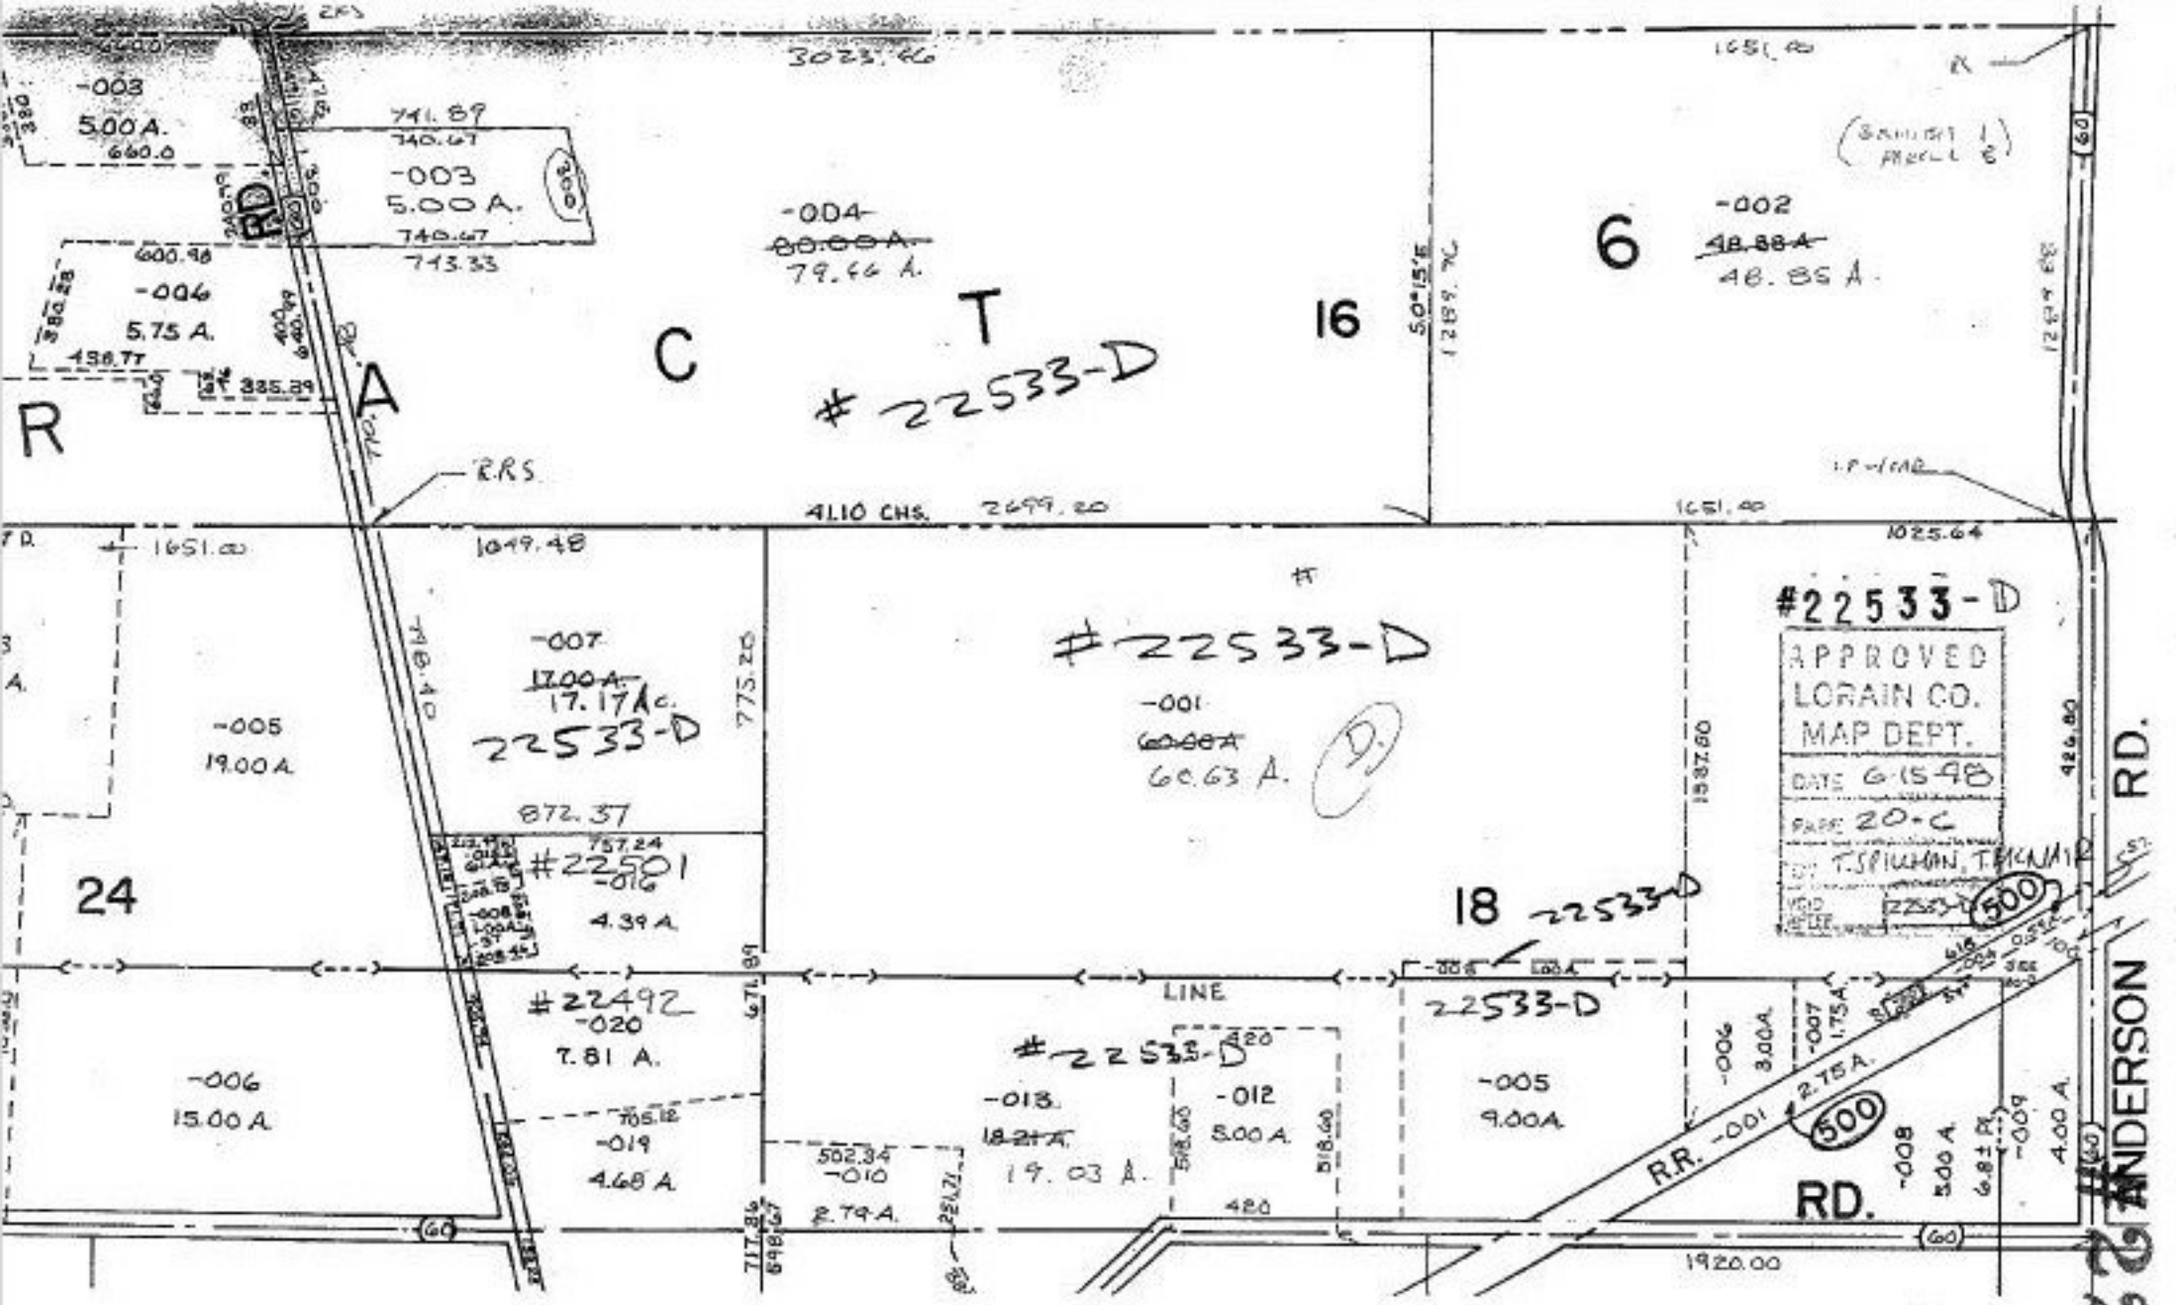

-003
5.00 A.
660.0
741.89
740.67
-003
5.00 A.
740.67
743.33
600.98
-006
5.75 A.
438.77
335.29
R
A
C
T
16
6
-004
~~80.00 A.~~
79.66 A.
-002
~~48.88 A~~
48.85 A.
#22533-D
3023.46
1651.00
R.R.S.
41.10 CHS.
2699.20
1651.00
1049.48
1025.64
-007
~~17.00 A.~~
17.17 Ac.
22533-D
775.20
-005
19.00 A.
872.37
#22533-D
-001
~~60.00 A~~
60.63 A.
#22533-D
APPROVED
LORAIN CO.
MAP DEPT.
DATE 6-15-98
PAGE 20-C
BY T. SPILLMAN, T. McNAIR
24
#22501
-016
4.39 A.
18
22533-D
LINE
#22492
-020
7.81 A.
-006
15.00 A.
-019
4.68 A.
#22533-D
-013
~~18.21 A.~~
19.03 A.
-012
5.00 A.
22533-D
-005
9.00 A.
-006
3.00 A.
-007
1.75 A.
2.75 A.
R.R.
-001
500
-008
5.00 A.
-009
4.00 A.
RD.
ANDERSON RD.
1920.00

#22533