SEE 5-00-003-B

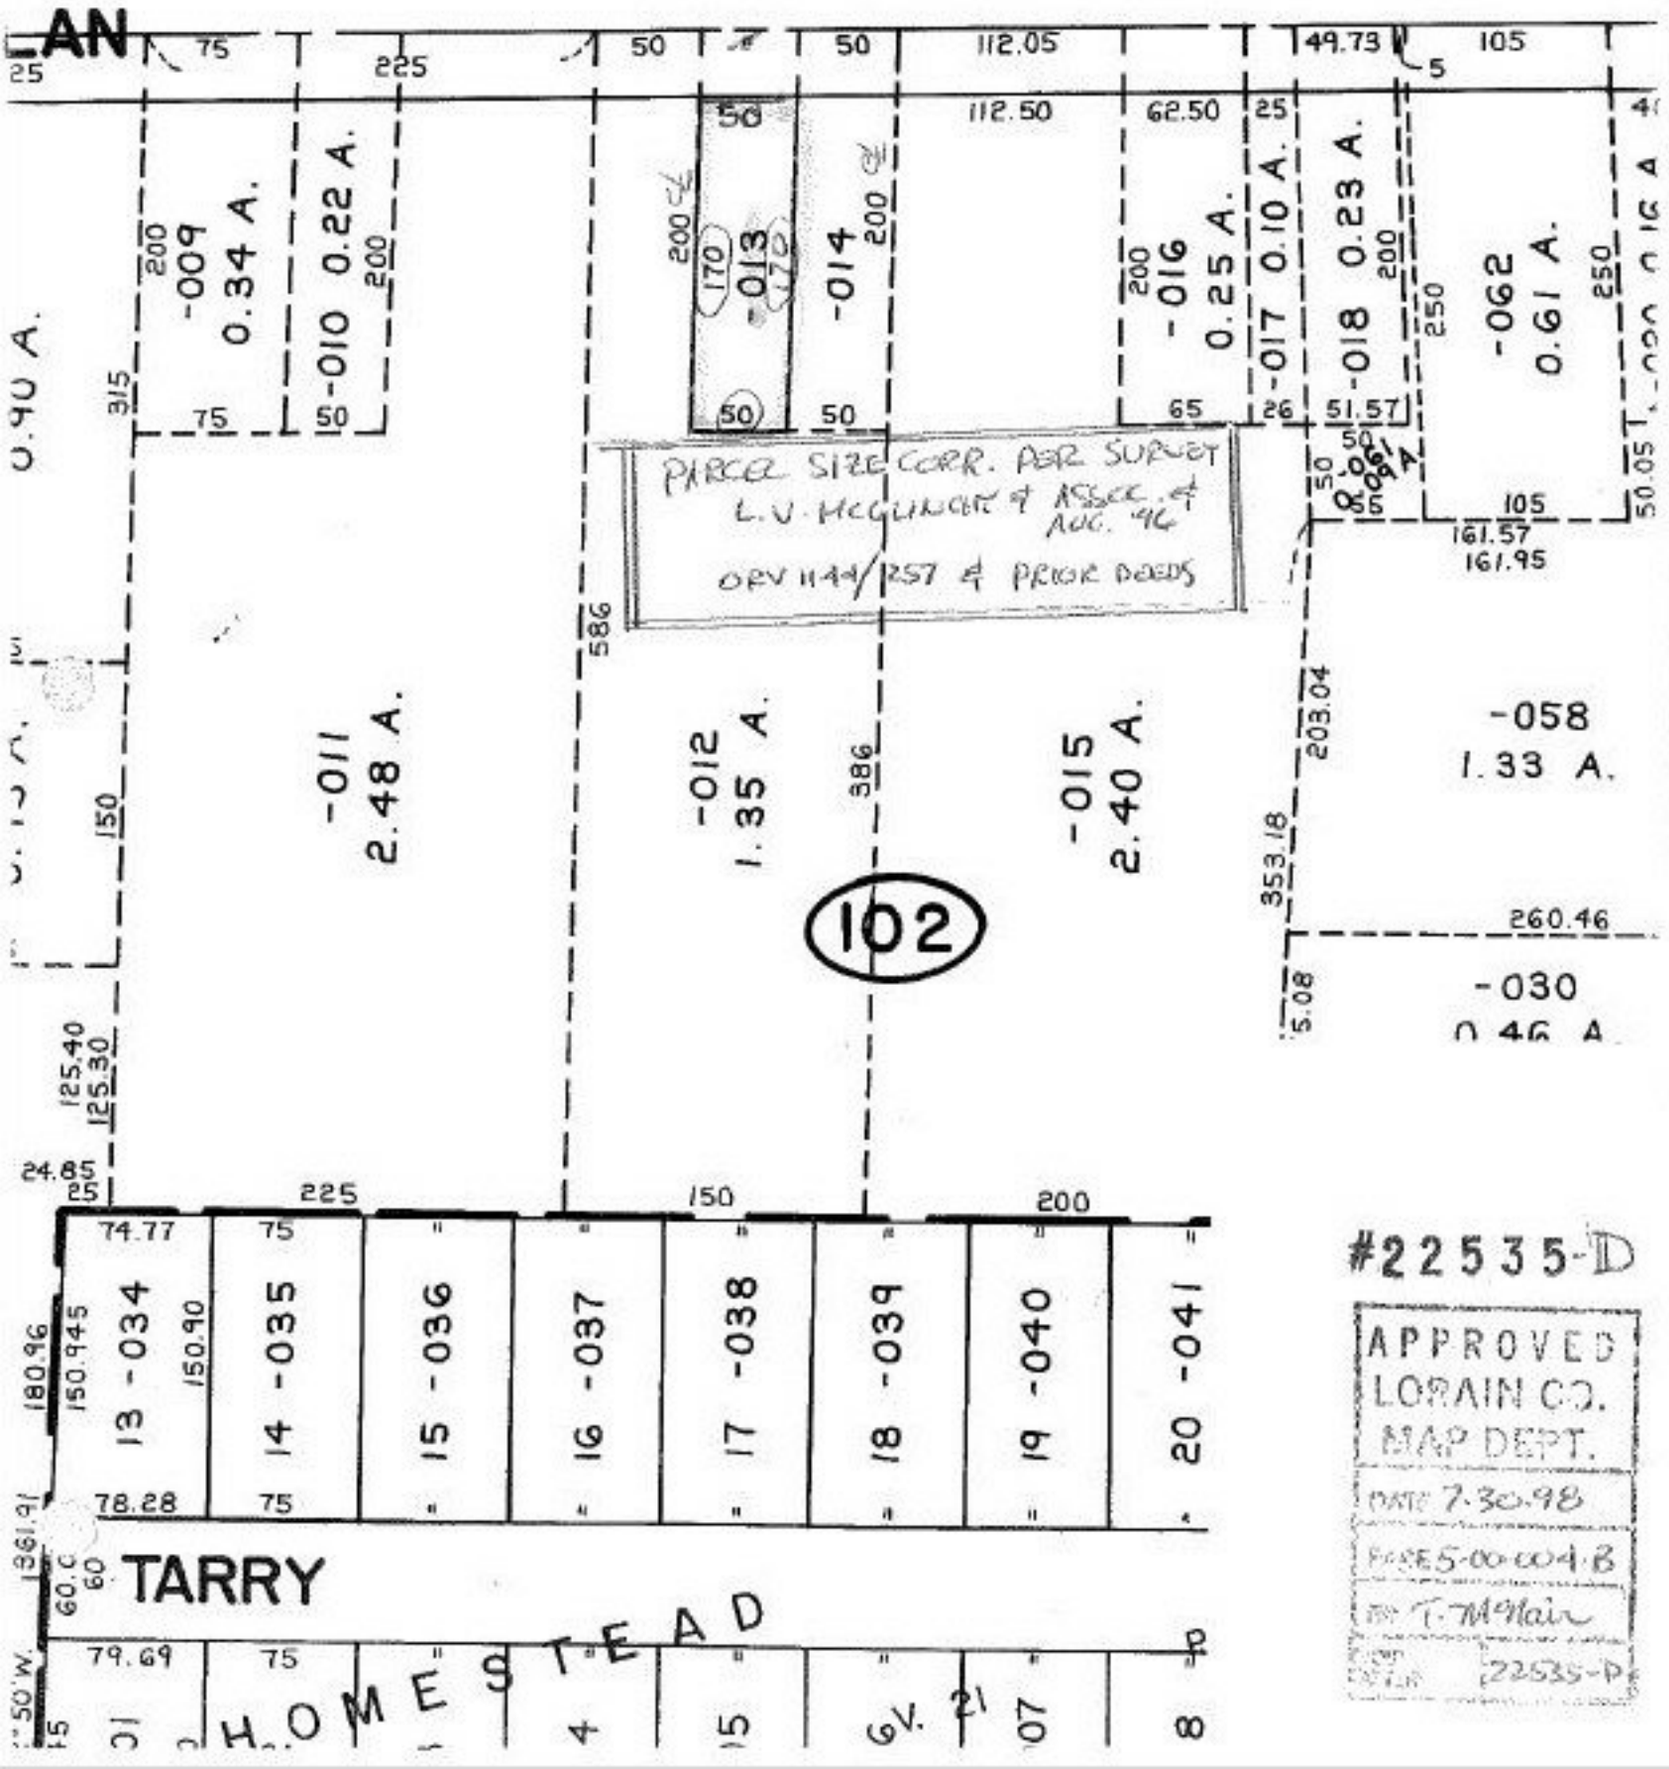

#22535-D

APPROVED
LORAIN CO.
MAP DEPT.
DATE 7-30-98
PARCELS 5-00-004-B
BY T. McNair
CHECKED 22535-P