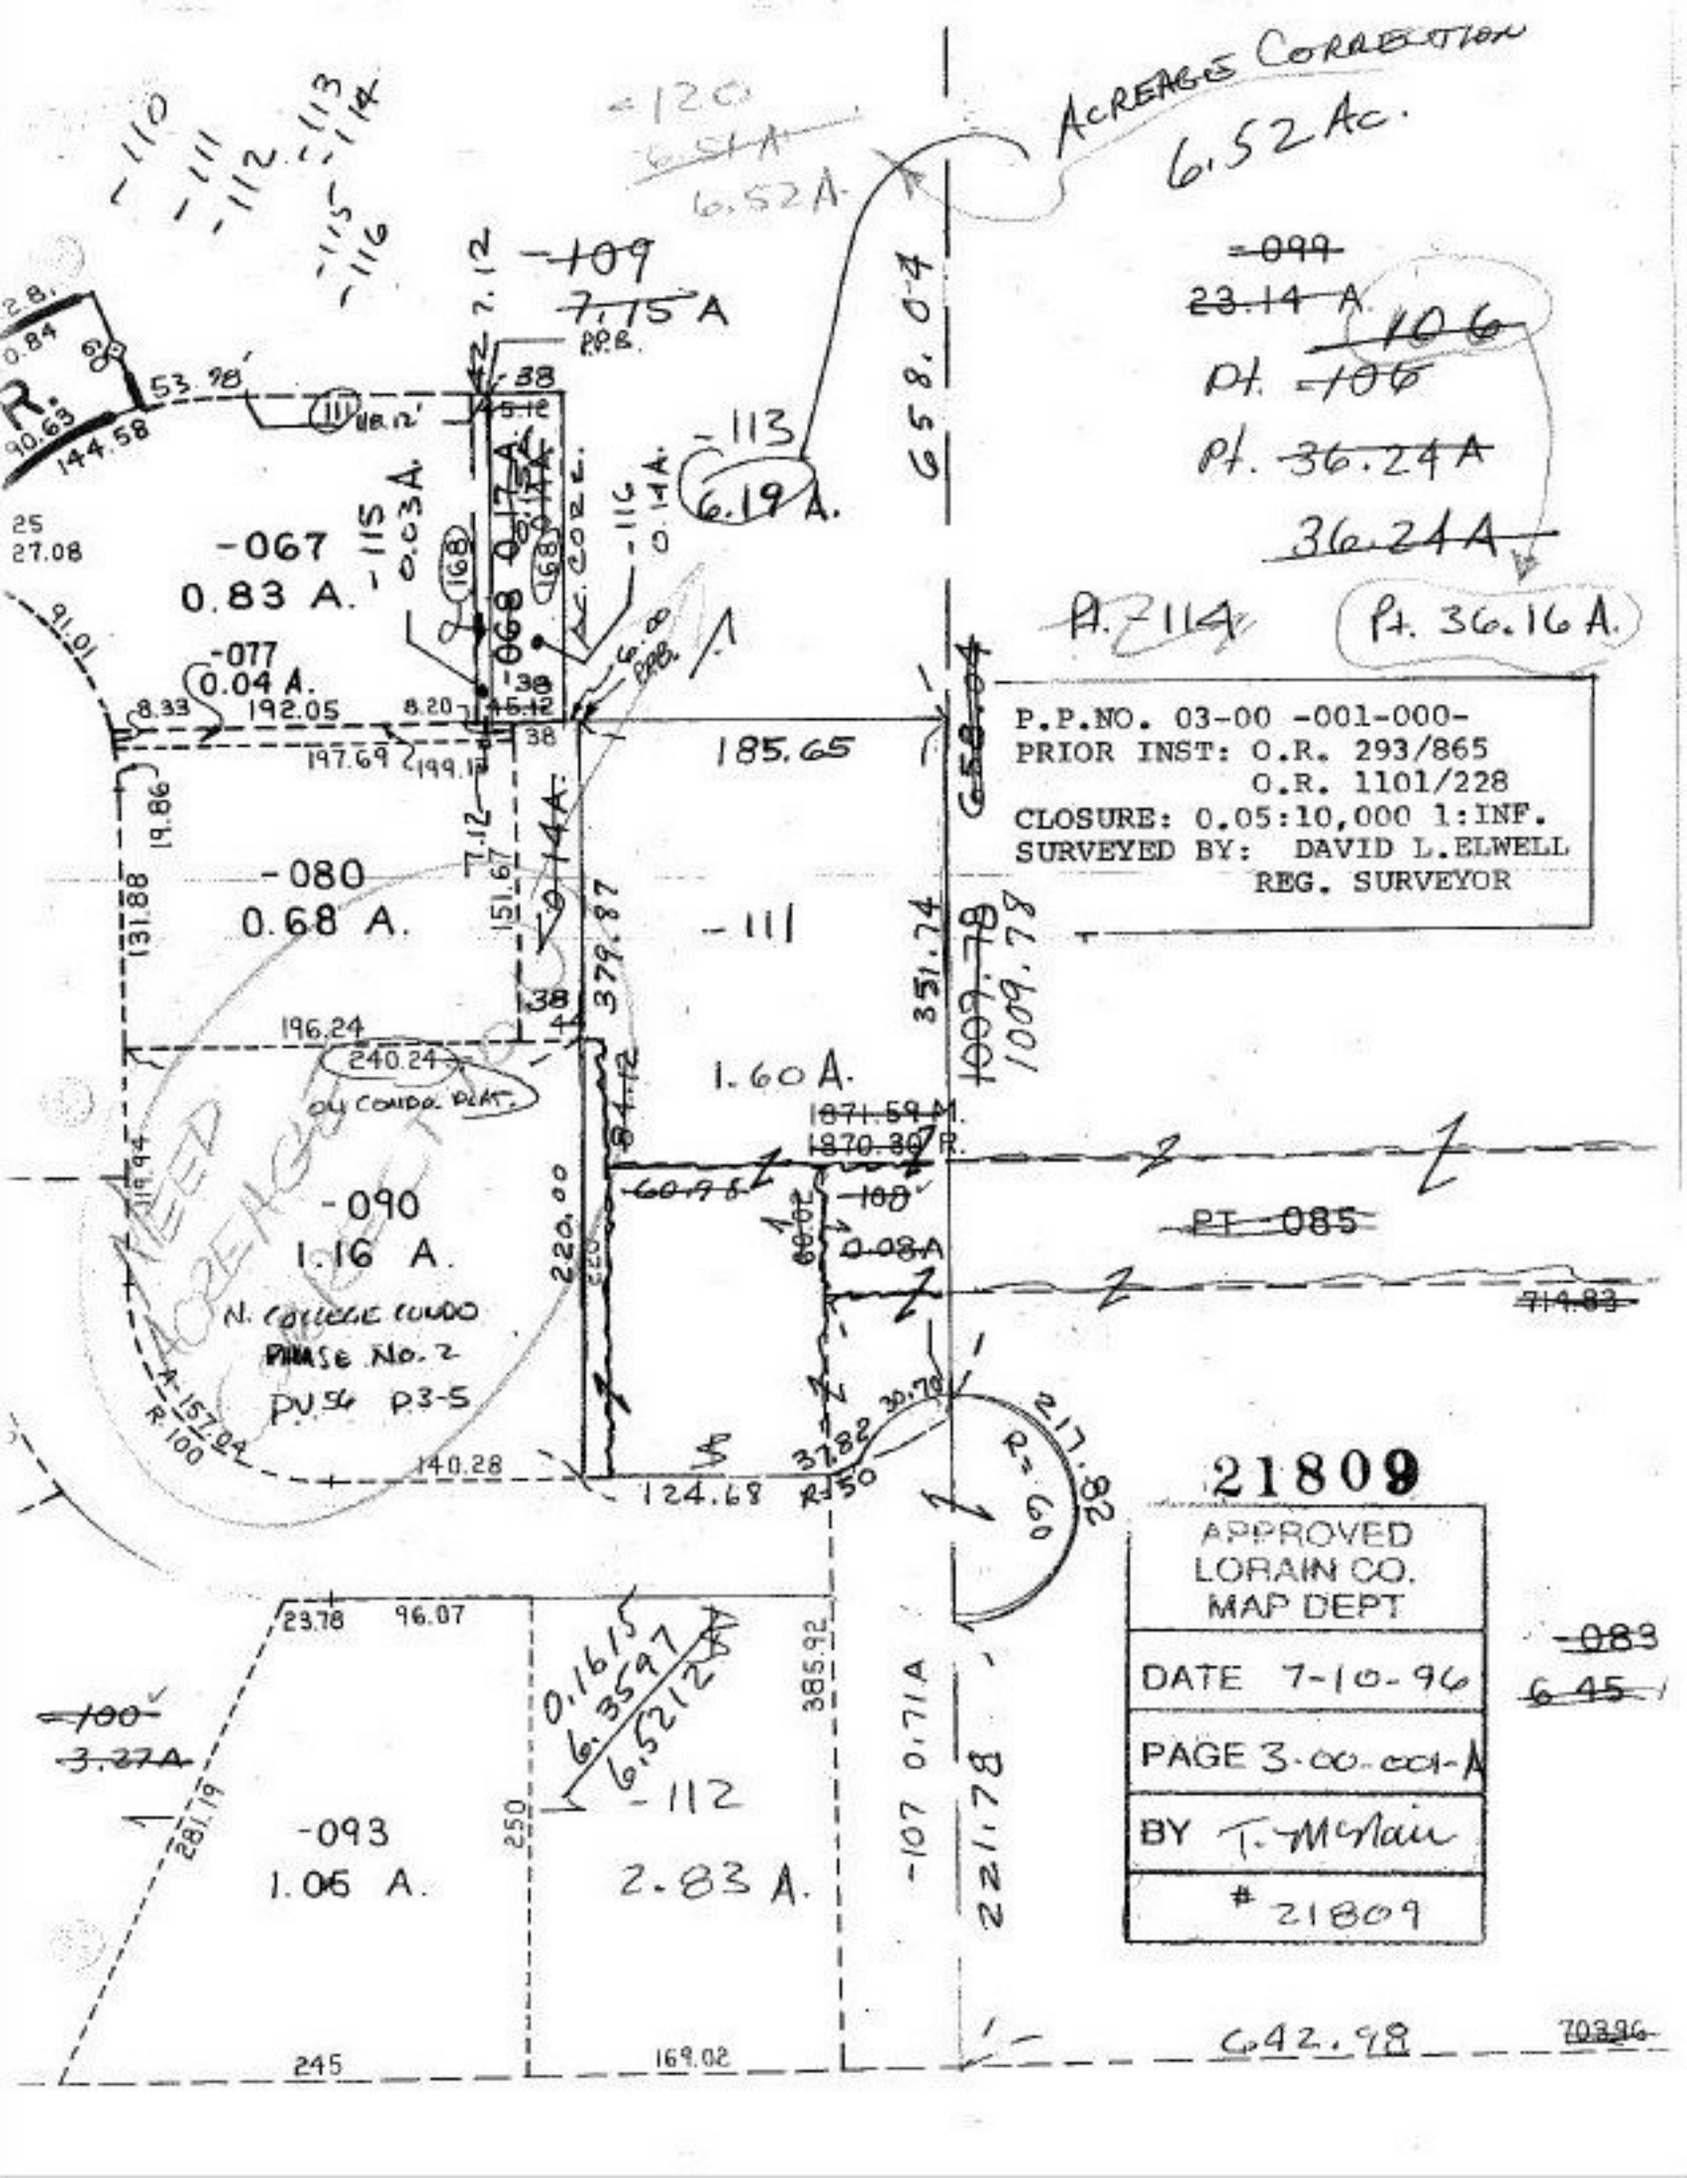
ACREAGE CORRECTION
6.52 Ac.
-120
6.51 A
6.52 A
-109
7.15 A
-099
23.14 A
106
Pt. -106
Pt. 36.24 A
36.24 A
Pt. 36.16 A.
-113
6.19 A.
658.04
-067
0.83 A.
-115
0.03 A.
-068
0.17 A.
-116
0.14 A.
-077
0.04 A.
192.05
197.69
185.65
-080
0.68 A.
-111
1.60 A.
379.87
351.74
1009.78
196.24
240.24
ON CONDO. PLAT.
1871.59 M.
1870.30 R.
-090
1.16 A.
N. COLLEGE CONDO
PHASE No. 2
PV 56 P3-5
220.00
-108
0.08 A
PT -085
714.83
140.28
124.68
R=50
R=60
217.82
-083
6.45
-100
3.27 A
-093
1.05 A.
-112
2.83 A.
0.1615
6.3597
6.5212
385.92
-107 0.71 A
221.78
642.98
703.96
245
169.02
NEED ACREAGE CORRECTION
P.P.NO. 03-00 -001-000-
PRIOR INST: O.R. 293/865
O.R. 1101/228
CLOSURE: 0.05:10,000 1:INF.
SURVEYED BY: DAVID L.ELWELL
REG. SURVEYOR
21809
APPROVED
LORAIN CO.
MAP DEPT
DATE 7-10-96
PAGE 3-00-001-A
BY T. McNair
21809