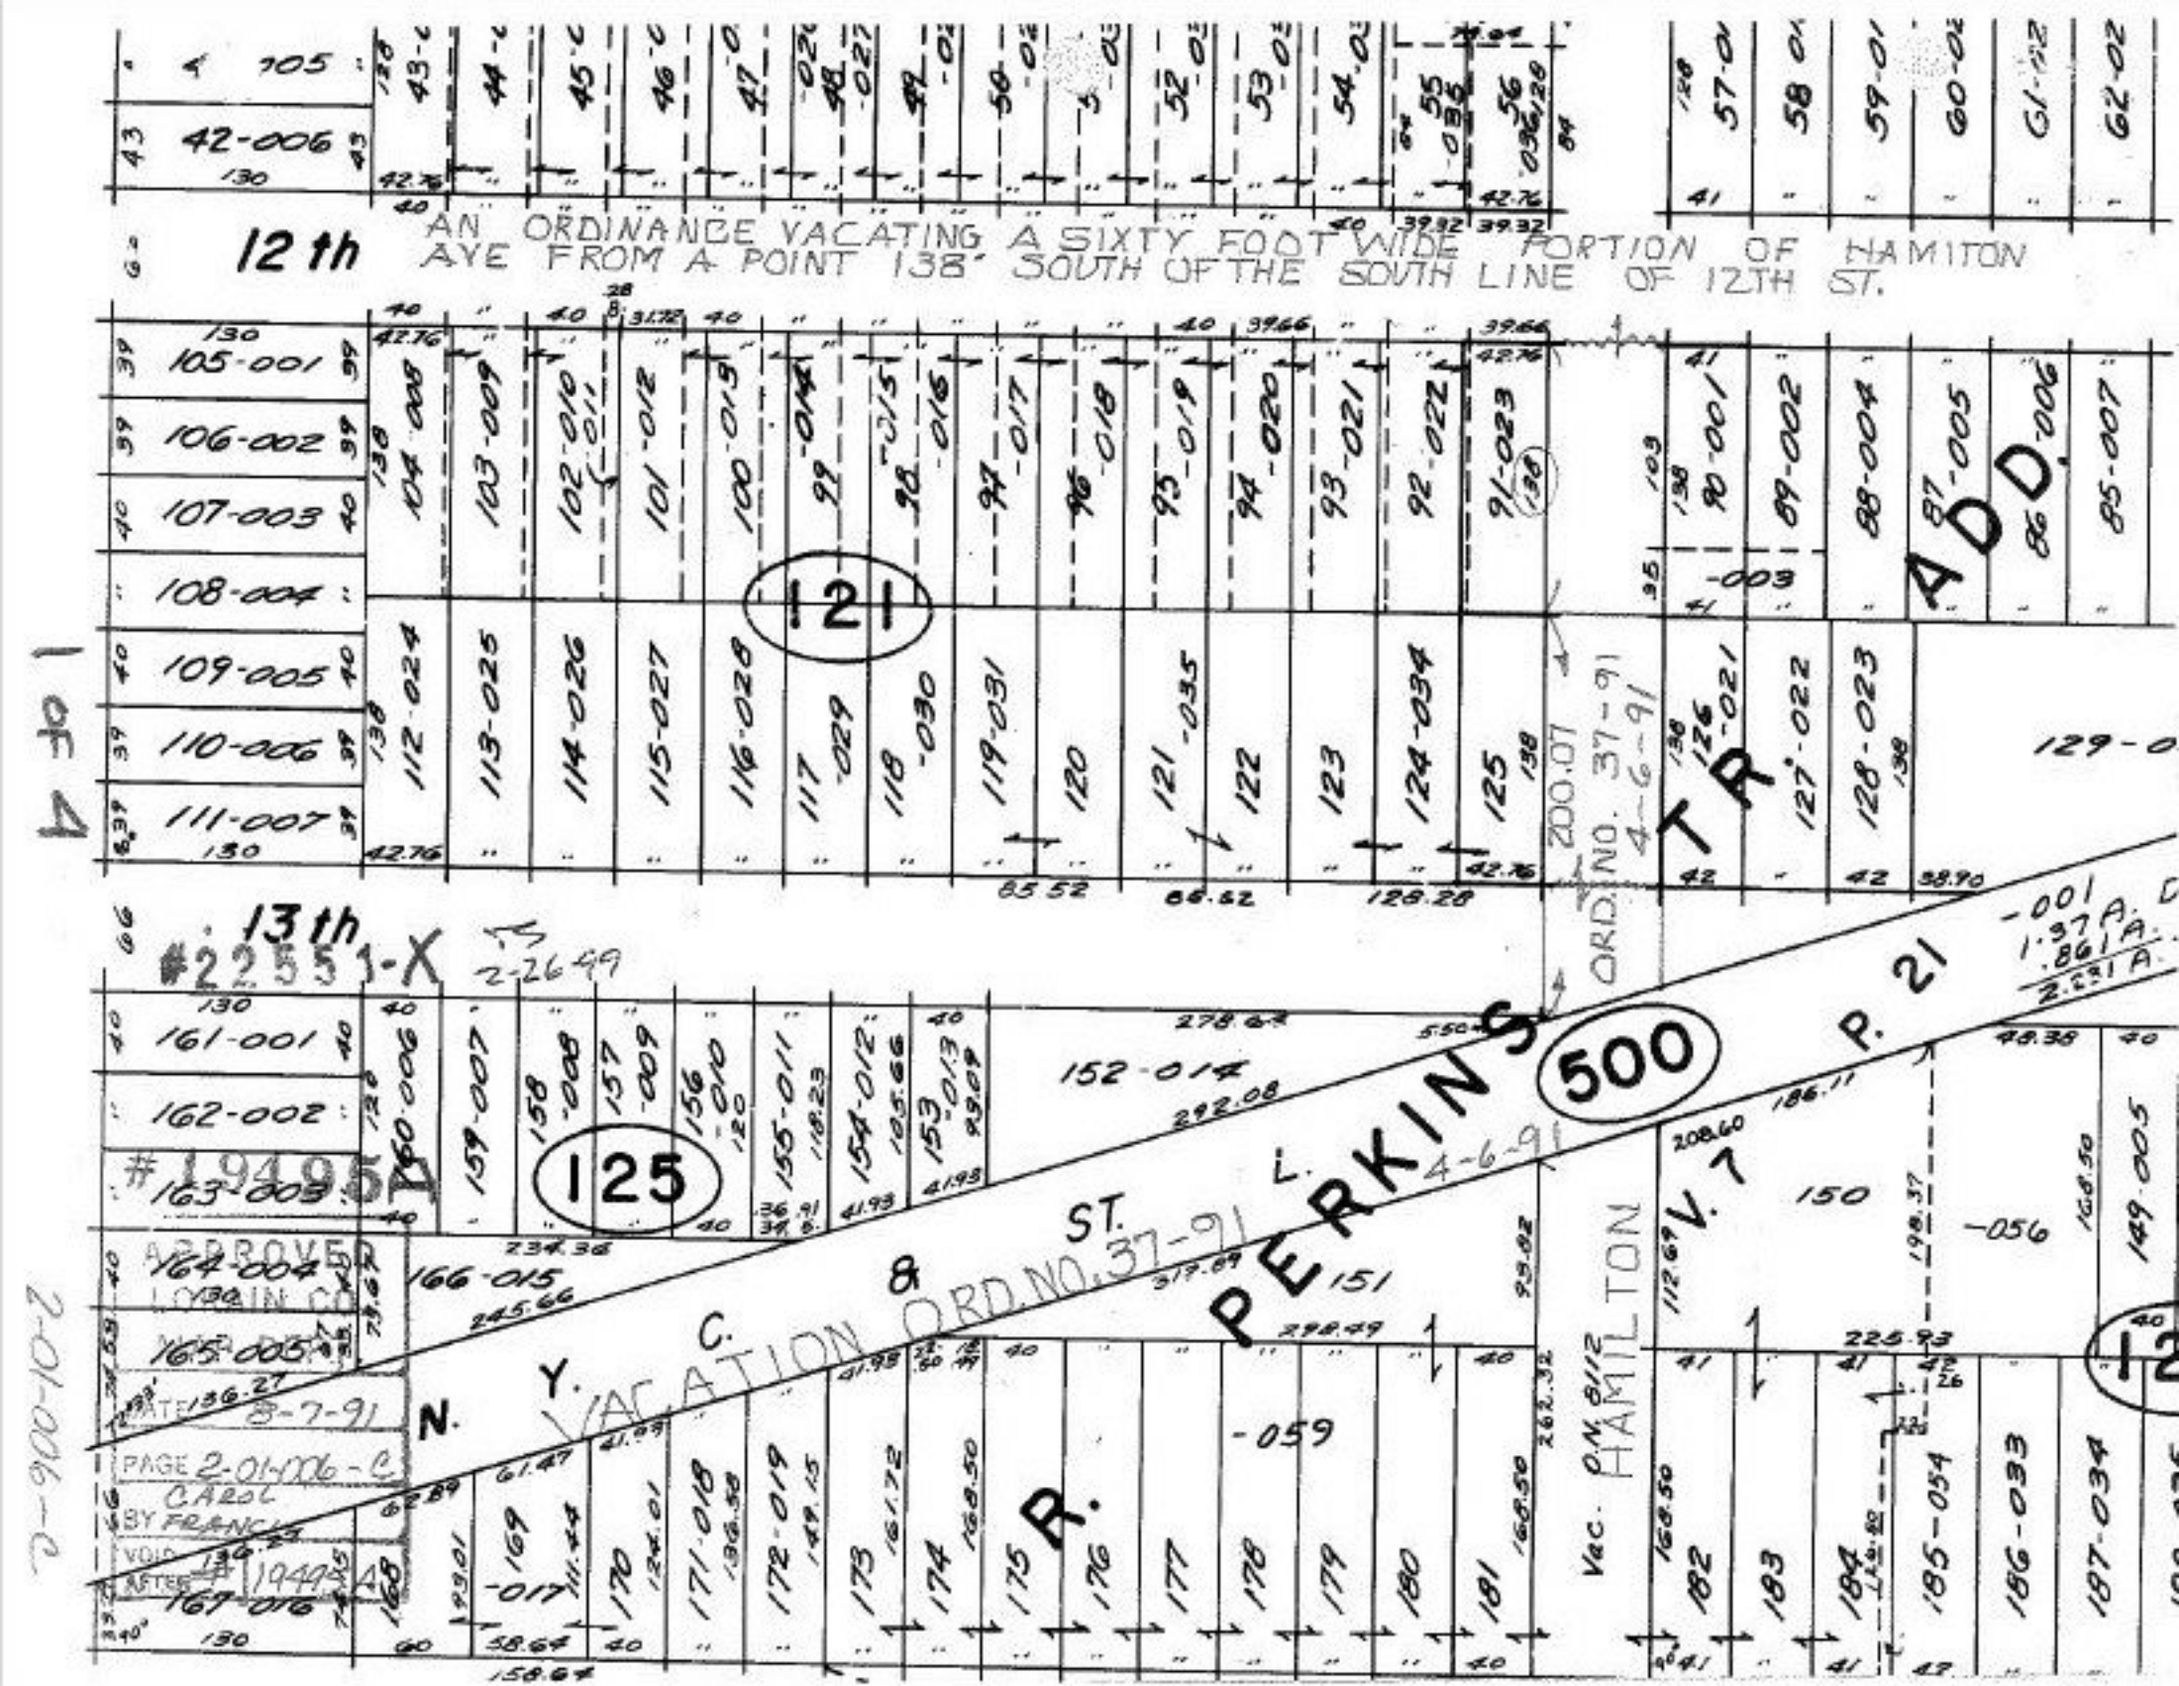
12th
AN ORDINANCE VACATING A SIXTY FOOT WIDE PORTION OF HAMITON AVE FROM A POINT 138' SOUTH OF THE SOUTH LINE OF 12TH ST.
13th
#22551-X
2-26-99
#19495
APPROVED LORRAINE CO
DATE 8-7-91
PAGE 2-01-006-C
CAROL
BY FRANCIS
VOID AFTER #19495
2-01-006-C
PERKINS
ST.
N. Y. C. & R.
VACATION ORD NO. 37-91
ORD NO. 37-91
4-6-91
P. 21
V. 7
Vac. O.N. 8112
HAMILTON
TR
ADD
125
500
150
1 of 4