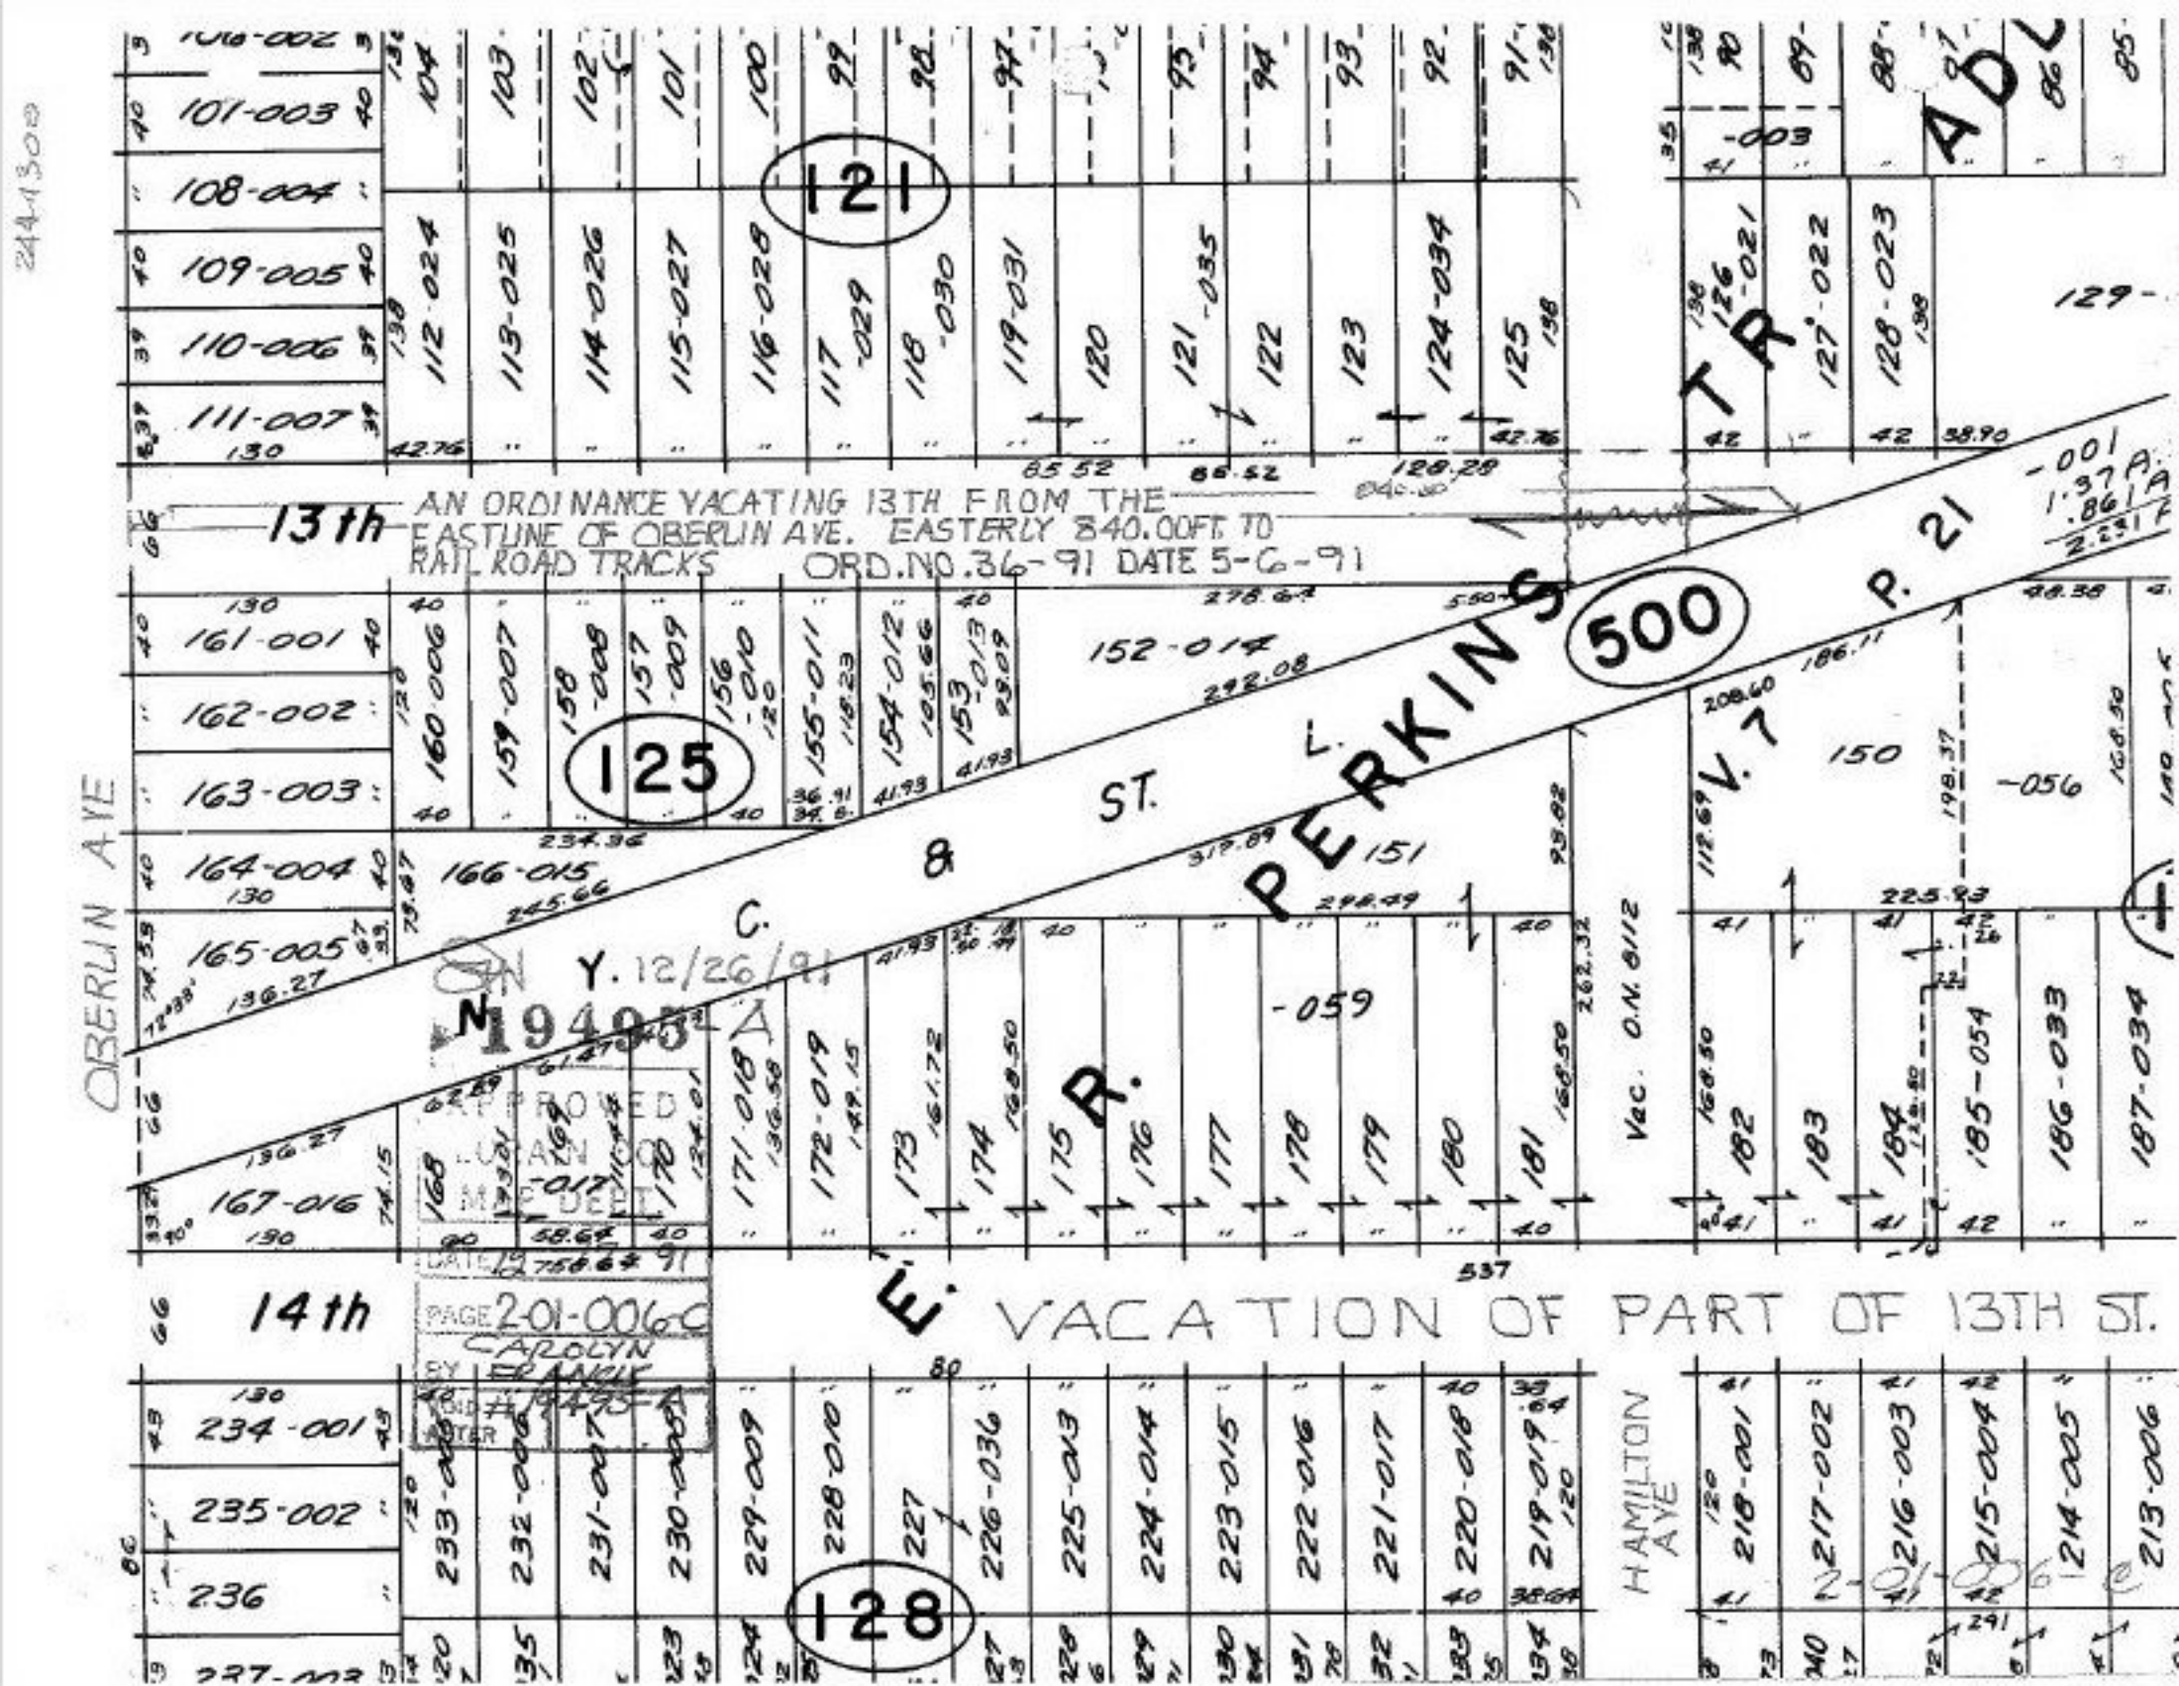

AN ORDINANCE VACATING 13TH FROM THE EASTLINE OF OBERLIN AVE. EASTERLY 840.00FT. TO RAILROAD TRACKS ORD.NO.36-91 DATE 5-6-91
13th
14th
OBERLIN AVE
HAMILTON AVE
PERKINS
C. & ST. L.
E. R.
V. 7
P. 21
ADD
121
125
128
500
Vac. O.N. 8112
Y. 12/26/91
N 19495-A
APPROVED
LORAIN CO.
MAP DEPT.
DATE 12/26/91
PAGE 2-01-006-C
CAROLYN
BY FRANCIS
VOID #19495-A
AFTER
VACATION OF PART OF 13TH ST.
2-01-006-C