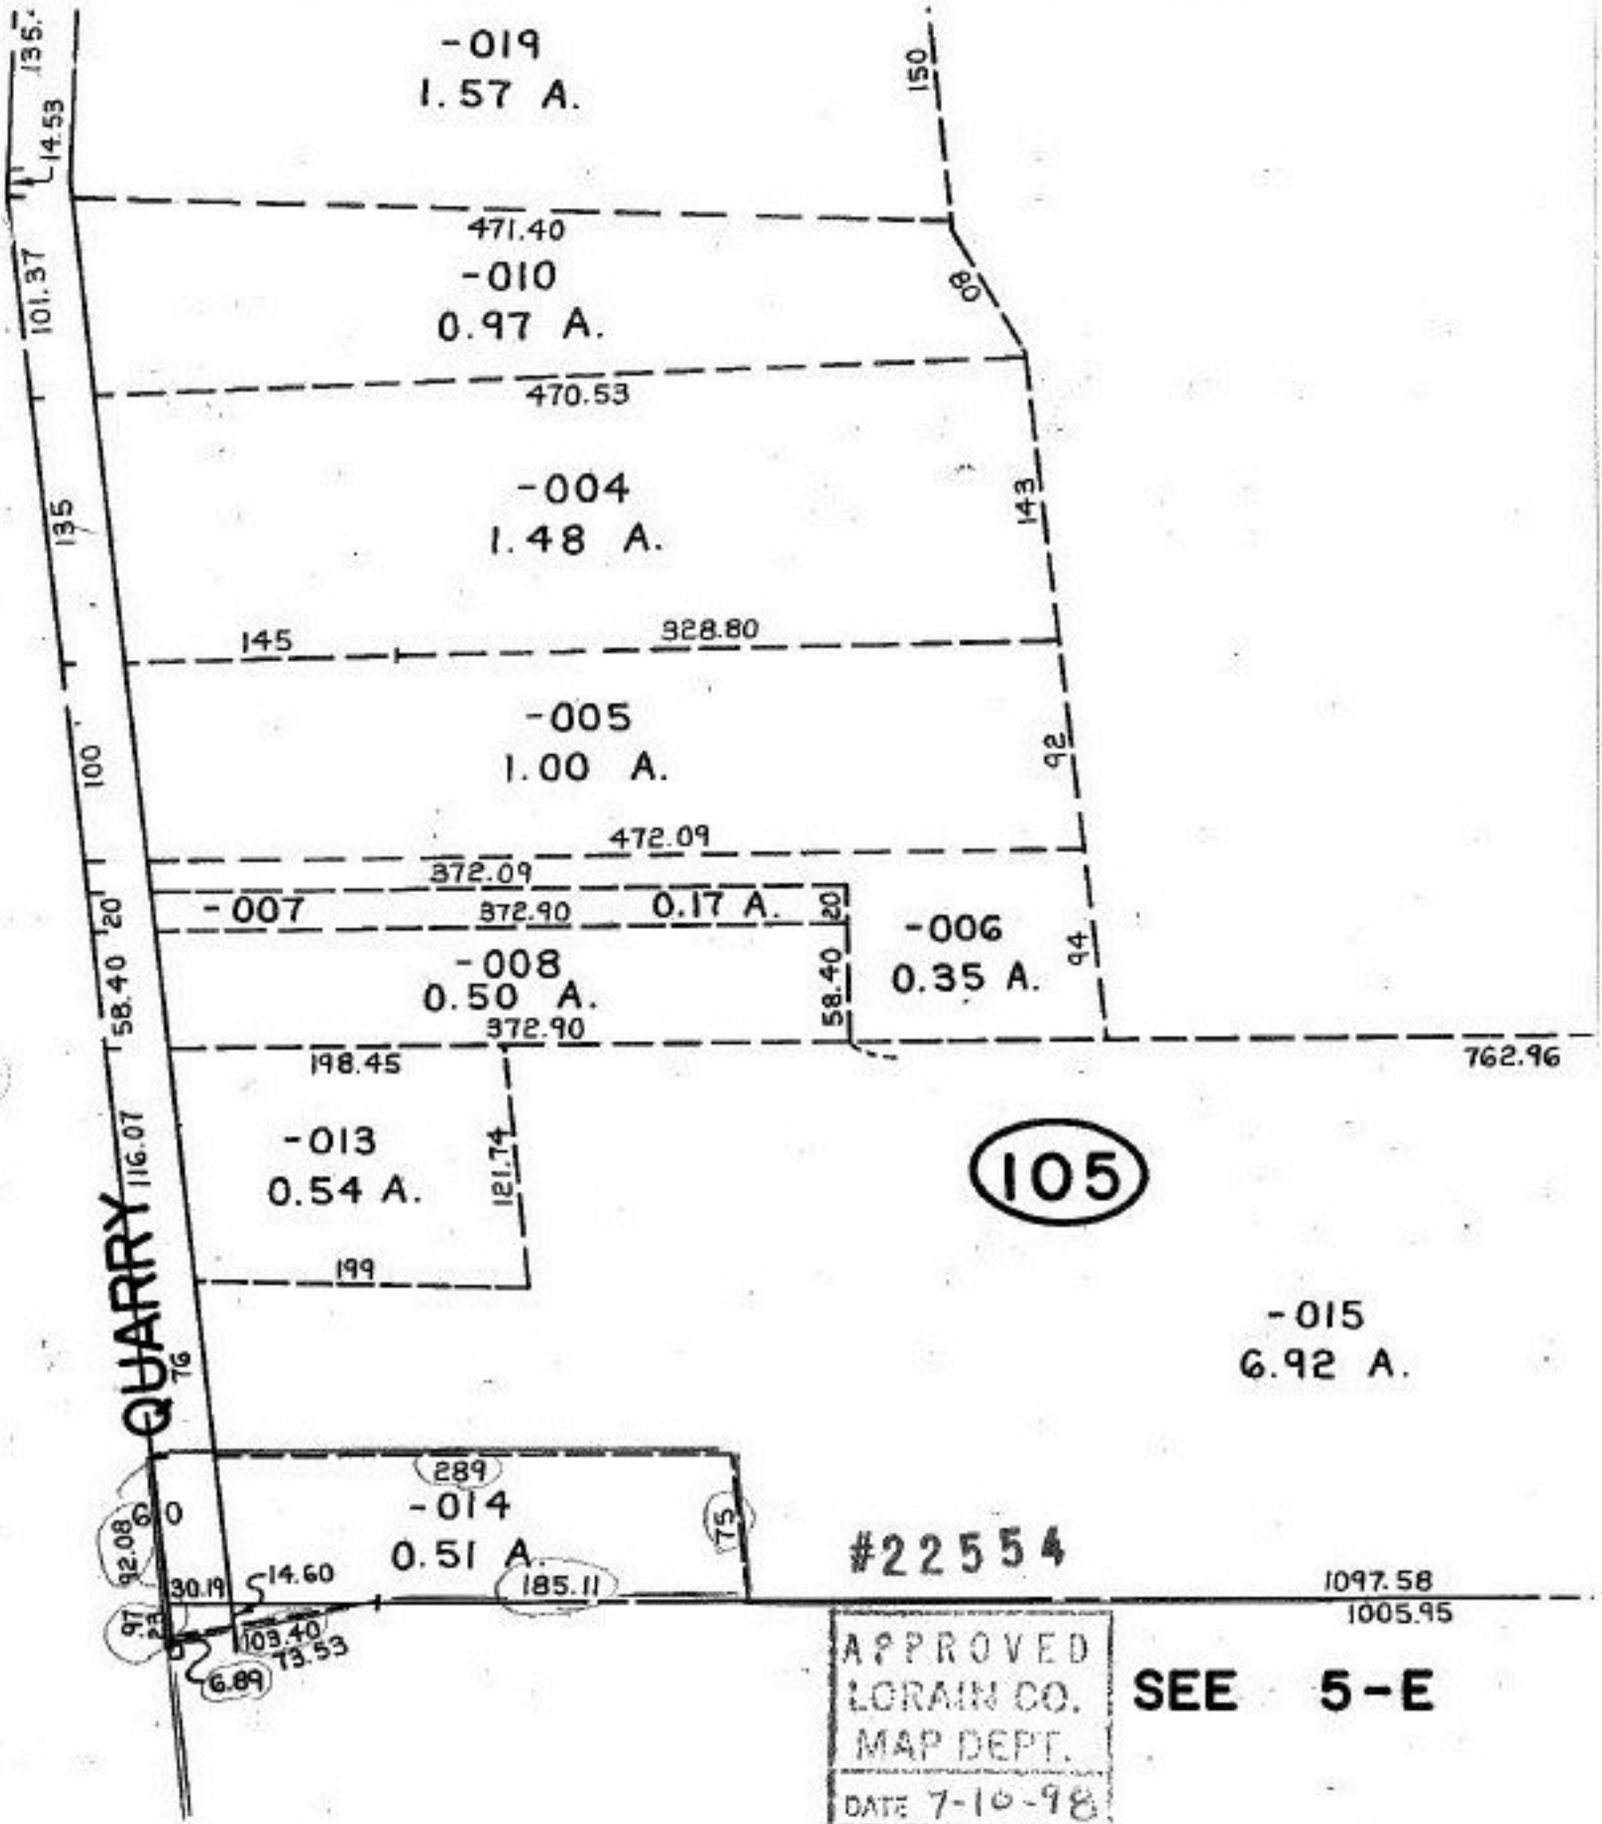

T.M.Ps. 5-00-094-C