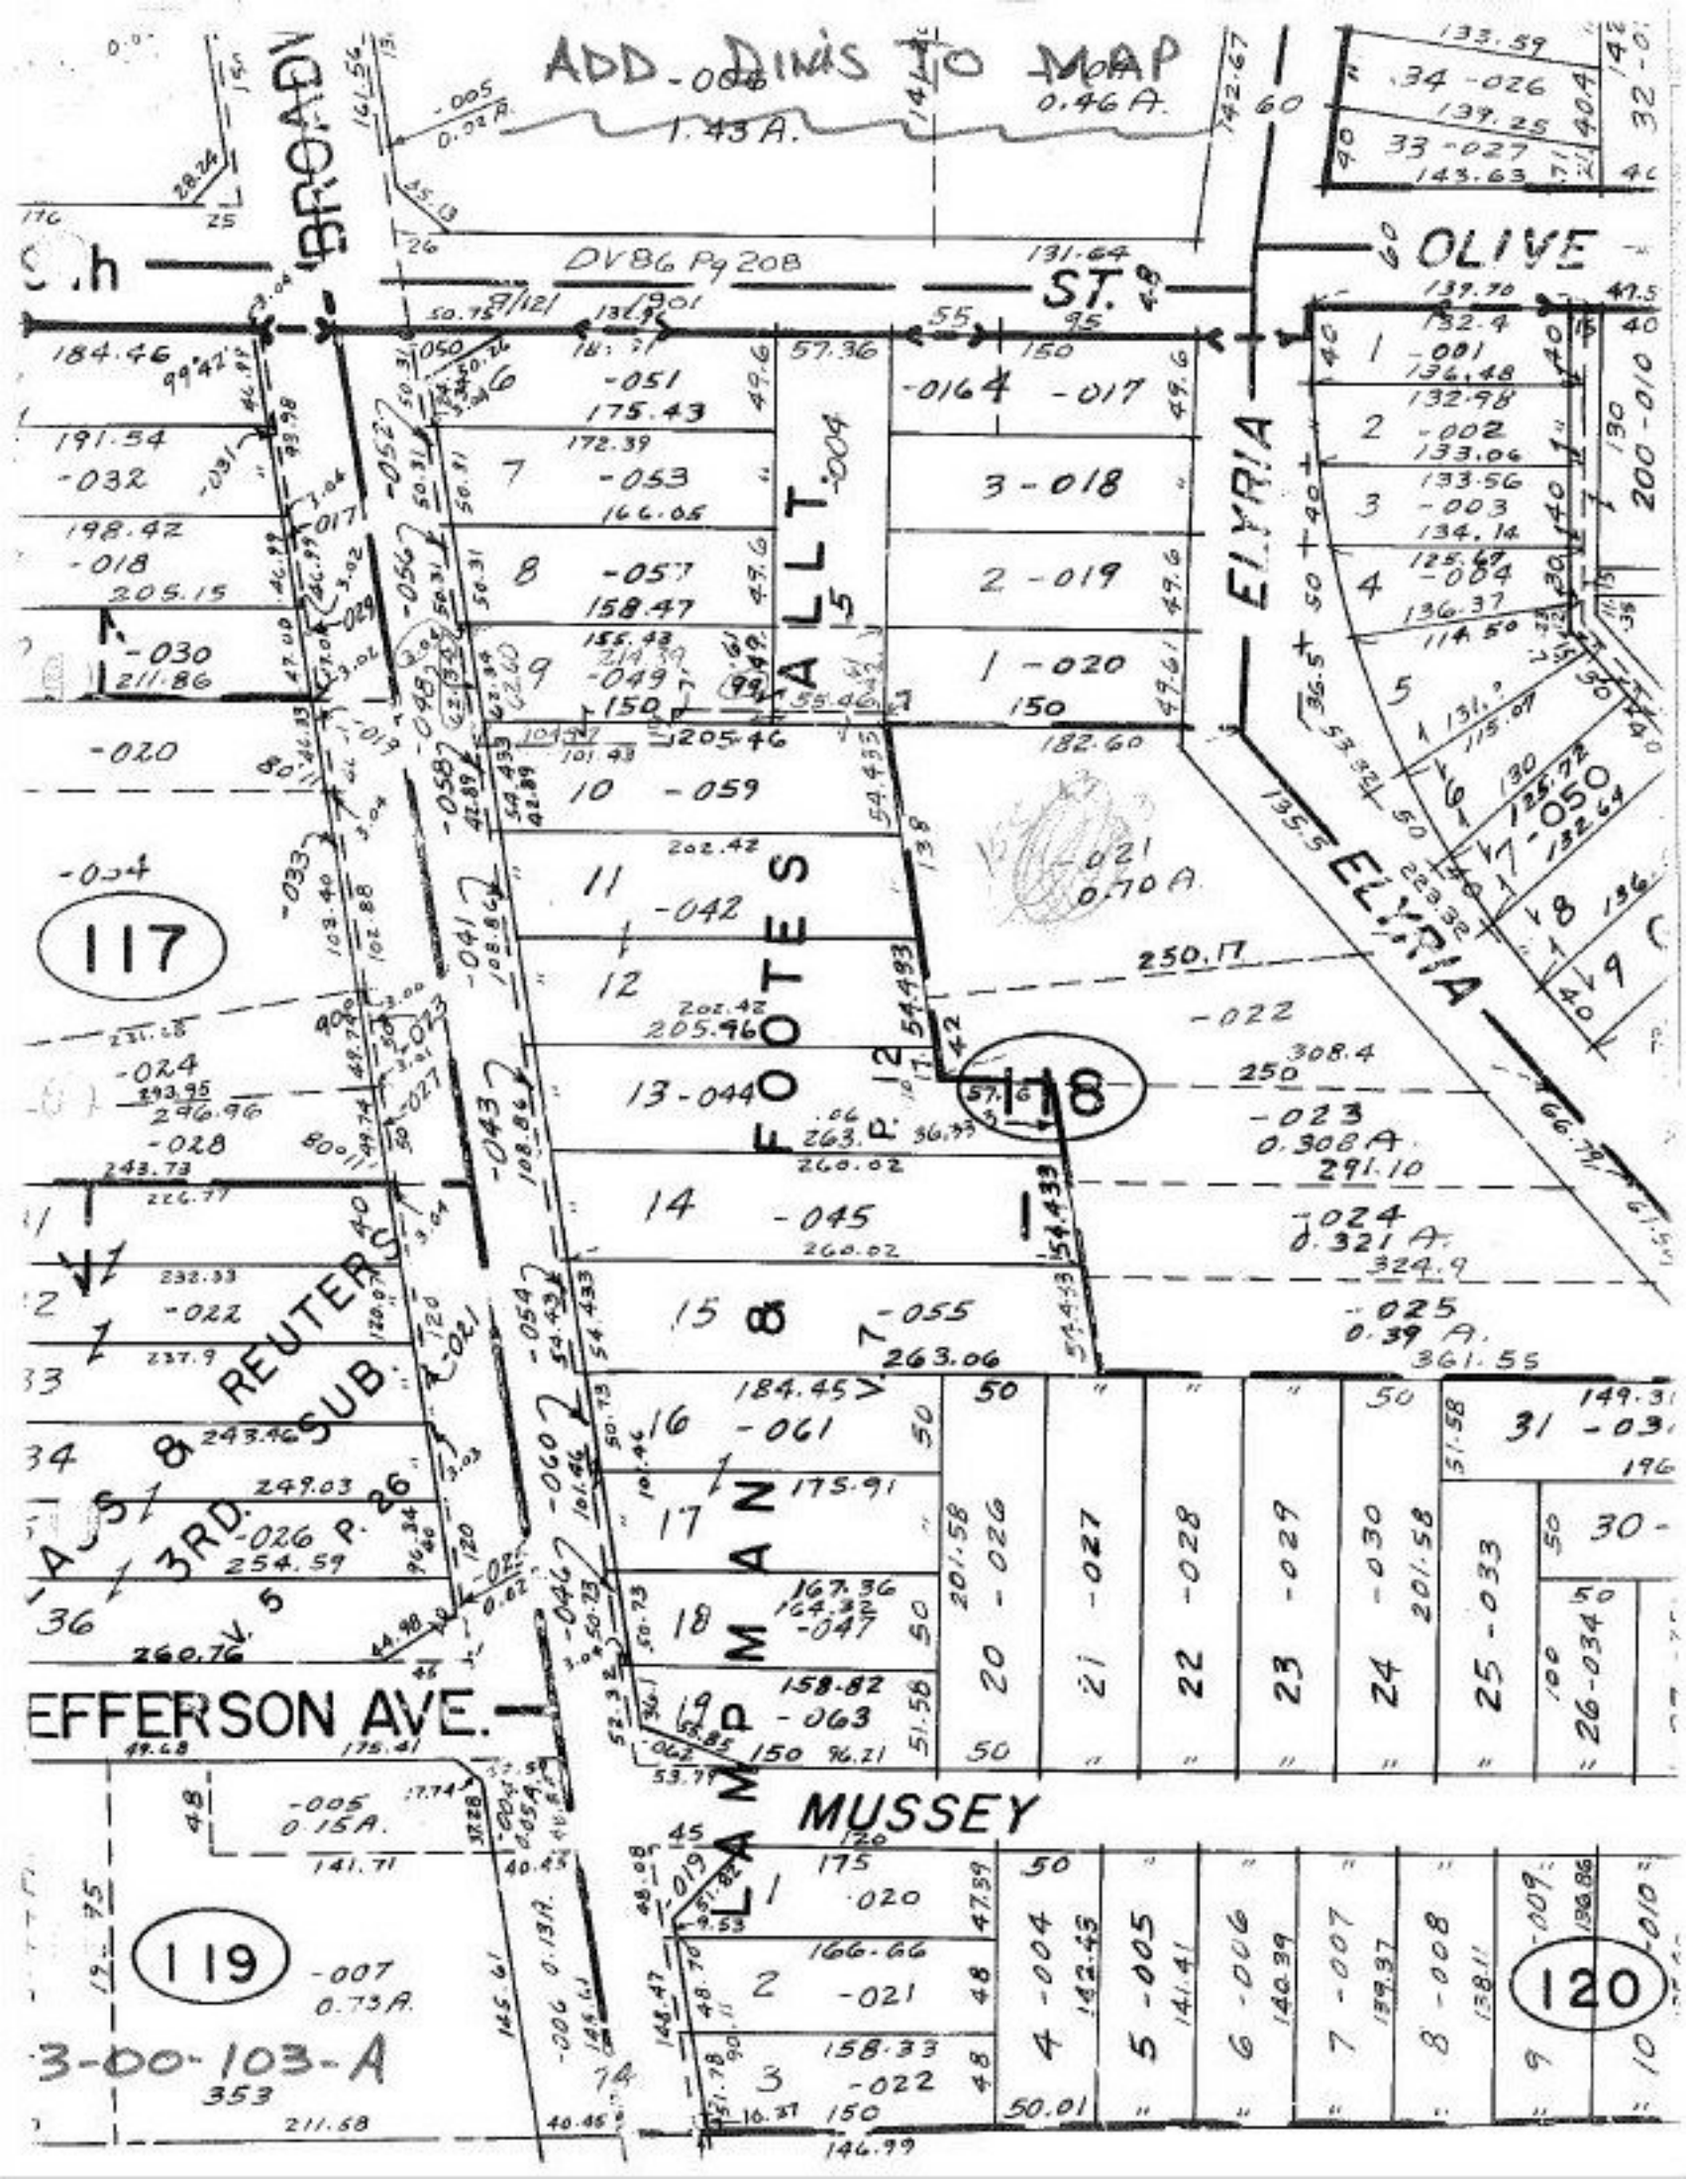
ADD-006 DIMS TO MAP
1.43 A.
0.46 A.
BROADWAY
OLIVE ST.
DV 86 Pg 208
FOOTES
HALLT
REUTER SUB
3RD.
MANN
LA
MUSSEY
JEFFERSON AVE.
117
118
119
120
3-00-103-A
0.15 A.
0.73 A.
0.70 A.
0.308 A.
0.321 A.
0.39 A.