


#2256  
 APPROVED  
 LORAIN CO.  
 MAP DEPT.  
 DATE 11-15-66  
 5-00-038  
 BY LWHall

RR

#2256

5-00-038A

SEE 5-00-023-B

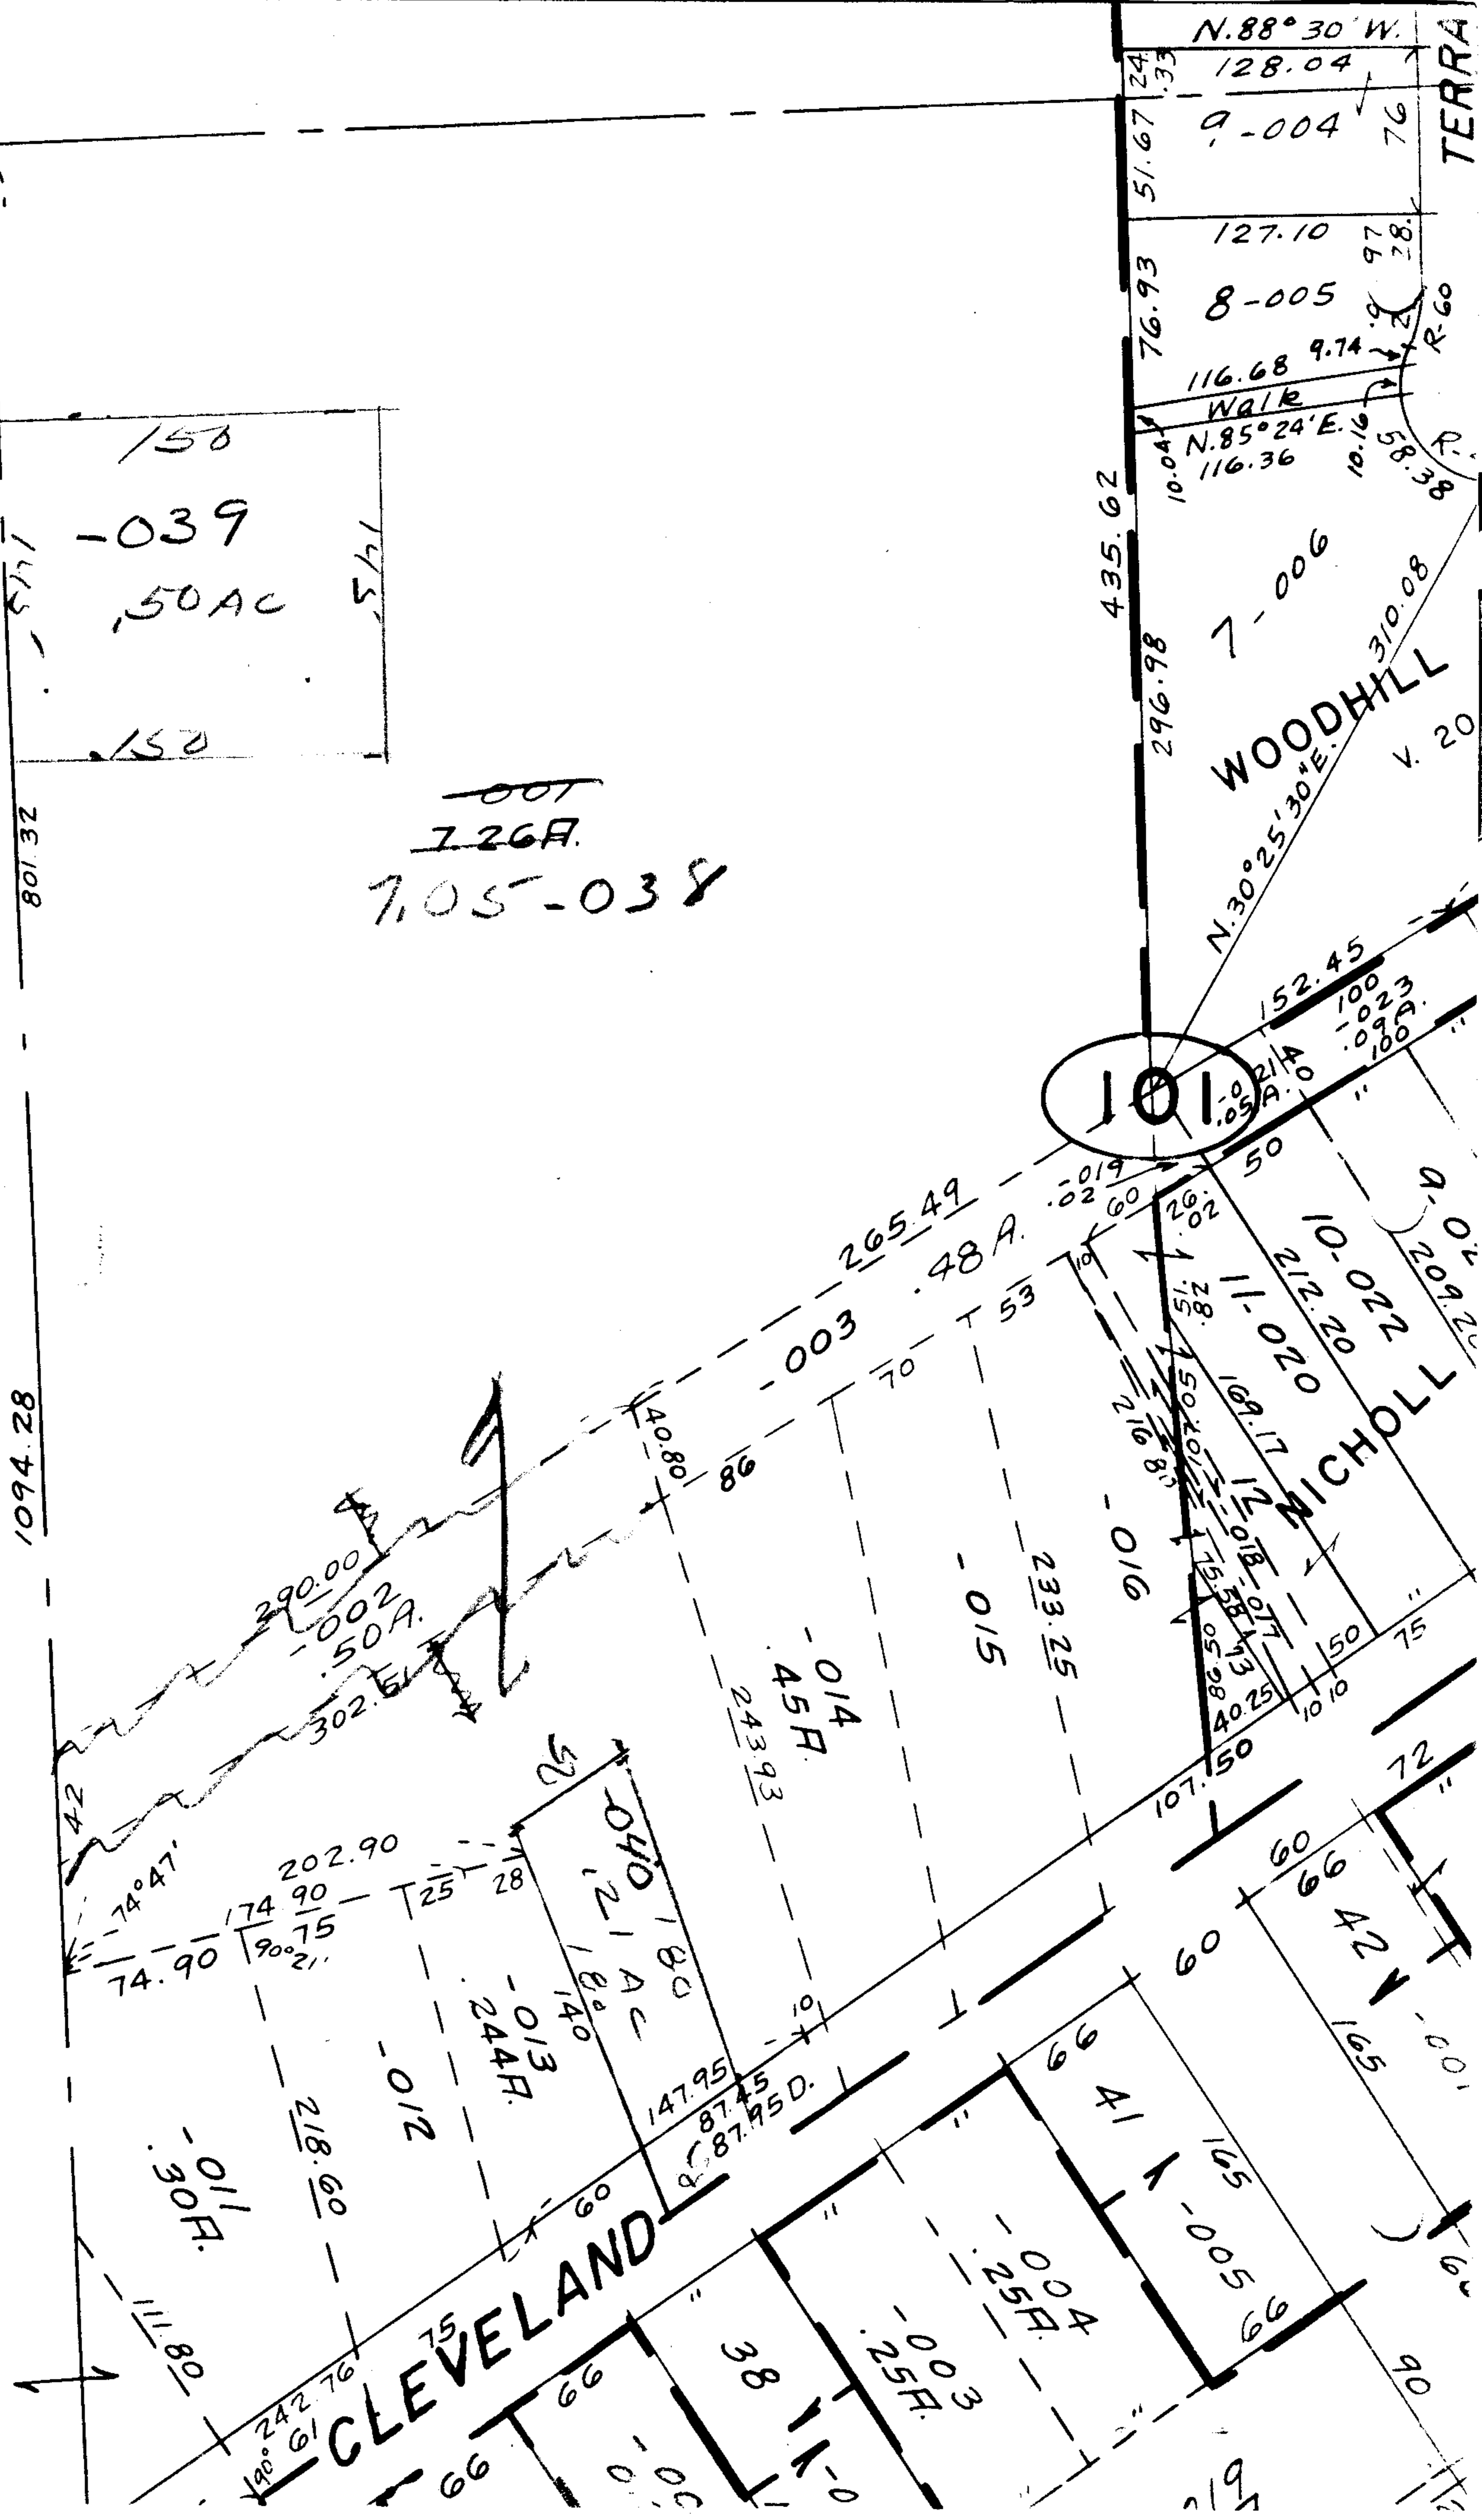

*(Handwritten signature)*

150  
 -039  
 150 AC  
 145  
 5/11

~~100~~  
 7.26A.  
 7.05-038

101

WOODHILL

NICHOLL

CLEVELAND

TERRA

801.32

1094.28

N. 88° 30' W.

128.04

9-004

127.10

8-005

116.68

WALK

N. 85° 24' E.

116.36

7-006

N. 30° 25' 30\"/>

310.08

4-20

152.45

100

1023

1005

1005

