PARENT PARCEL: 10-00-015-115-052, 007 & 008

CHILD PARCEL: 10-00-015-115-059 THRU 061

STARTING POINT: R.R.S. AT THE CL OF ROBSON RD. NORTH & CL OF ROBSON RD. EAST

NO. 22564

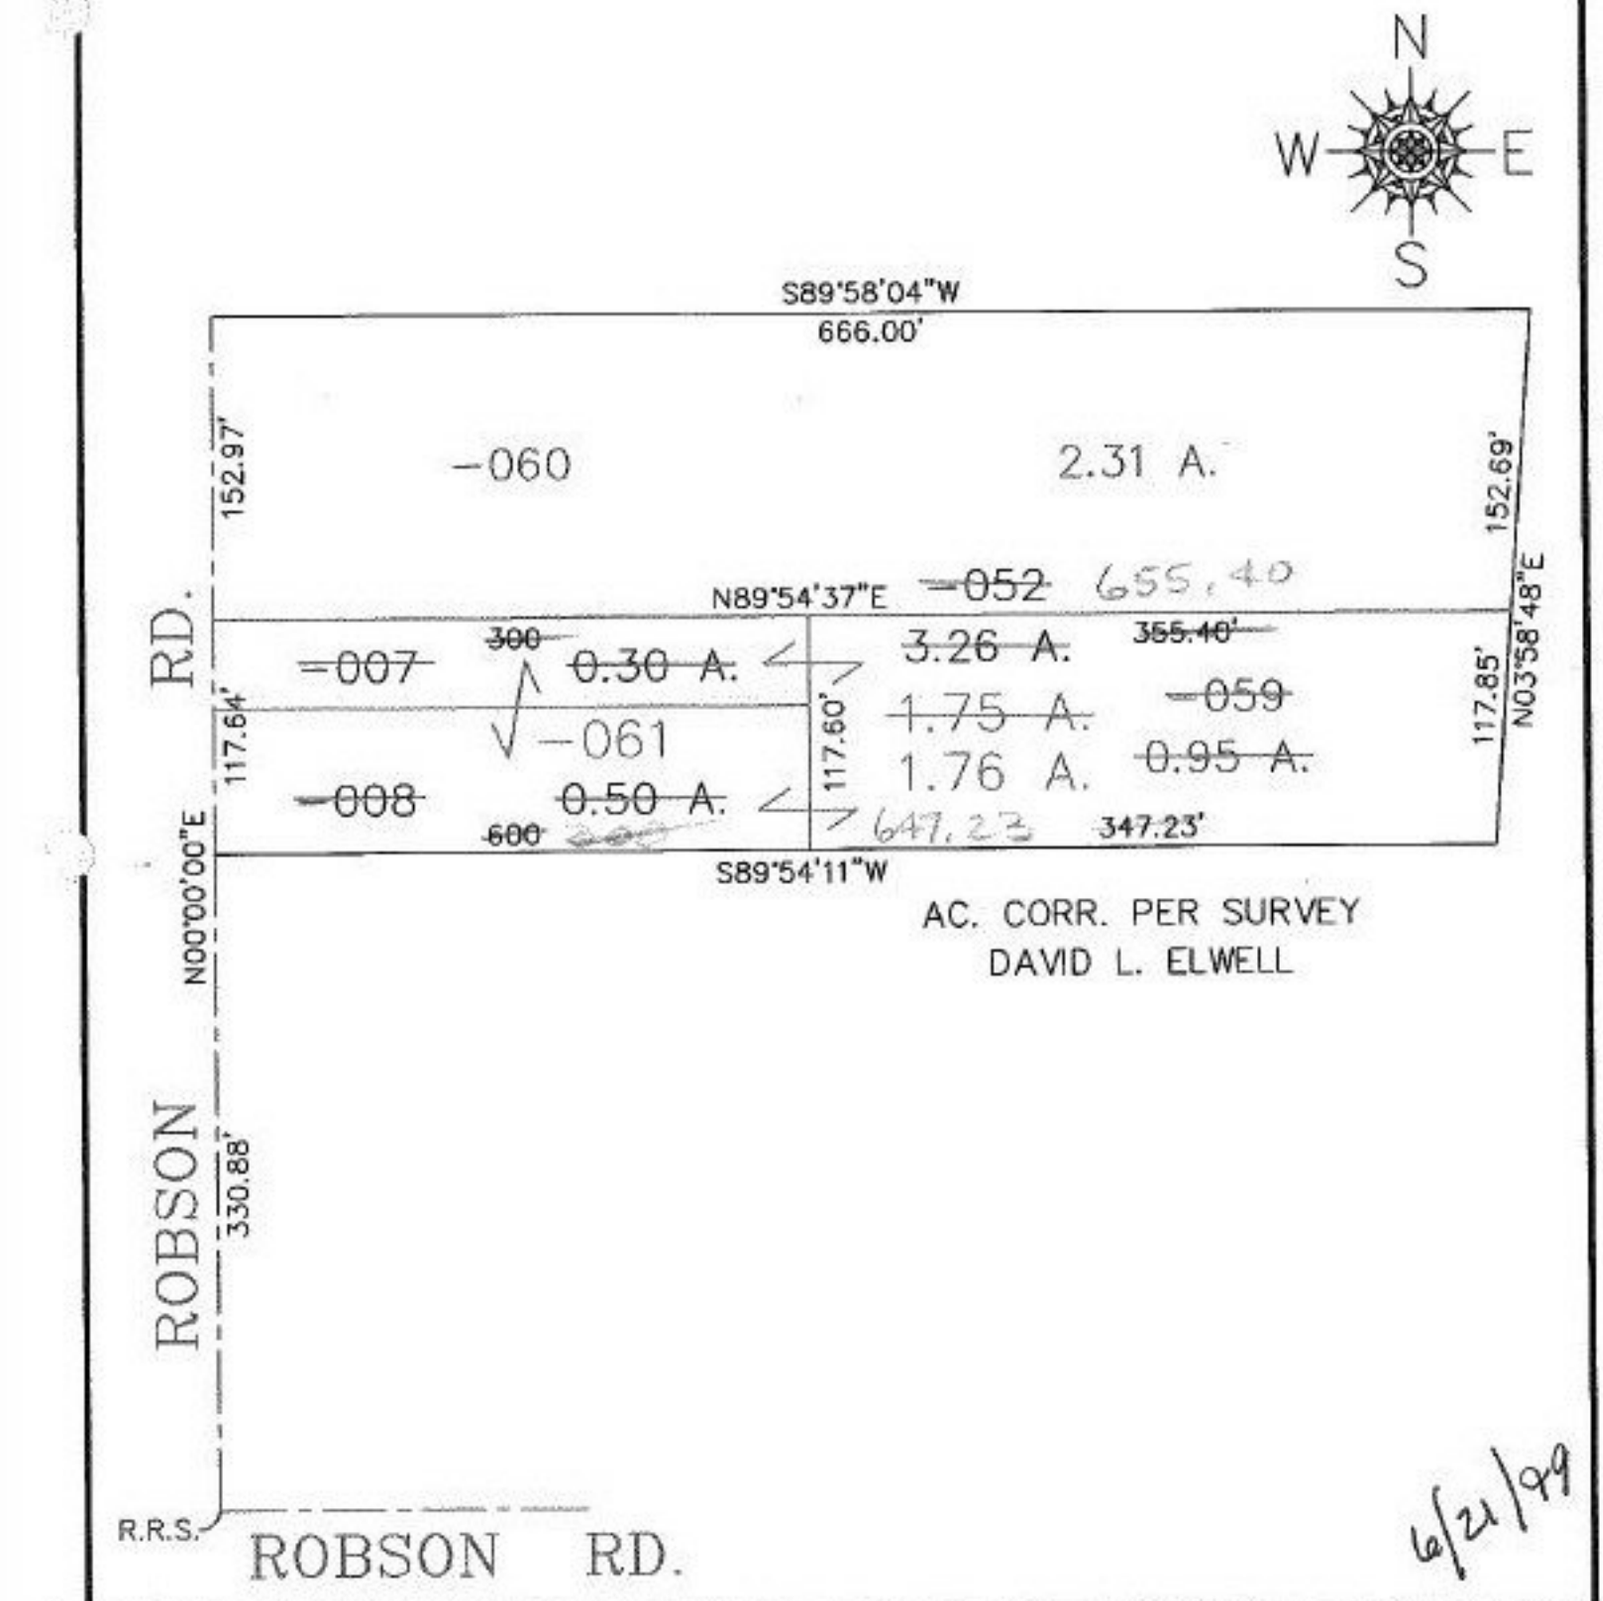

AC. CORR. PER SURVEY
DAVID L. ELWELL

6/21/99

SPLITS/DEEDS PROCESSED

LORAIN COUNTY TAX MAP DEPARTMENT
226 MIDDLE AVE. ELYRIA, OHIO

SURVEYED BY: DAVID L. ELWELL

CLOSURE: 0.12 : 10,000

MAP PAGE(S): 10-00-015-F

APPROVED BY: TJS DATE: 07/01/98

SCALE: 1" = 100 PRIOR INSTRUMENT: OR 1210/336 OR 1398/832