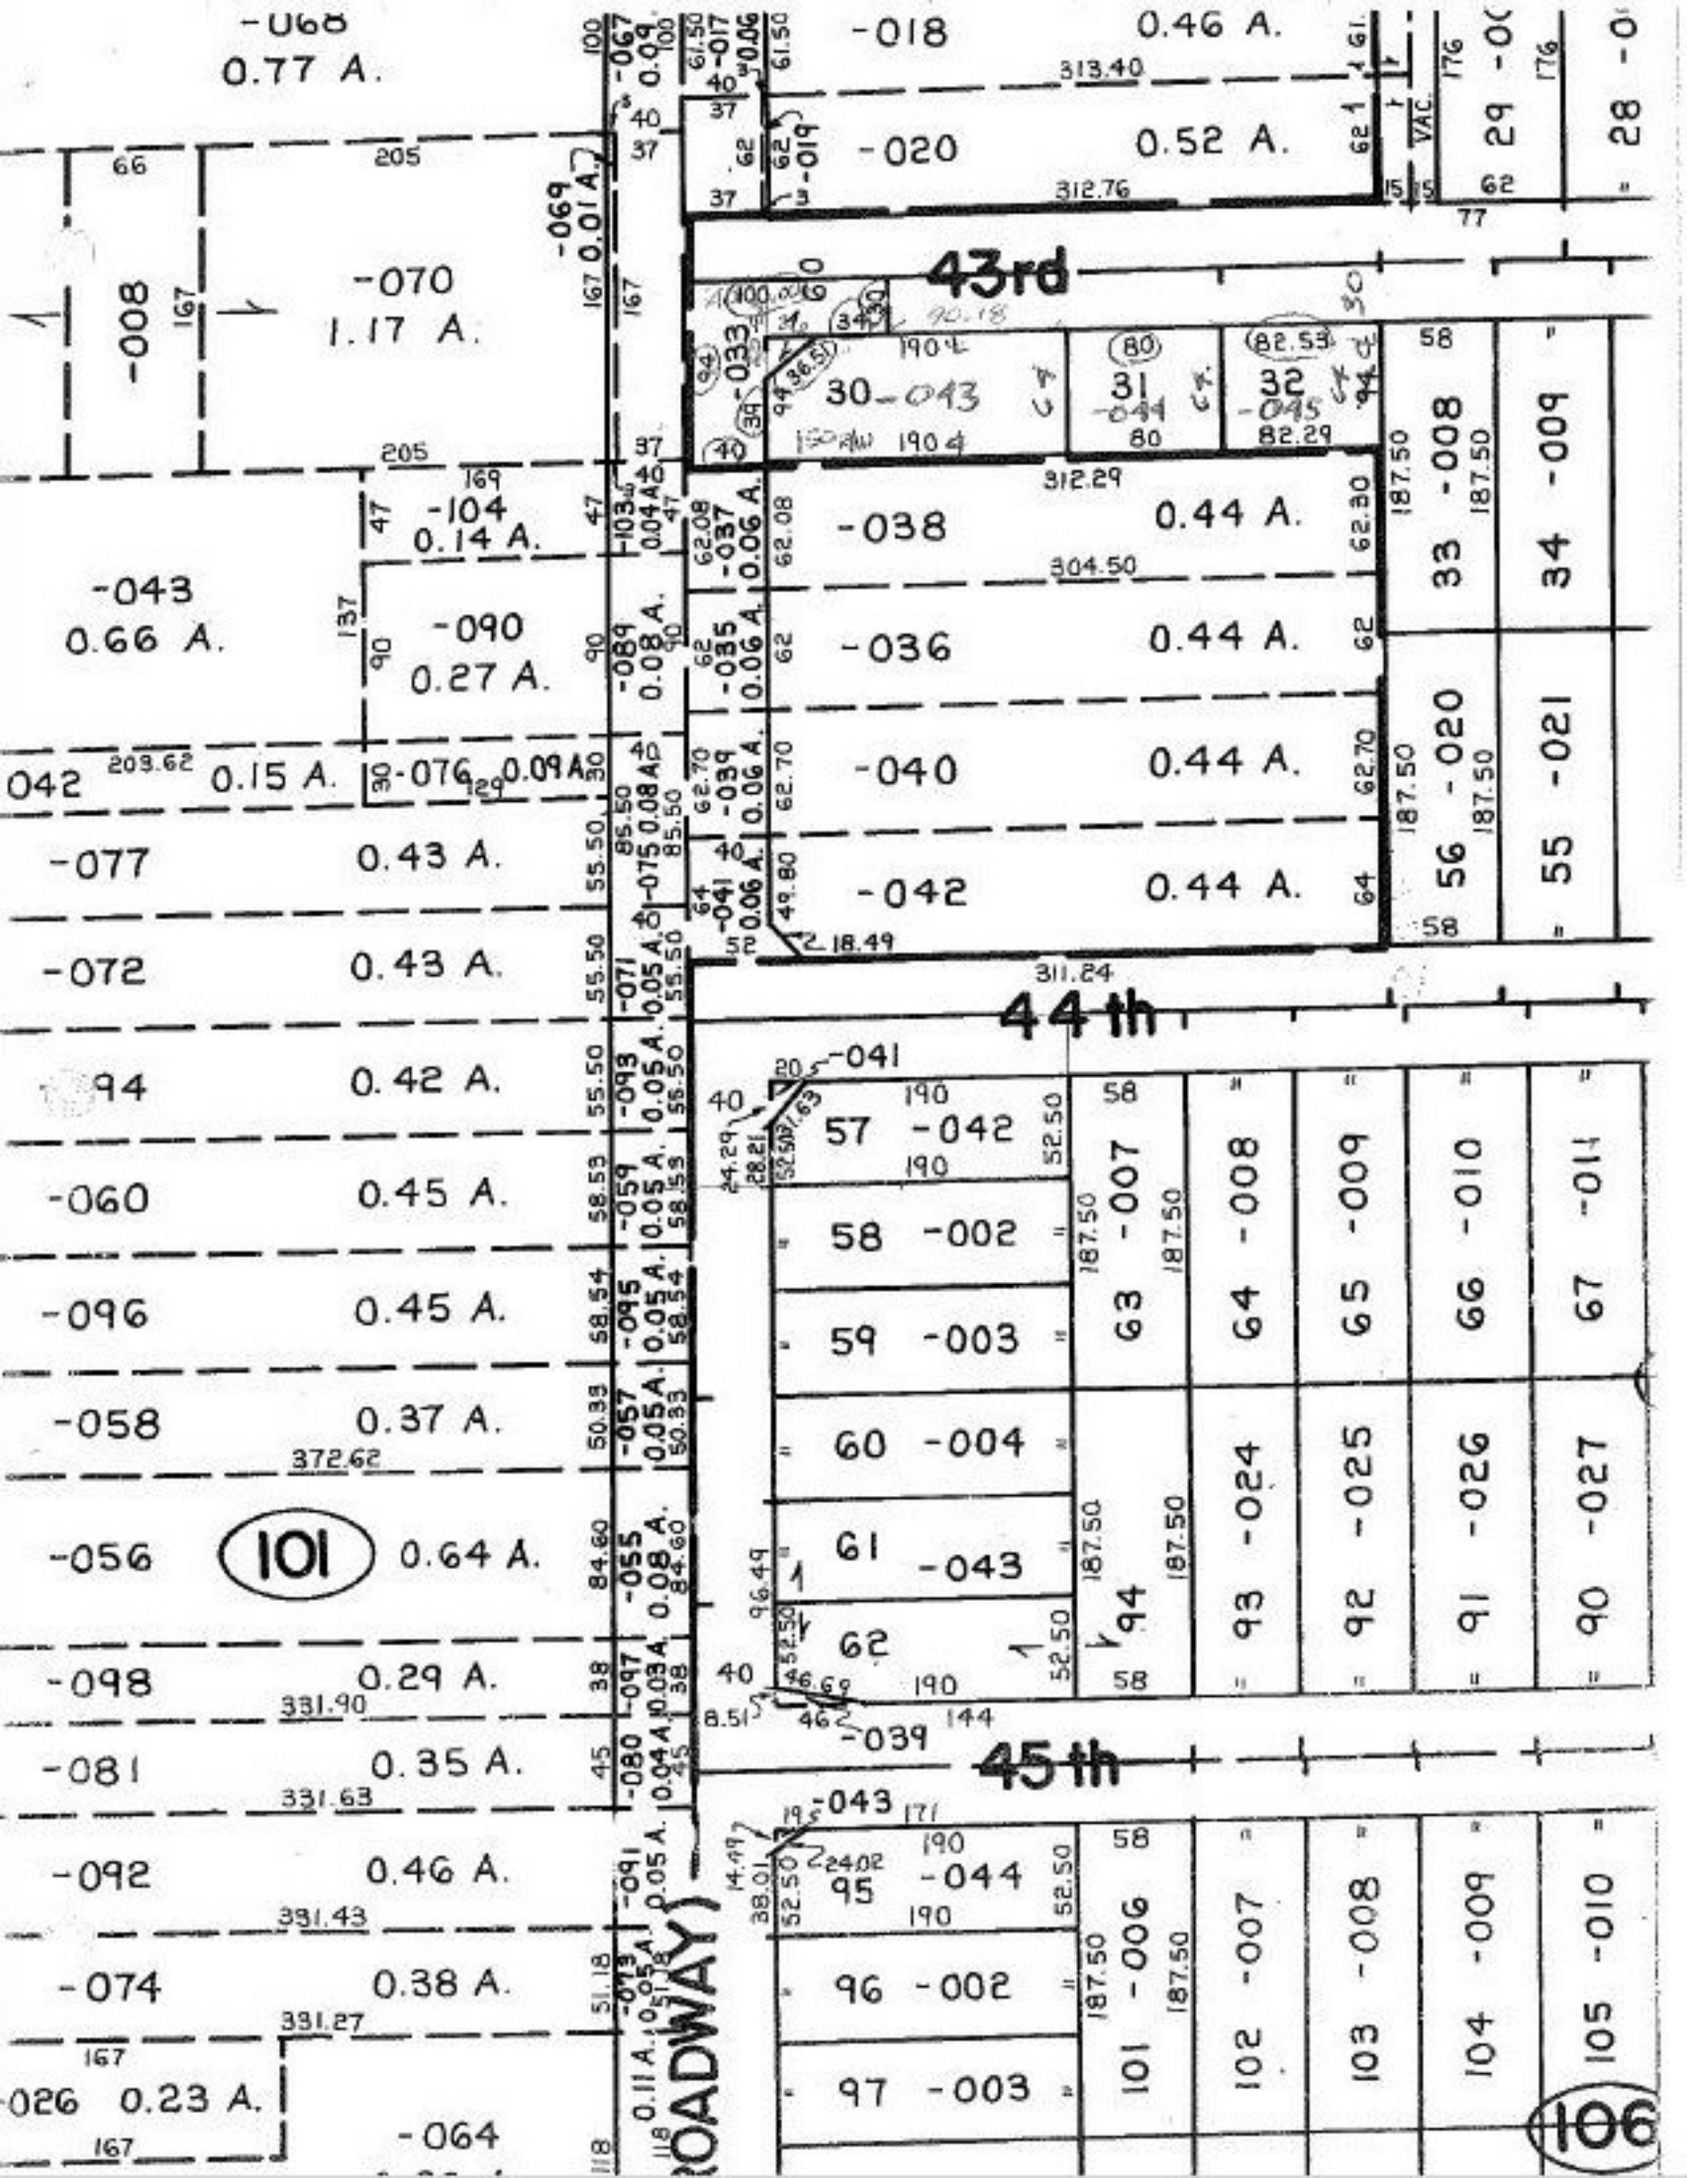

-068
0.77 A.
-018
0.46 A.
313.40
-020
0.52 A.
312.76
VAC.
29 -00
28 -0
-069
0.01 A.
-008
-070
1.17 A.
43rd
30 -043
31 -044
32 -045
-033
-104
0.14 A.
-043
0.66 A.
-090
0.27 A.
-038
0.44 A.
312.29
304.50
-036
0.44 A.
-040
0.44 A.
-042
0.44 A.
33 -008
34 -009
56 -020
55 -021
042
0.15 A.
-076
0.09 A.
-077
0.43 A.
-072
0.43 A.
94
0.42 A.
-060
0.45 A.
-096
0.45 A.
-058
0.37 A.
372.62
-056
101
0.64 A.
-098
0.29 A.
331.90
-081
0.35 A.
331.63
-092
0.46 A.
331.43
-074
0.38 A.
331.27
-026
0.23 A.
-064
ROADWAY)
44th
-041
57 -042
58 -002
59 -003
60 -004
61 -043
62
63 -007
64 -008
65 -009
66 -010
67 -011
94
93 -024
92 -025
91 -026
90 -027
-039
45th
-043
95 -044
96 -002
97 -003
101 -006
102 -007
103 -008
104 -009
105 -010
106