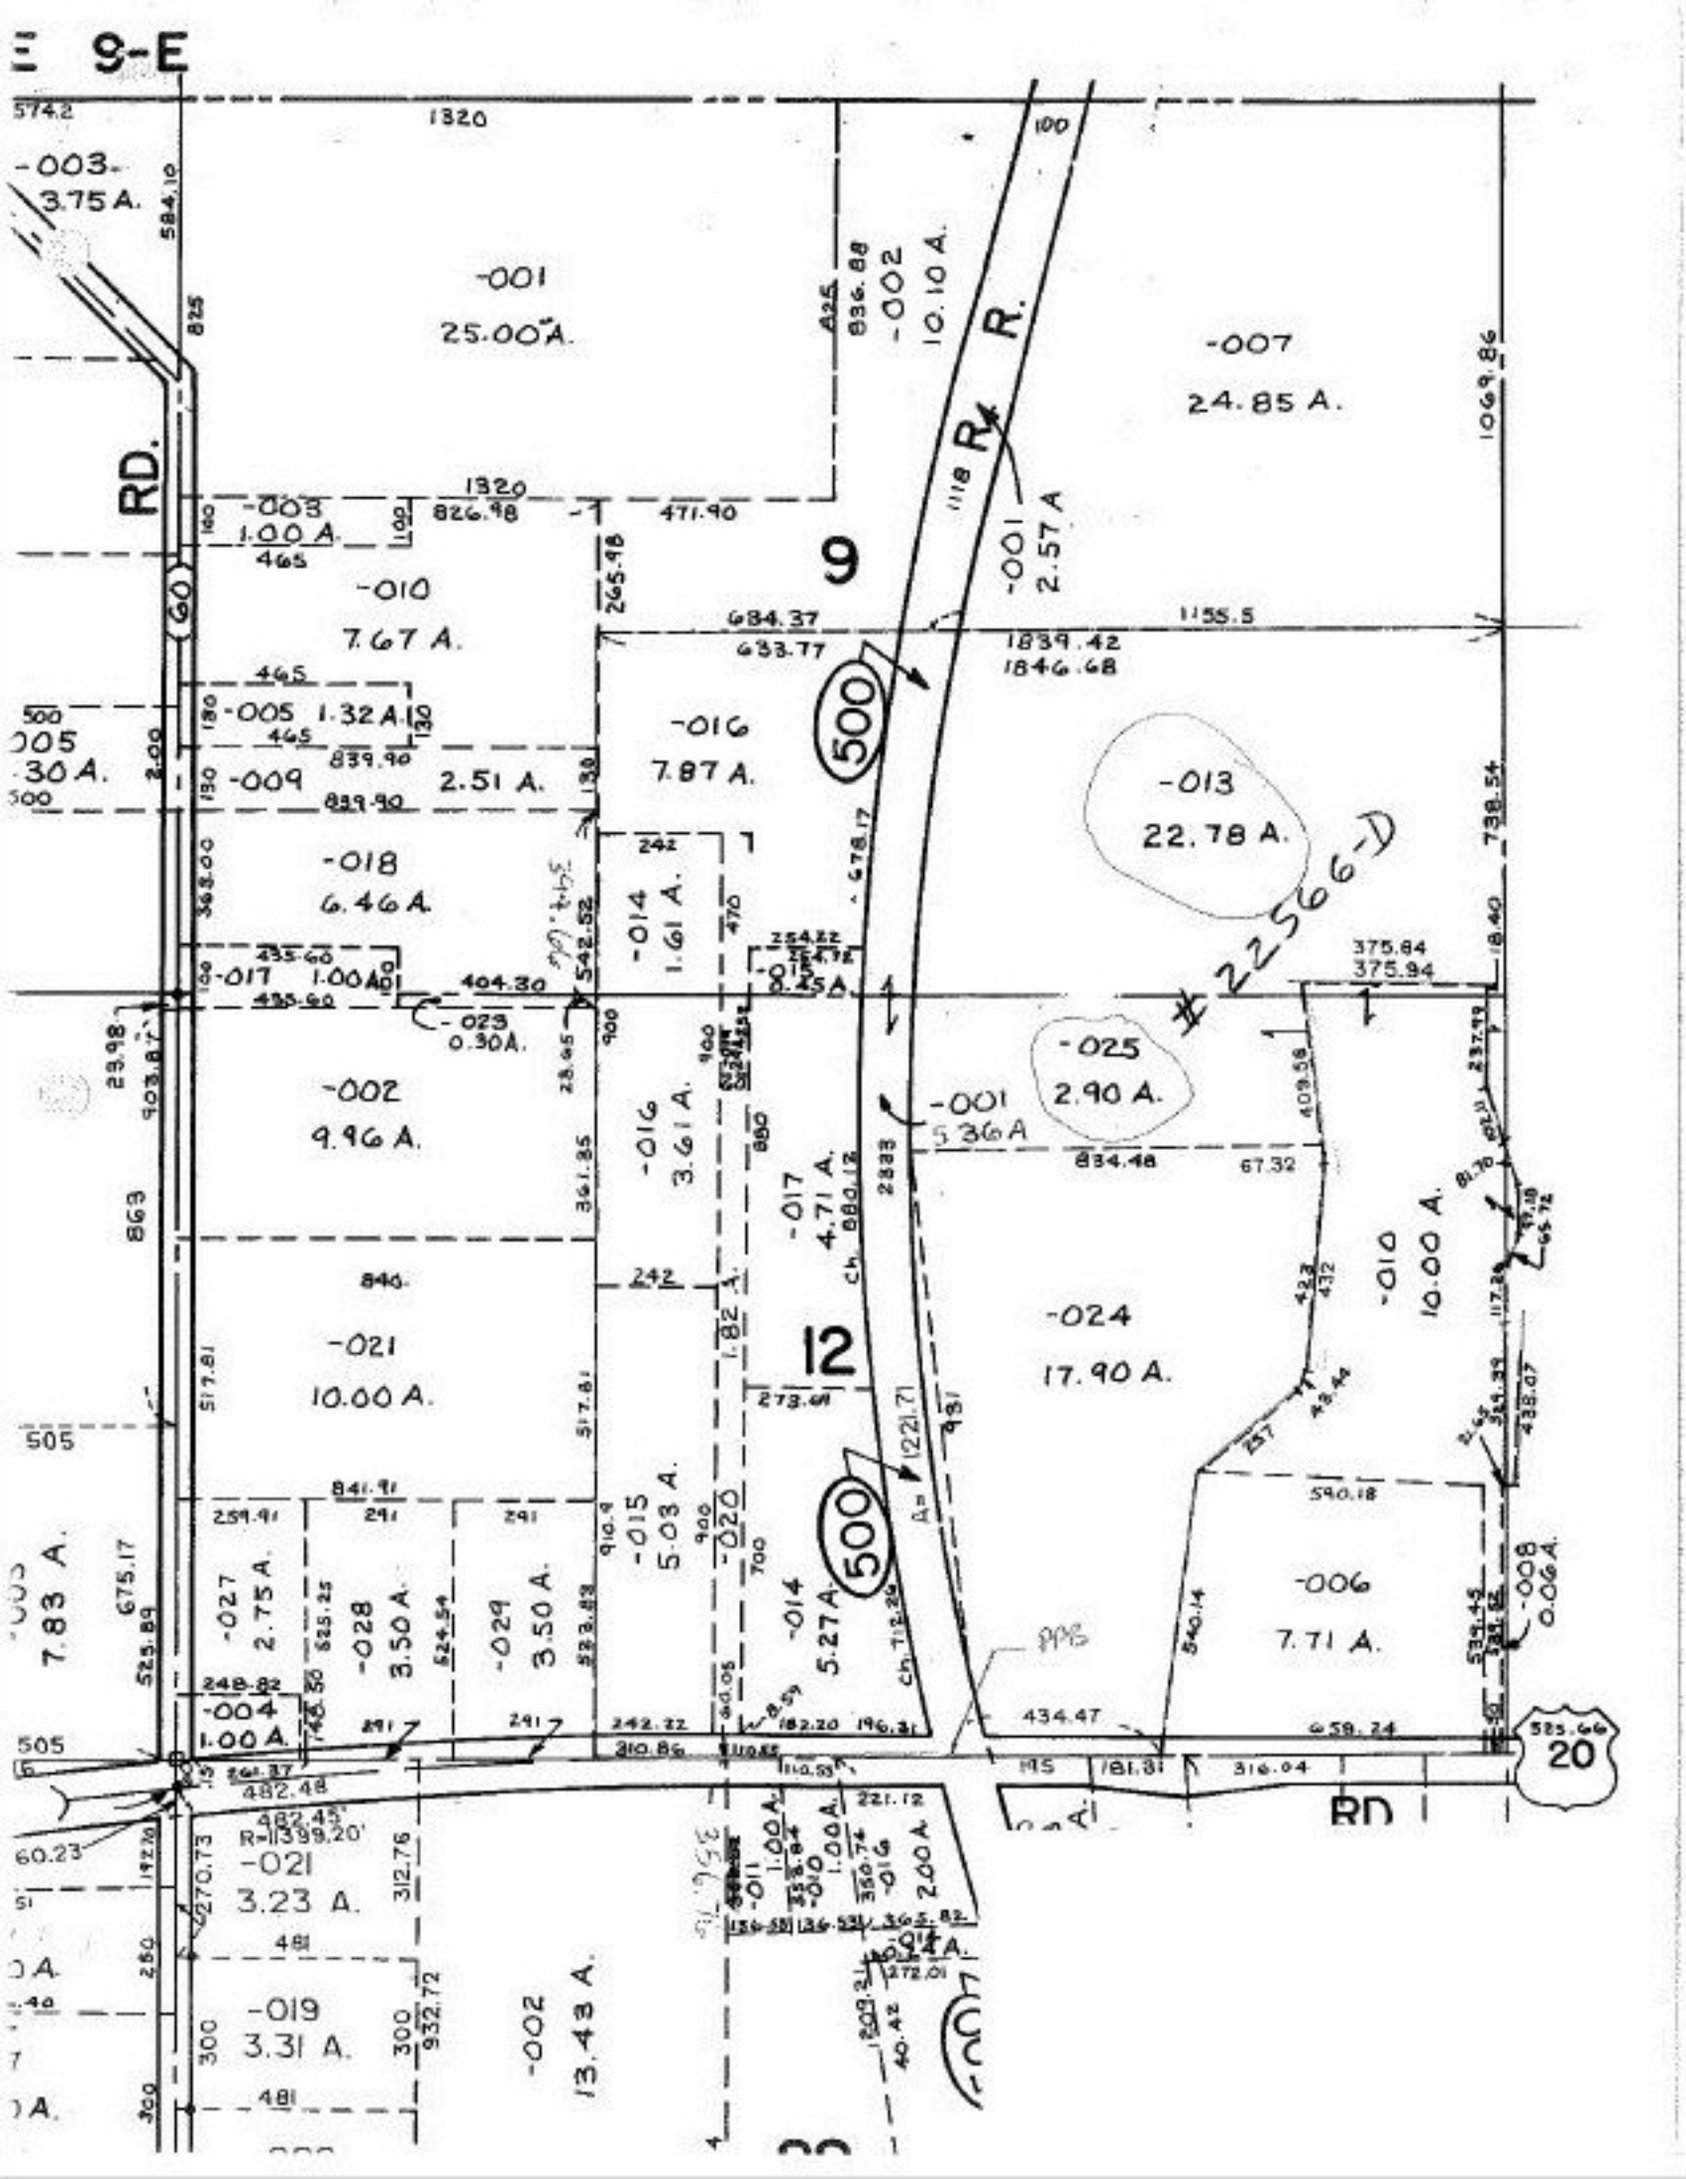
9-E
-003-
3.75 A.
-001
25.00 A.
-002
10.10 A.
-007
24.85 A.
RD.
-003
1.00 A.
-010
7.67 A.
9
-001
2.57 A
R.R.
-005 1.32 A.
-009
2.51 A.
-016
7.87 A.
-013
22.78 A.
-018
6.46 A.
-014
1.61 A.
-017 1.00 A.
-029
0.30 A.
-025
2.90 A.
-002
9.96 A.
-016
3.61 A.
-017
4.71 A.
-001
5.36 A
-010
10.00 A.
-024
17.90 A.
12
-021
10.00 A.
-015
5.03 A.
-020
1.82 A.
-014
5.27 A.
-027
2.75 A.
-028
3.50 A.
-029
3.50 A.
-004
1.00 A.
-006
7.71 A.
-008
0.06 A.
7.83 A.
-021
3.23 A.
-019
3.31 A.
-002
13.43 A.
-011
1.00 A.
-010
1.00 A.
-016
2.00 A.
-014
0.24 A.
RD
20