PARENT PARCEL: 10-00-017-000-044

CHILD PARCEL: 10-00-017-000-045 THRU -047

STARTING POINT: C/L SLIFE ROAD & E.LINE O.L.18 (W.LINE O.L.17)

NO. 22566

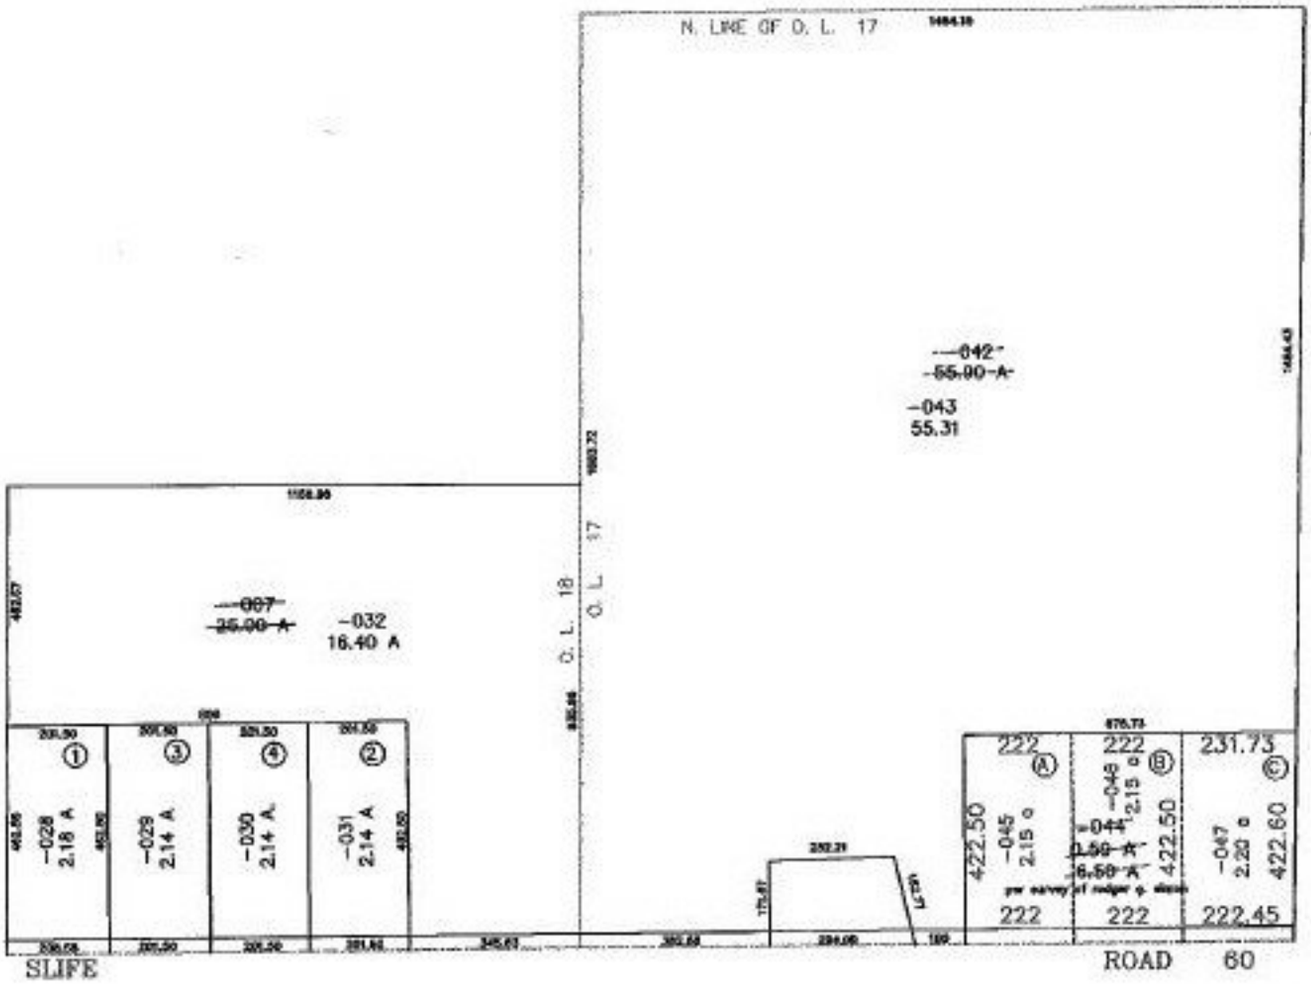

6/21/99

SPLITS/DEEDS PROCESSED

LORAIN COUNTY TAX MAP DEPARTMENT

226 MIDDLE AVE. ELYRIA, OHIO

SURVEYED BY: RODGER G. SIMON

CLOSURE: 0.009 PER 10,000

MAP PAGE(S): 10-G

APPROVED BY: F.COLBERT DATE: 6/24/98

SCALE: 1"= 400 PRIOR INSTRUMENT: 980510011