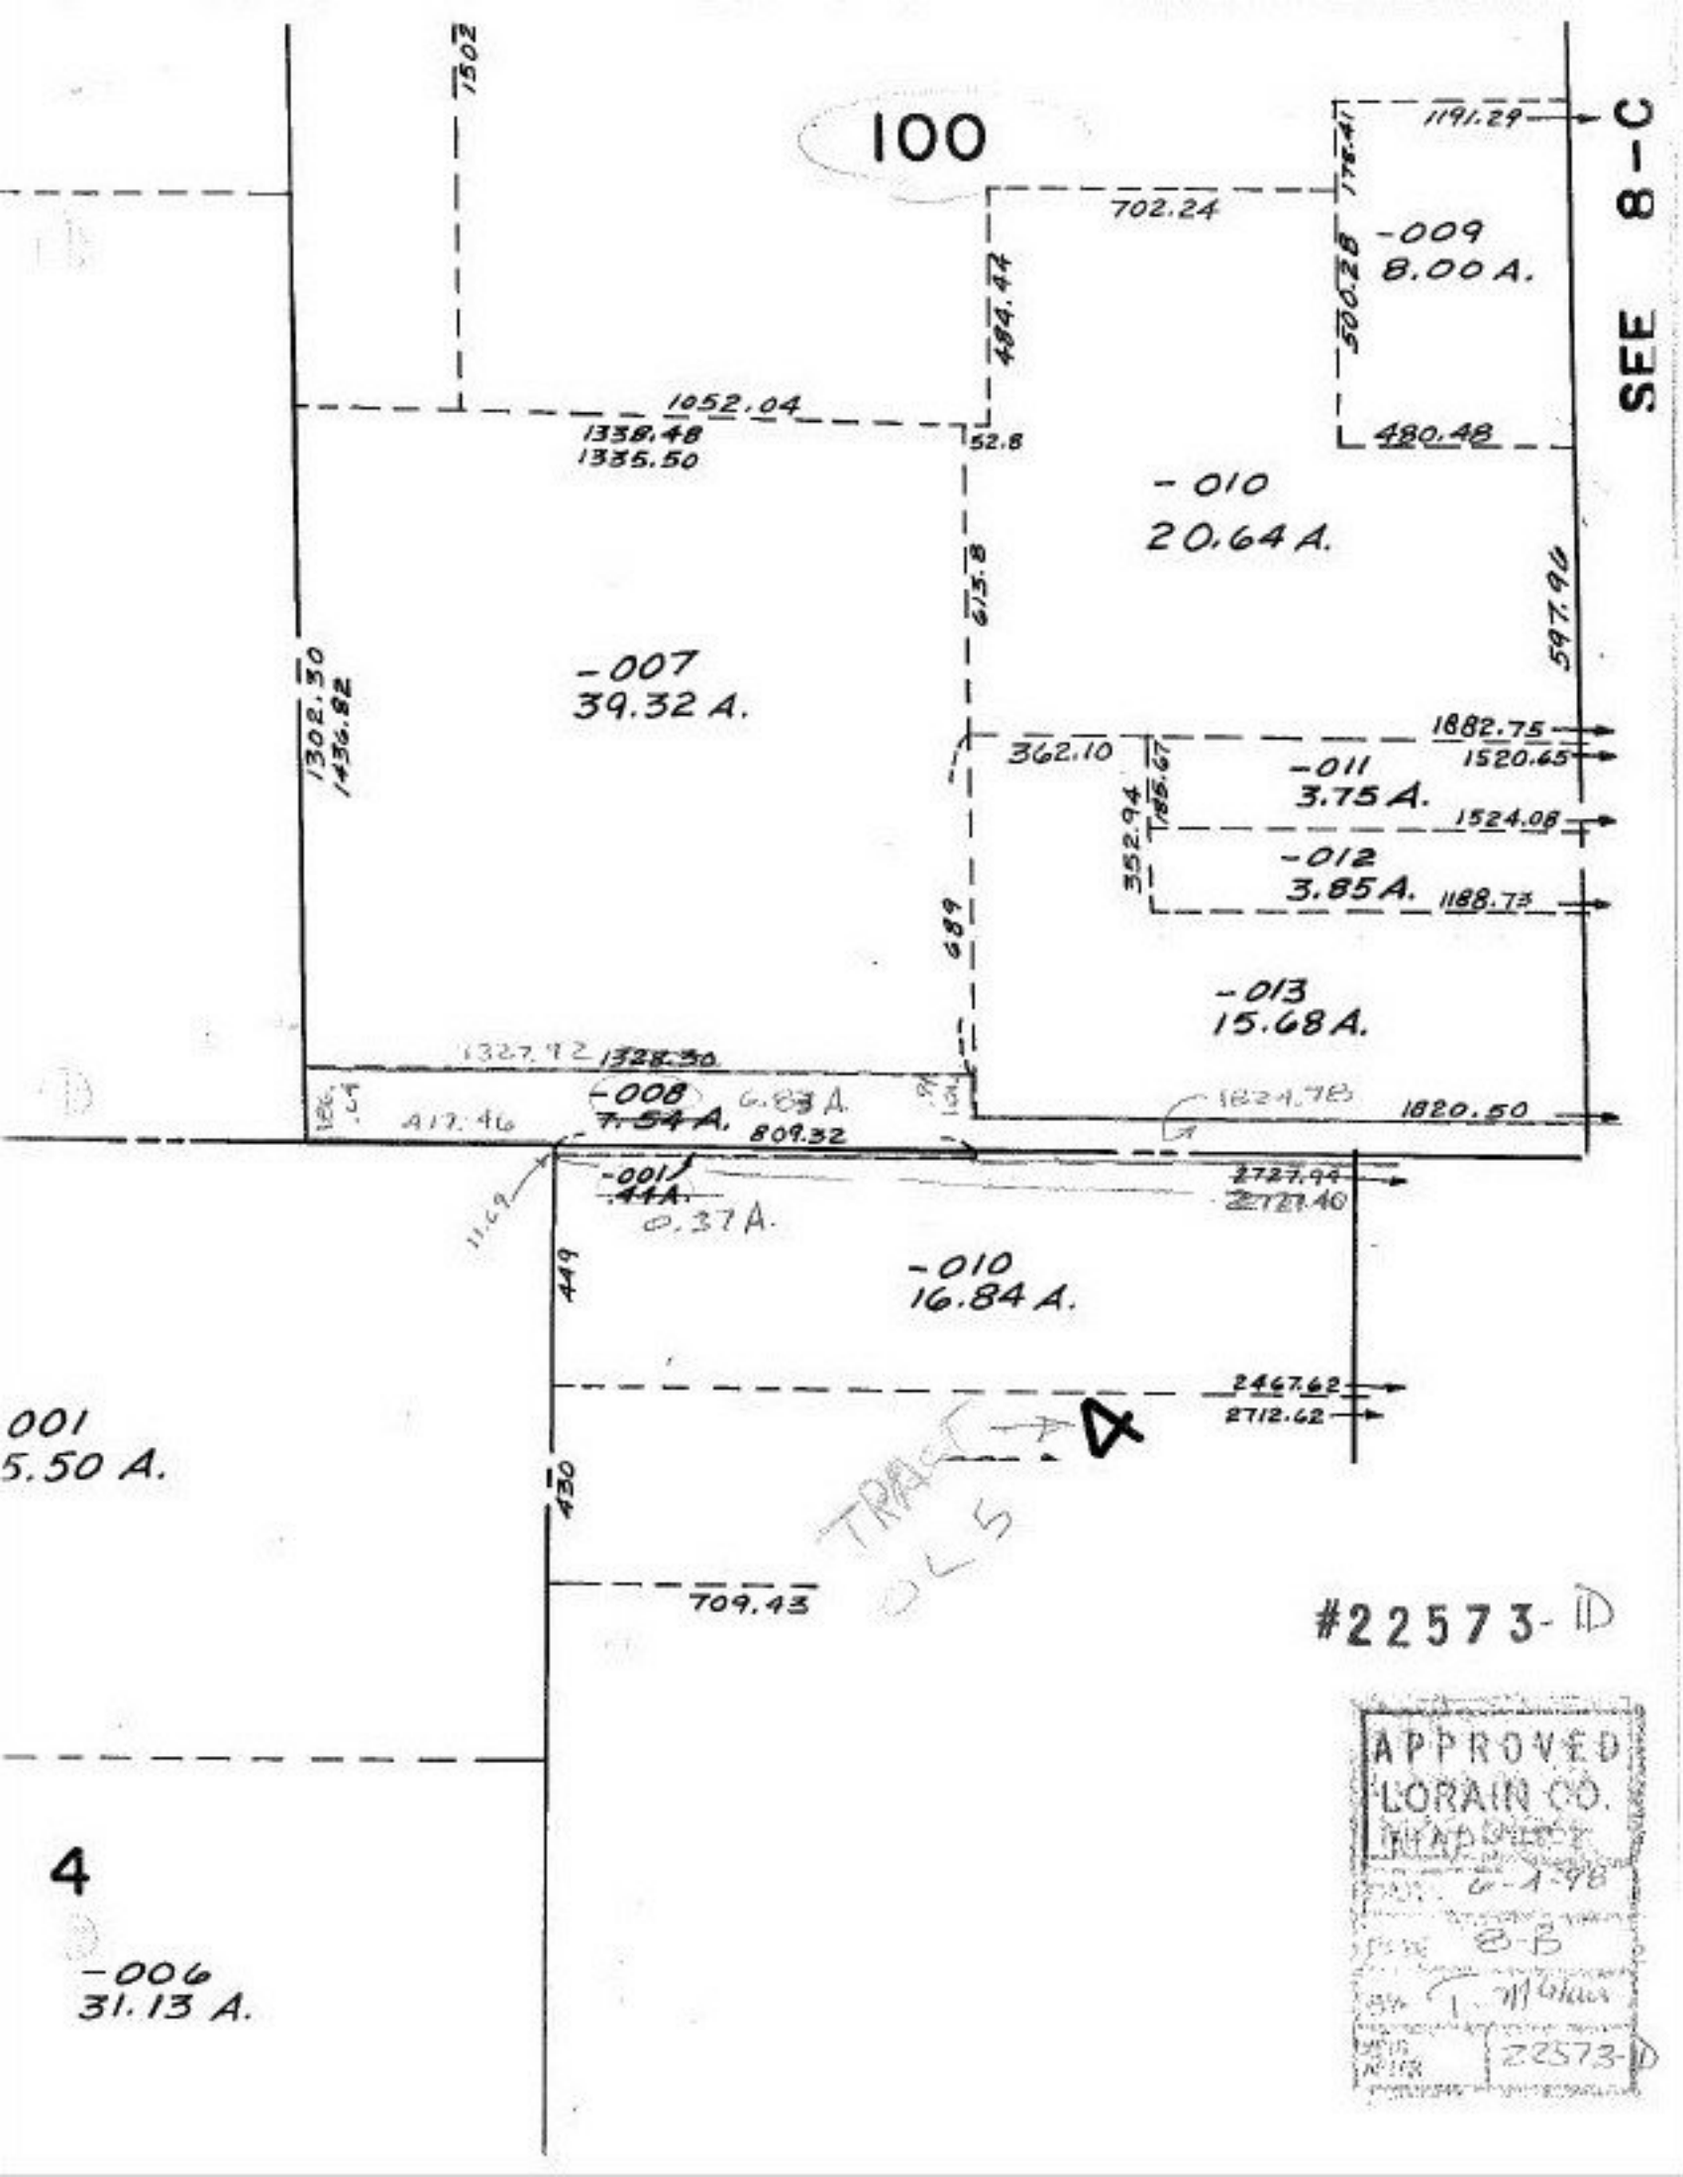
100
1502
1191.29
702.24
484.44
-009
8.00 A.
480.48
SEE 8-C
1052.04
1338.48
1335.50
52.8
-010
20.64 A.
615.8
597.90
1302.30
1436.82
-007
39.32 A.
1882.75
1520.65
362.10
-011
3.75 A.
1524.08
352.94
-012
3.85 A.
1188.73
689
-013
15.68 A.
1327.92
1328.30
-008
7.54 A.
6.83 A.
809.32
1824.78
1820.50
-001
.44A.
0.37 A.
2727.94
2727.40
-010
16.84 A.
449
2467.62
2712.42
001
5.50 A.
430
709.43
4
-006
31.13 A.
#22573-D
APPROVED
LORAIN CO.