PARENT PARCEL: 09-00-088-105-035

CHILD PARCEL: 09-00-088-105-045, 046, 047

STARTING POINT: RR SPIKE IN C/Ls EAST COLLEGE ST. & OBERLIN ROAD

NO. 22573

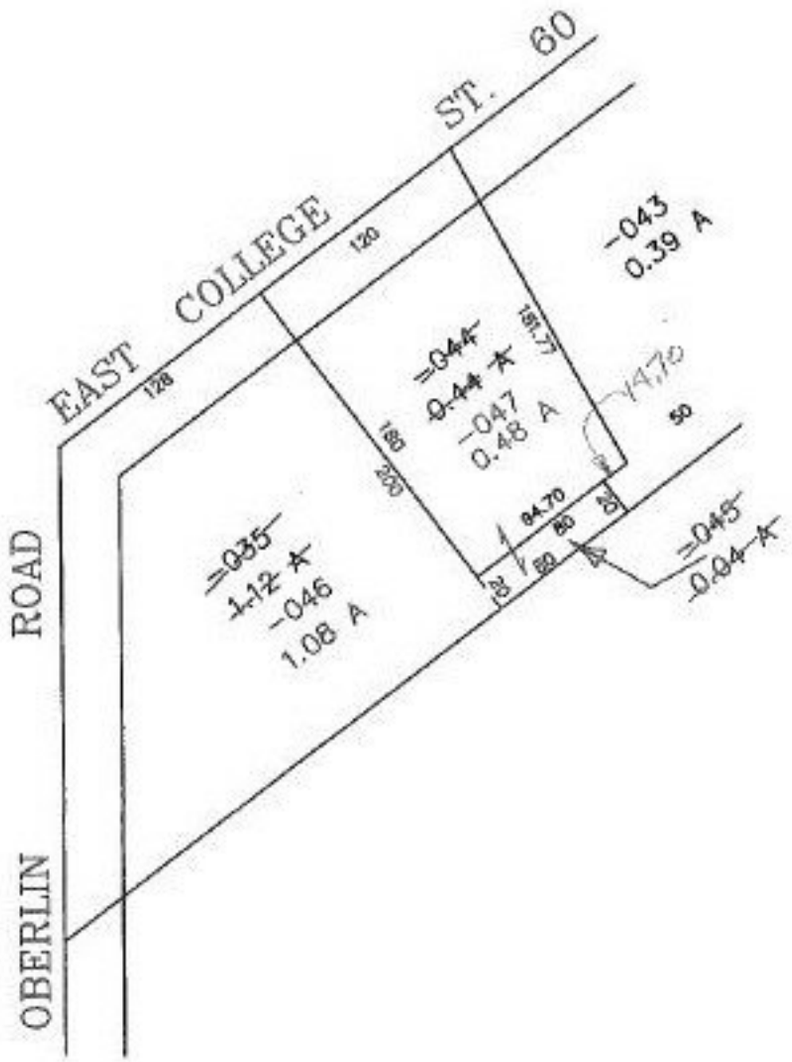

SPLITS/DEEDS PROCESSED

LORAIN COUNTY TAX MAP DEPARTMENT
226 MIDDLE AVE. ELYRIA, OHIO

SURVEYED BY: ROGGER G SIMON

CLOSURE: 0.003 PER 10,000

MAP PAGE(S): 9-00-088-A

APPROVED BY: F. COLBERT DATE: 7/1/98

SCALE: 1"= 100 PRIOR INSTRUMENT: DV XXXX/XXX

6/21/99