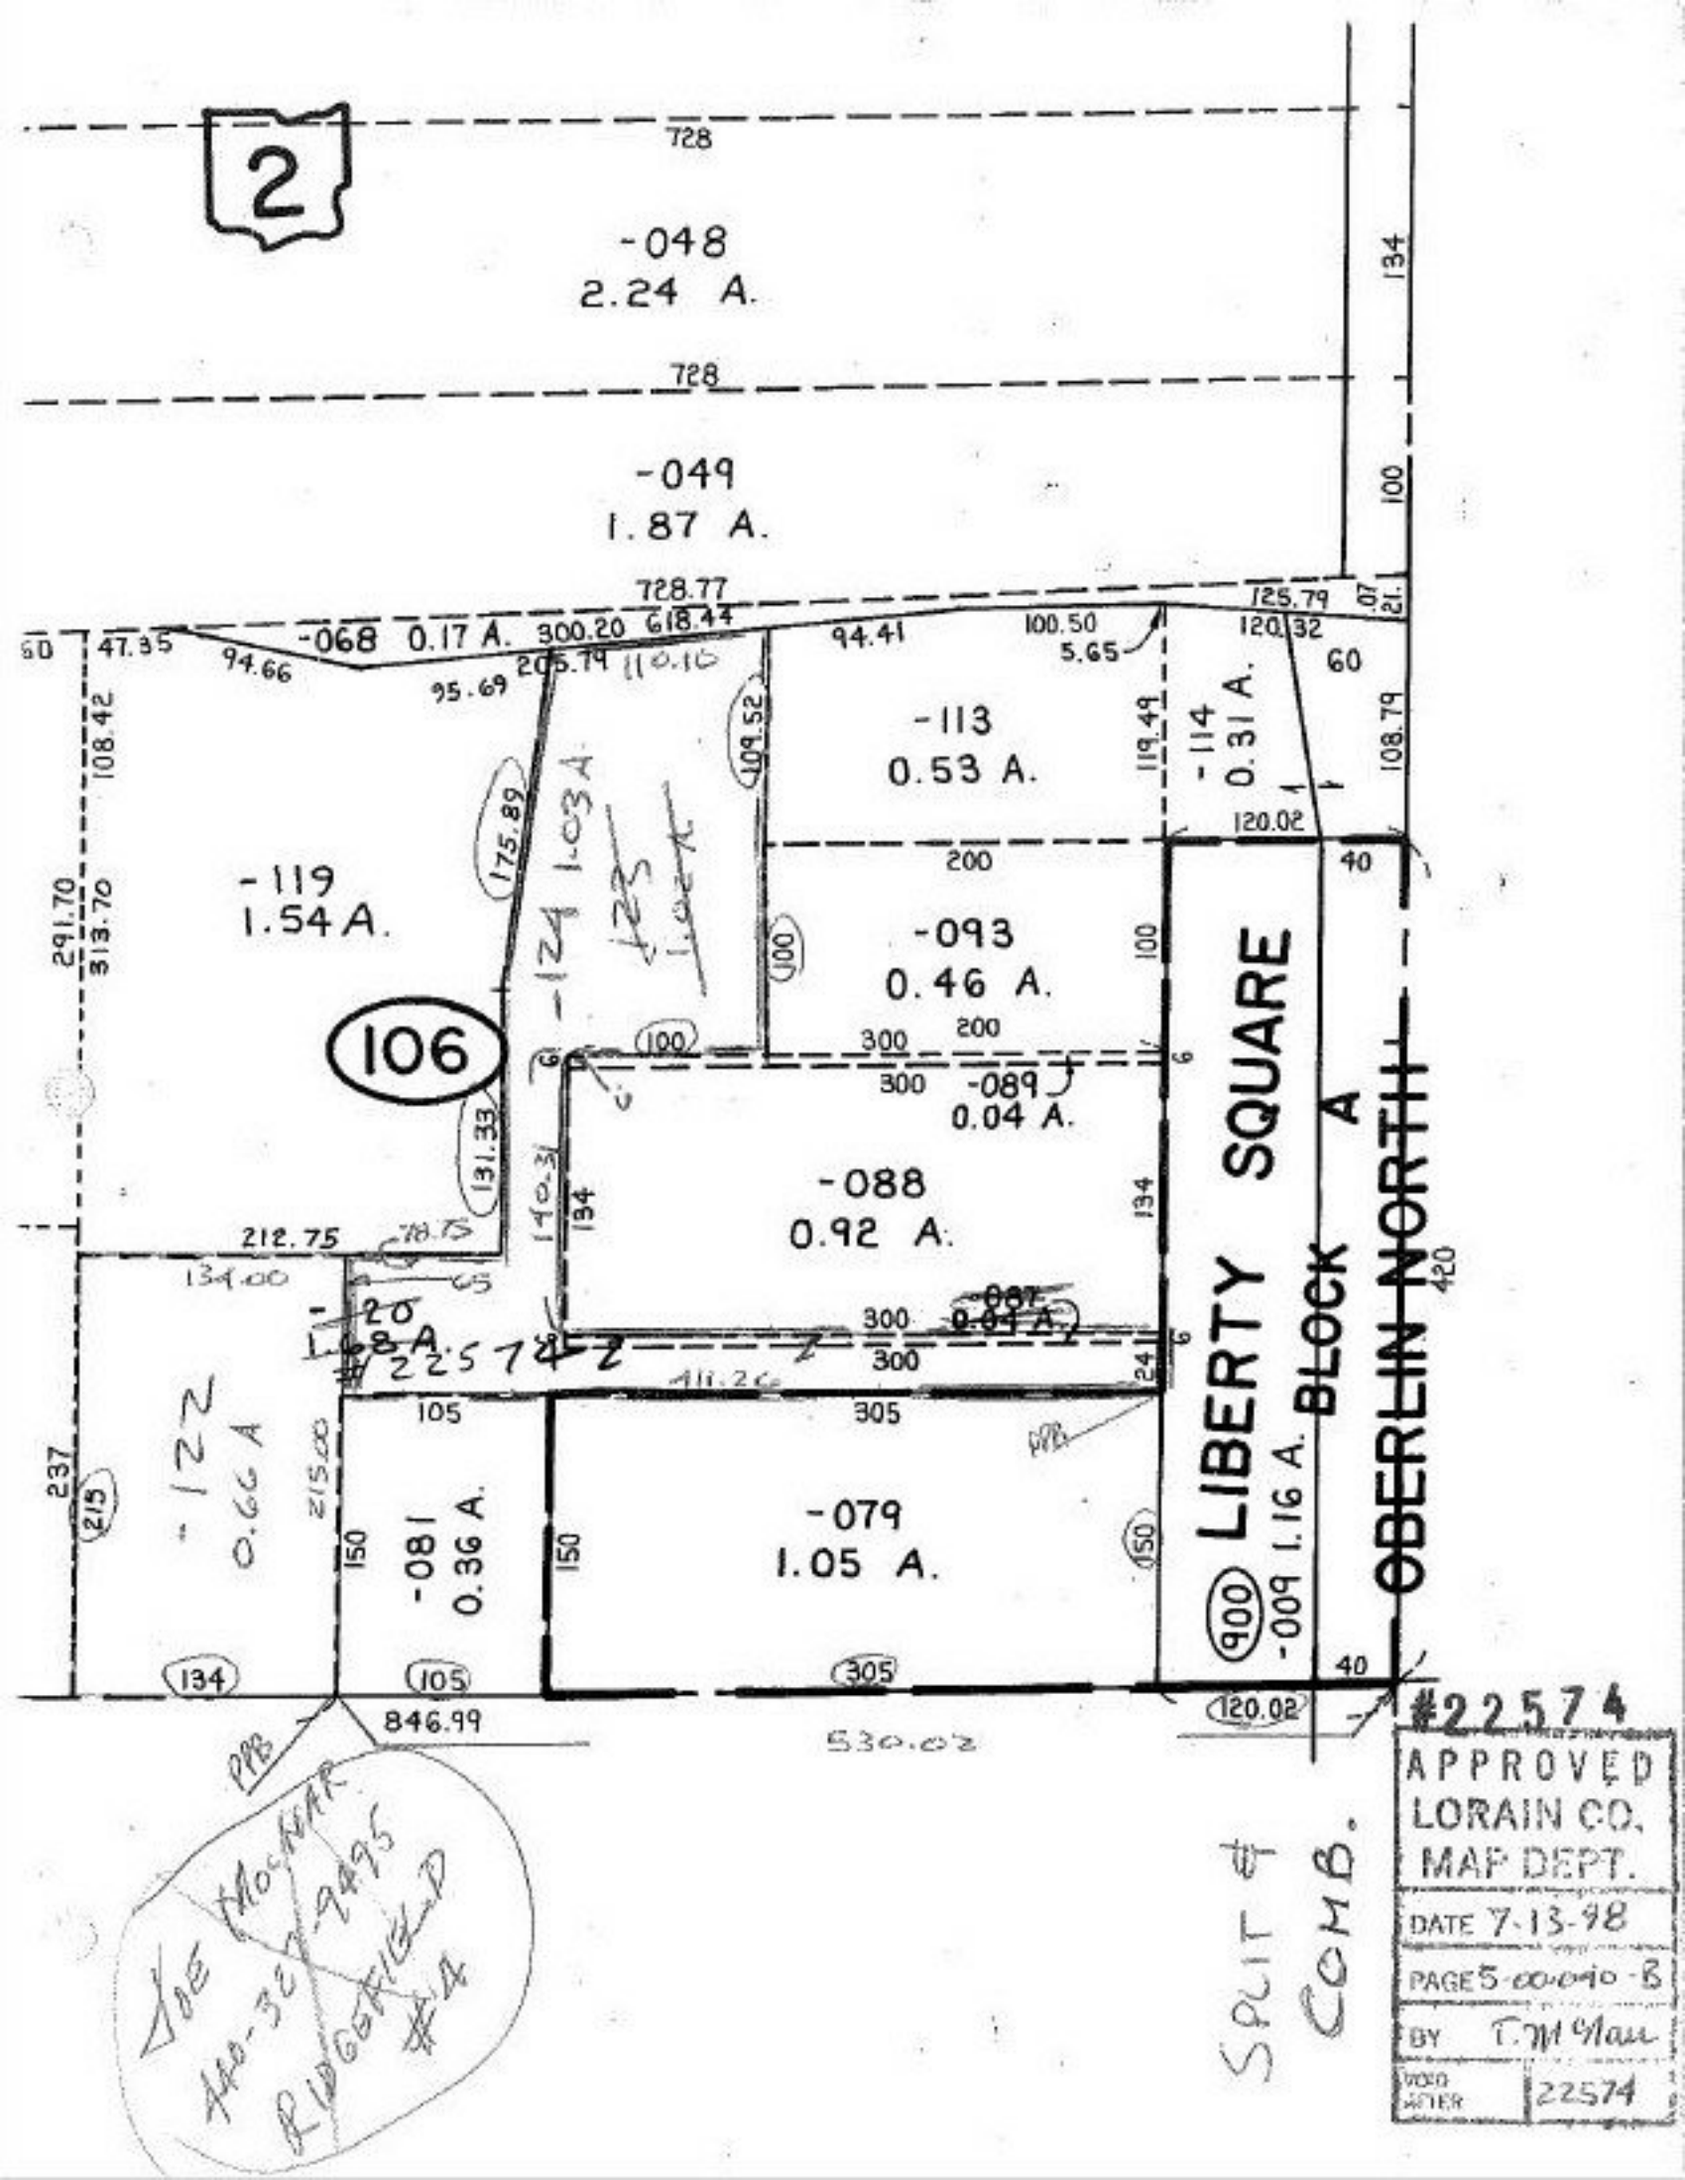
2
728
-048
2.24 A.
728
-049
1.87 A.
728.77
-068 0.17 A.
300.20
618.44
125.79
94.41
100.50
5.65
120.32
60
47.35
94.66
205.79
110.16
95.69
108.42
291.70
313.70
-119
1.54 A.
175.89
-124 1.03 A.
109.52
-113
0.53 A.
119.49
-114
0.31 A.
108.79
120.02
200
40
106
100
-093
0.46 A.
300
200
-089
0.04 A.
131.33
140.31
134
-088
0.92 A.
212.75
78.75
134.00
65
-120
1.68 A.
#22574
300
-087
0.04 A.
411.26
105
305
237
215
-122
0.66 A
215.00
150
-081
0.36 A.
-079
1.05 A.
LIBERTY SQUARE
BLOCK A
OBERLIN NORTH
900
-009 1.16 A.
420
134
105
305
40
846.99
530.02
120.02
PBB
#22574
APPROVED
LORAIN CO.
MAP DEPT.
DATE 7-13-98
PAGE 5-00-090-B
BY T.M Nau
VOID AFTER 22574
SPLIT & COMB.
Joe Mosmar
440-327-9495
Ridgefield #4