PARENT PARCEL: 07-00-009-116-052

CHILD PARCEL: 07-00-009-116-081 & 082

STARTING POINT: MON. AT CL OF FLORALINE AVE. & CL OF JEFFERSON AVE.

NO. 22585

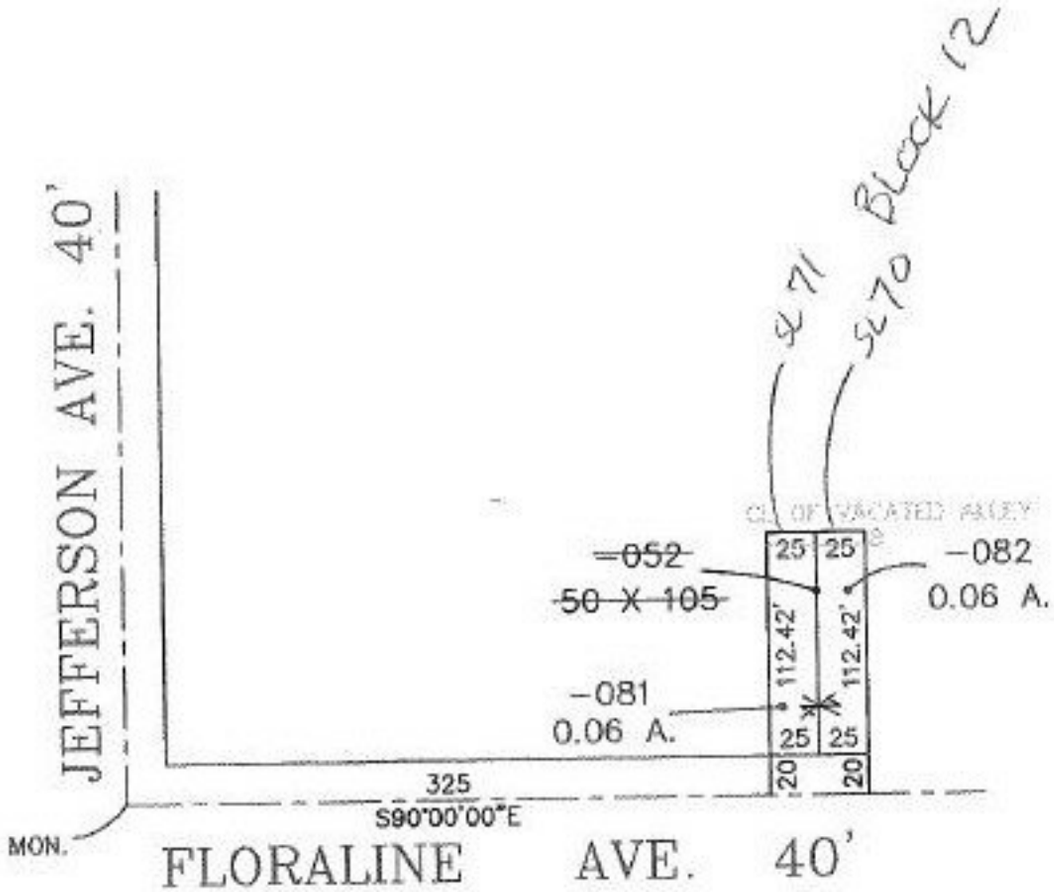

SPLITS/DEEDS PROCESSED

LORAIN COUNTY TAX MAP DEPARTMENT

226 MIDDLE AVE. ELYRIA, OHIO

SURVEYED BY: DANE HAPONEK

CLOSURE: 0.00 : 10,000

MAP PAGE(S): 07-00-009-B

APPROVED BY: TJS DATE: 07/13/98

SCALE: 1"= 100 PRIOR INSTRUMENT: 980513256