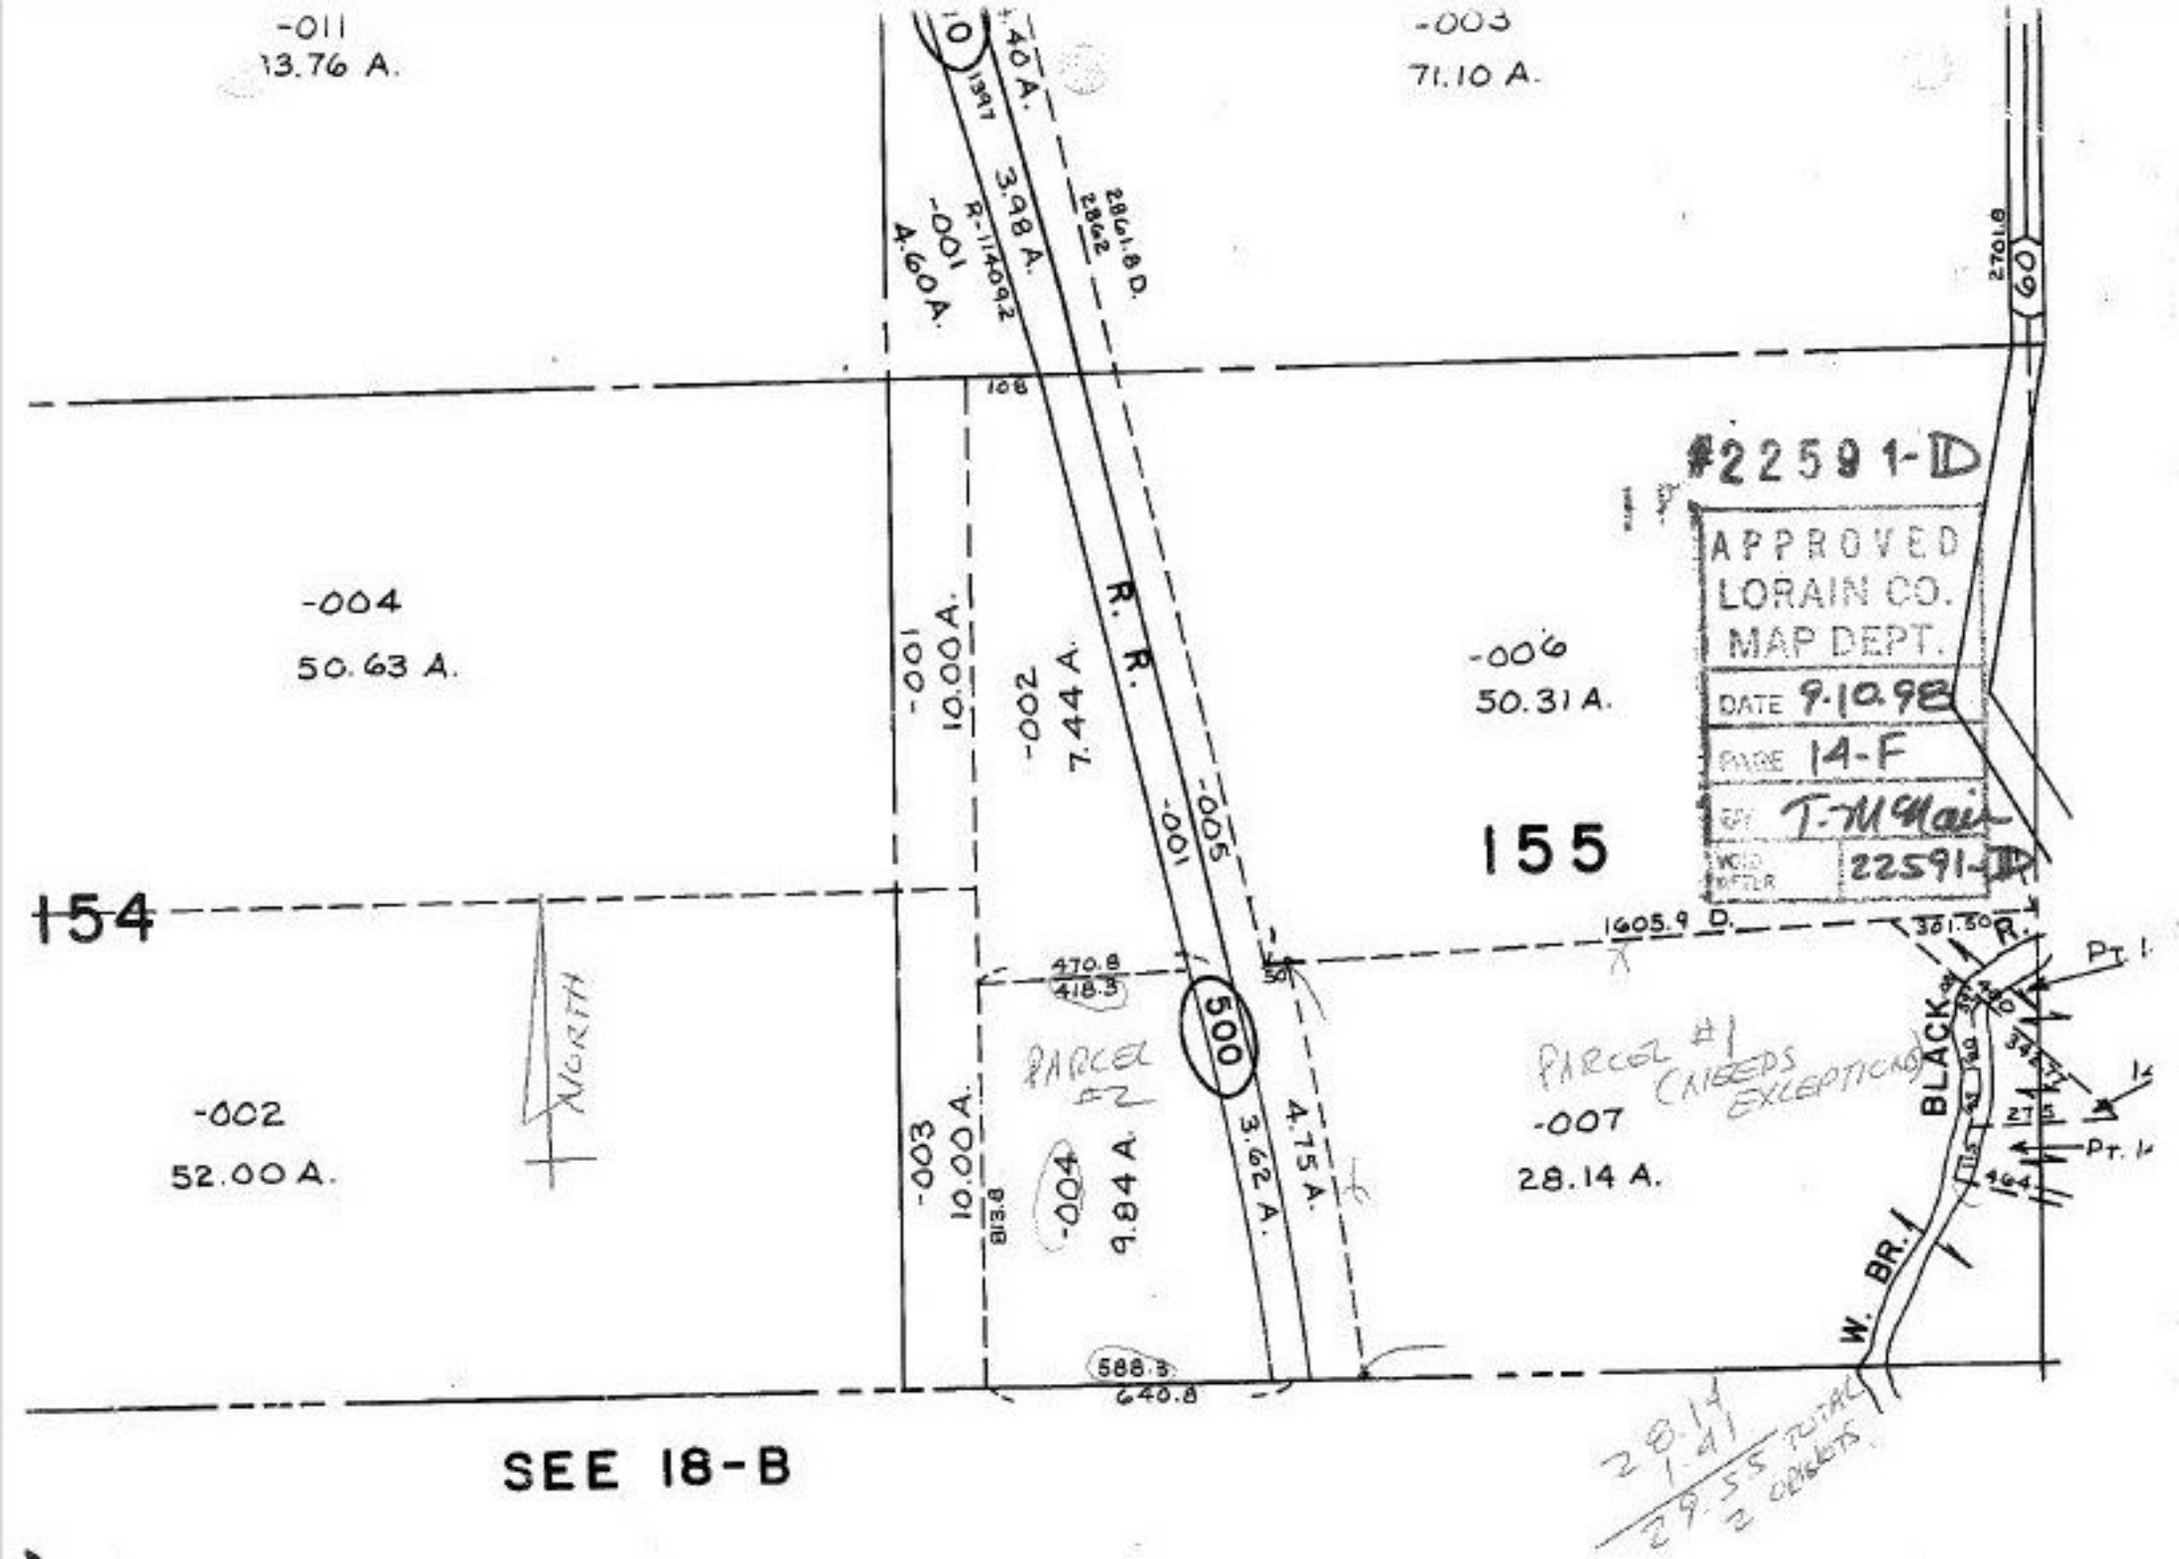

LOTS 86,87,88,93,94,95,106,107,108,113,114,115,

14-F