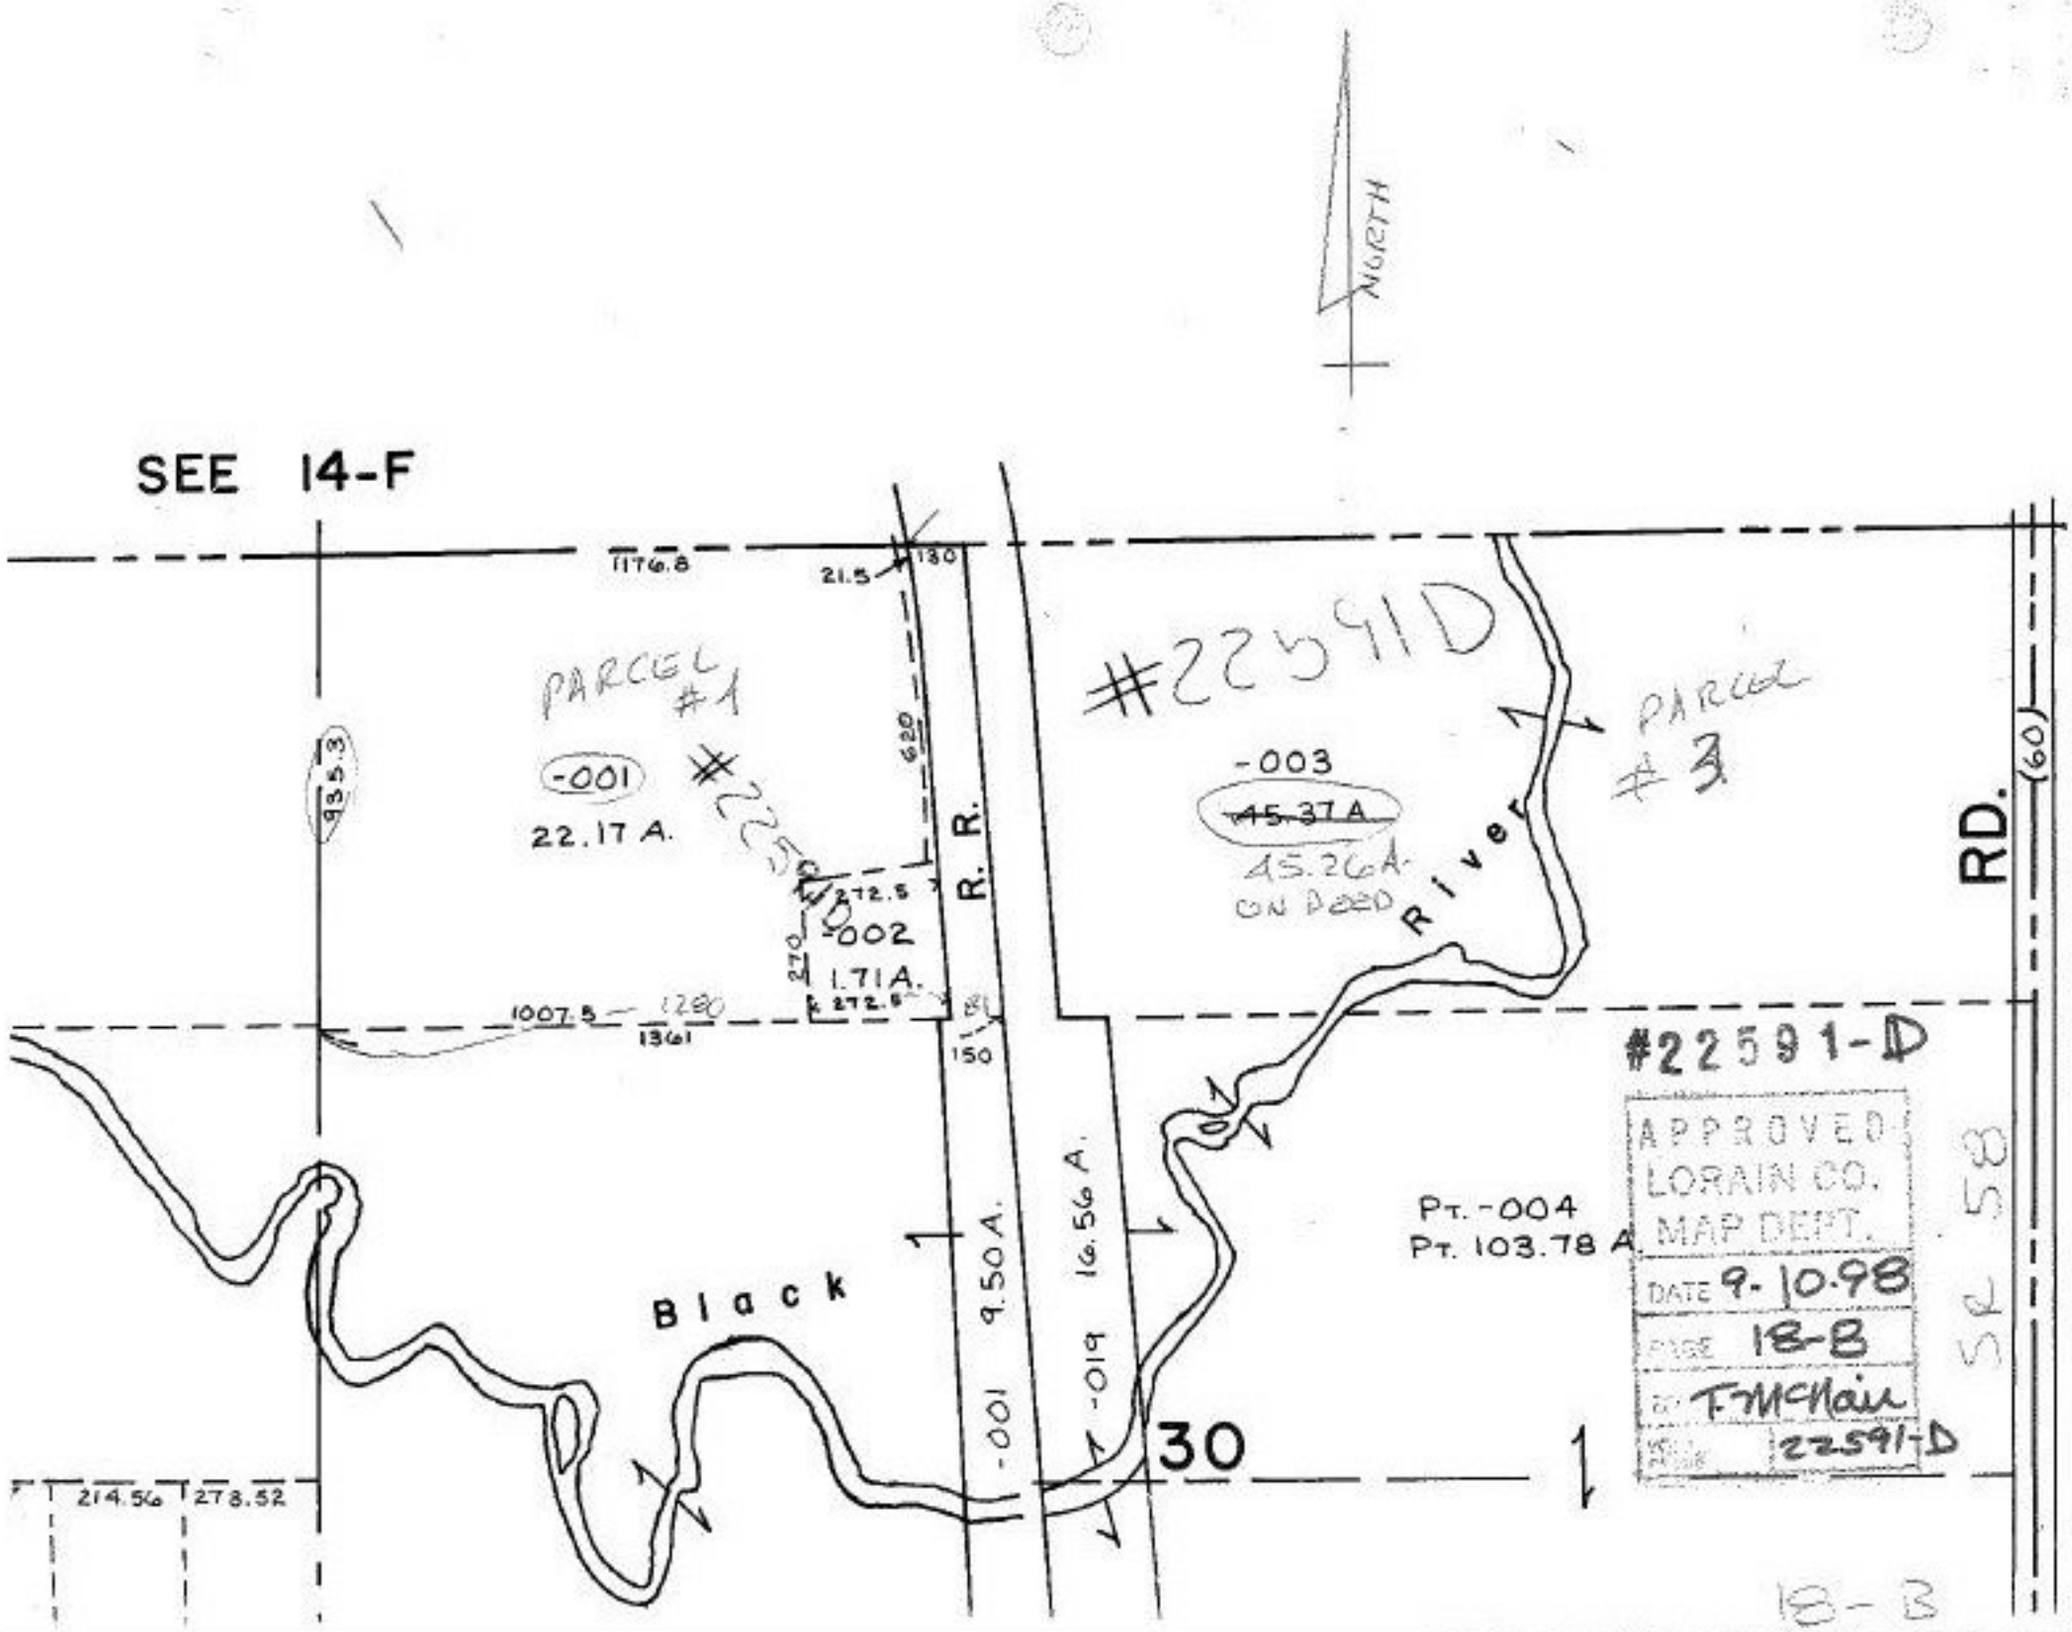
NORTH
SEE 14-F
1176.8
21.5
130
PARCEL #1
-001
22.17 A.
#22591D
935.3
620
R. R.
-003
~~45.37 A~~
45.26 A.
ON D22D
PARCEL #3
River
272.5
-002
1.71 A.
270
1007.5
1280
1361
80
150
#22591-D
APPROVED
LORAIN CO.
MAP DEPT.
DATE 9-10-98
PAGE 18-B
BY T. McNair
22591-D
Pt. -004
Pt. 103.78 A
Black
9.50 A.
16.56 A.
-001
-019
30
214.56
278.52
RD.
(60)
SR 58
18-B