#22593

NO. 22593

STARTING POINT: CL OF DAVID DR. & CL OF WEST RIVER RD.
STARTING POINT: SOUTH ROW OF DAVID DR. & WEST ROW OF WEST RIVER RD.
PARENT PARCEL: 06-24-029-101-035, 045, 047
PARENT PARCEL: 06-24-029-102-001 THRU 017, & -021 THRU -032 PLAT VACATION
PARENT PARCEL: 06-24-029-103-001 THRU 005, & -007 THRU -012, & -014 THRU 016 PLAT VACATION
PARENT PARCEL: 06-24-028-119-001 THRU 007, -012 & -013 PLAT VACATION
PARENT PARCEL: 06-24-028-119-015, & 017
CHILD PARCEL: 06-24-029-101-056 THRU 059, & 06-24-029-101-063 THRU -076
CHILD PARCEL: 06-24-028-119-018 THRU 022

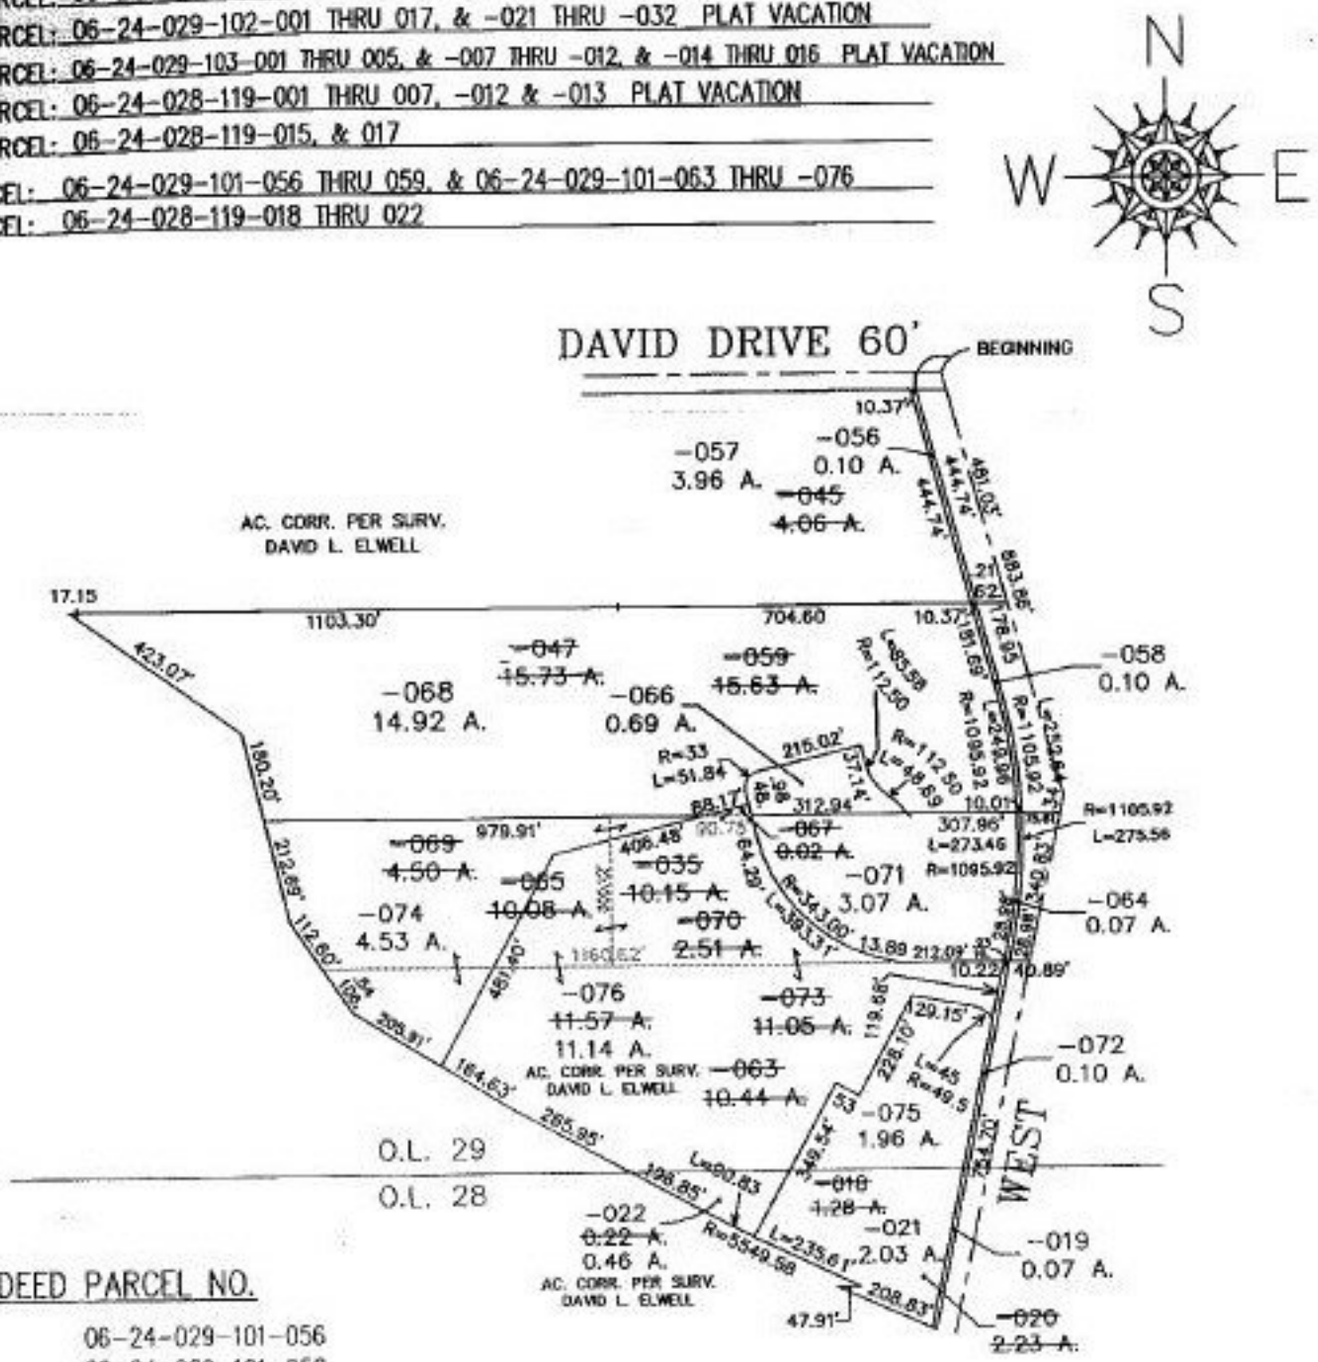

DEED PARCEL NO.

DEED #1	06-24-029-101-056
DEED #2	06-24-029-101-058
DEED #3	06-24-029-101-066
DEED #4	06-24-029-101-067
DEED #5	06-24-029-101-072, & 06-24-028-119-019
DEED #6	06-24-029-101-069, & -070
DEED #7	06-24-029-101-075, & 06-24-028-119-021
DEED #8	06-24-029-101-076, & 06-24-028-119-022
DEED #9	06-24-029-101-064

SPLITS/DEEDS PROCESSED
LORAIN COUNTY TAX MAP DEPARTMENT
226 MIDDLE AVE. ELYRIA, OHIO

SURVEYED BY: DAVID L. ELWELL
CLOSURE: 0.27 : 10,000
MAP PAGE(S): 6-65
APPROVED BY: TJS DATE: 08/18/98
SCALE: 1"= 400 PRIOR INSTRUMENT: OV 343/569