PARENT PARCEL: 12-00-100-000-013

CHILD PARCEL: 12-00-100-000-016, 017

STARTING POINT: C/Ls ROOT ROAD & HAWKE ROAD

NO. 22595

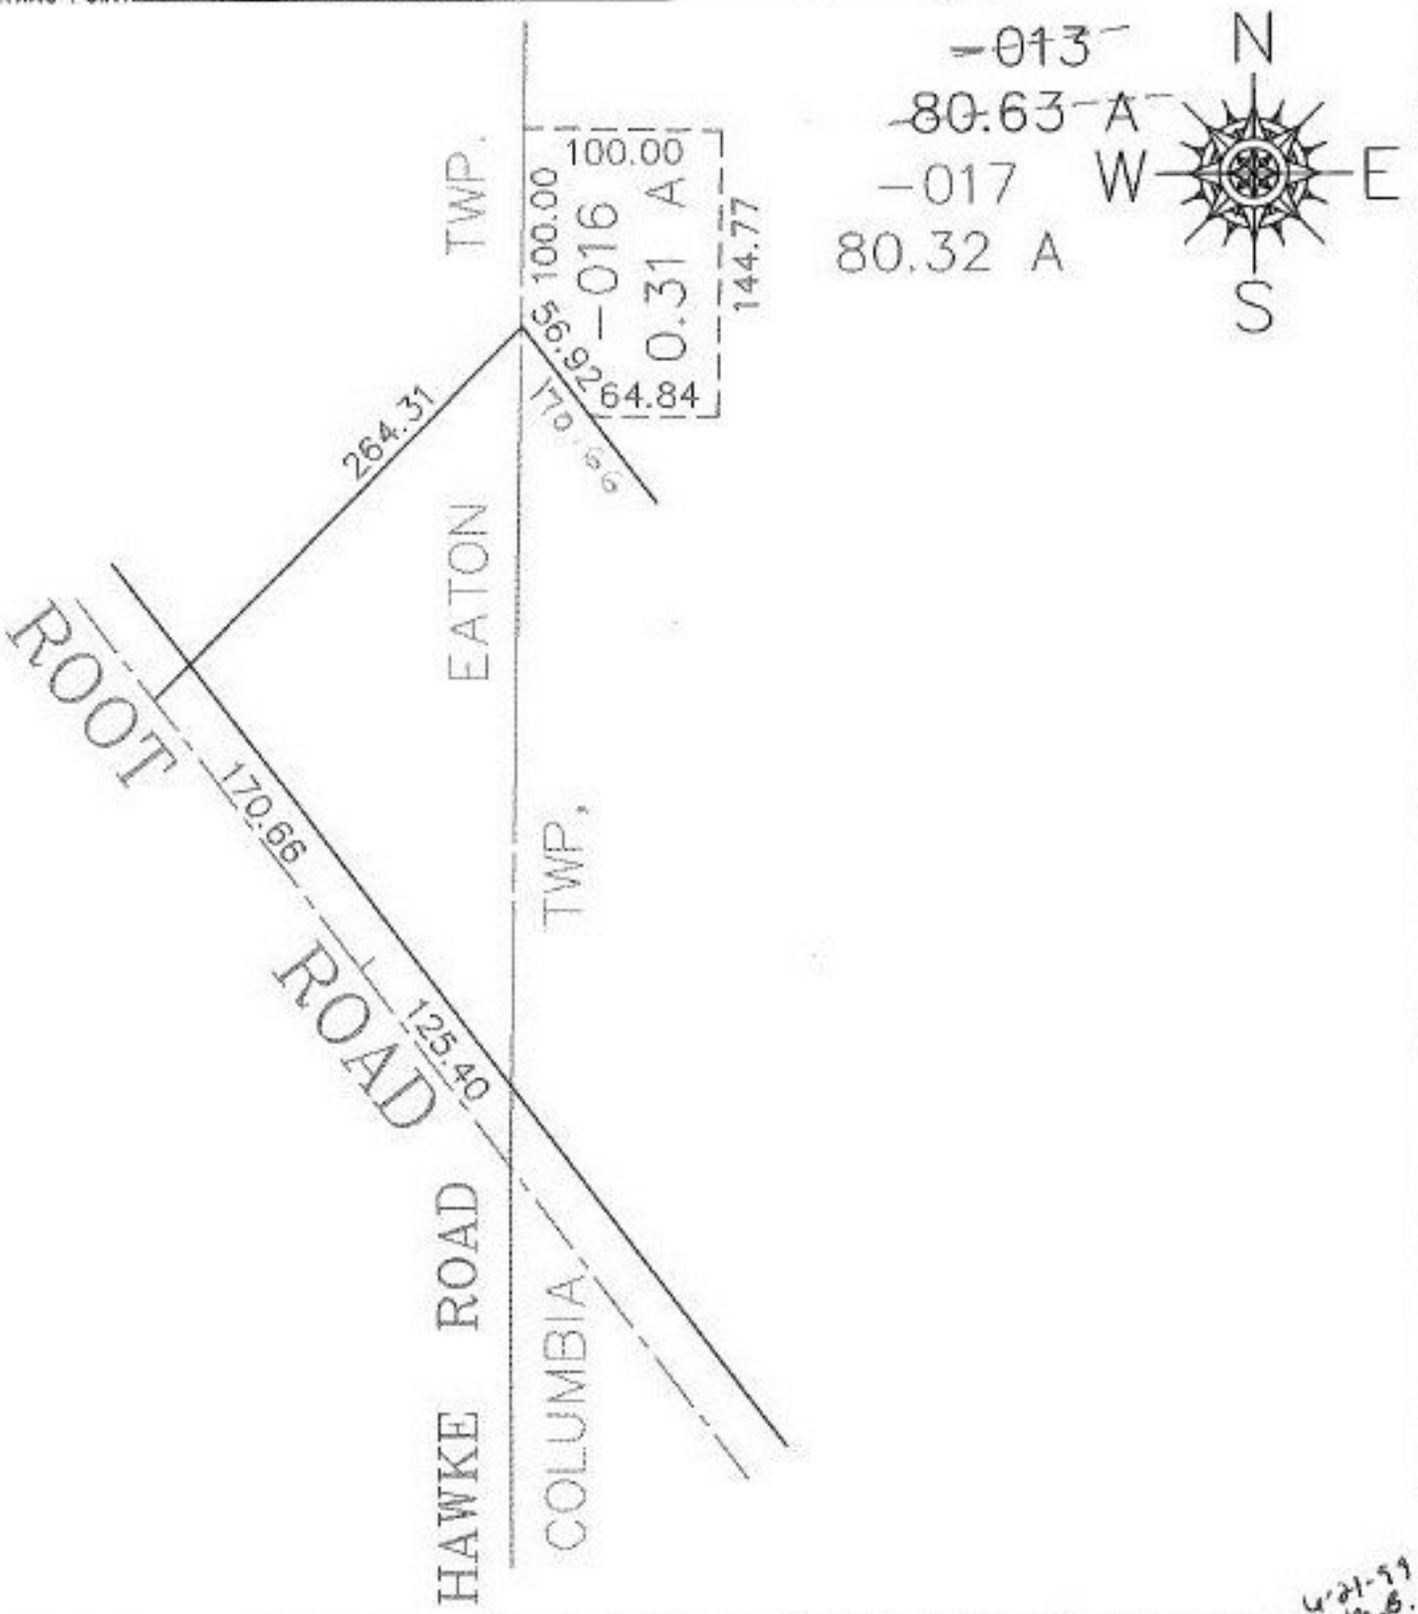

6-21-99 M.B.

SPLITS/DEEDS PROCESSED

LORAIN COUNTY TAX MAP DEPARTMENT

226 MIDDLE AVE. ELYRIA, OHIO

SURVEYED BY: STEVEN R HOFFMAN

CLOSURE: 0.13 / 10,000

MAP PAGE(S): 12-A

APPROVED BY: F.COLBERT DATE: 9/10/98

SCALE: 1"= 100 PRIOR INSTRUMENT: OR472/88