PARENT PARCEL: 04-00-024-111-051 & 052

CHILD PARCEL: 04-00-024-111-090 THRU 093

STARTING POINT: S.E. CORNER OF S\L 79

NO. 22596

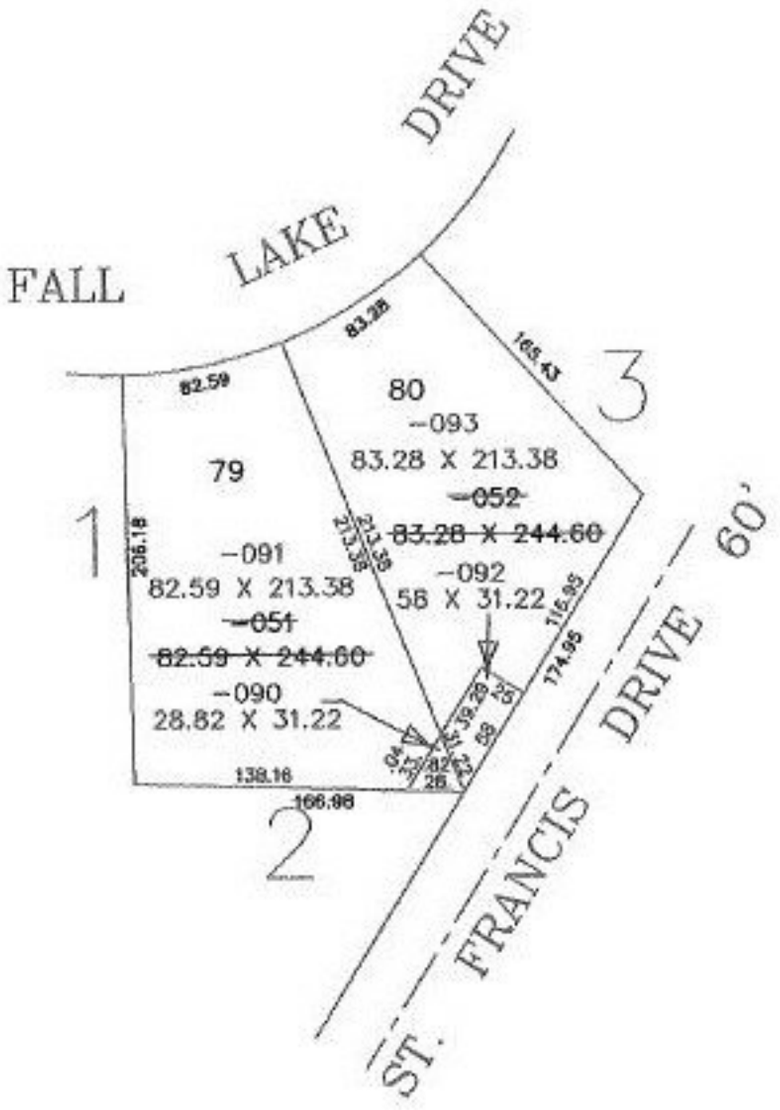

SPLITS/DEEDS PROCESSED

LORAIN COUNTY TAX MAP DEPARTMENT

226 MIDDLE AVE. ELYRIA, OHIO

SURVEYED BY: TERIN J. KAMINSKI

CLOSURE: 0.82 : 10,000

MAP PAGE(S): 04-00-024-G

APPROVED BY: TJS DATE: 07/31/98

SCALE: 1"= 100 PRIOR INSTRUMENT: PLAT 58/29