PARENT PARCEL: 04-00-013-000-010, & 04-00-012-103-028

CHILD PARCEL: 04-00-013-000-211 & 212

STARTING POINT: I.P. FOUND AT THE N.W. CORNER OF O.L. 13

NO. 22598

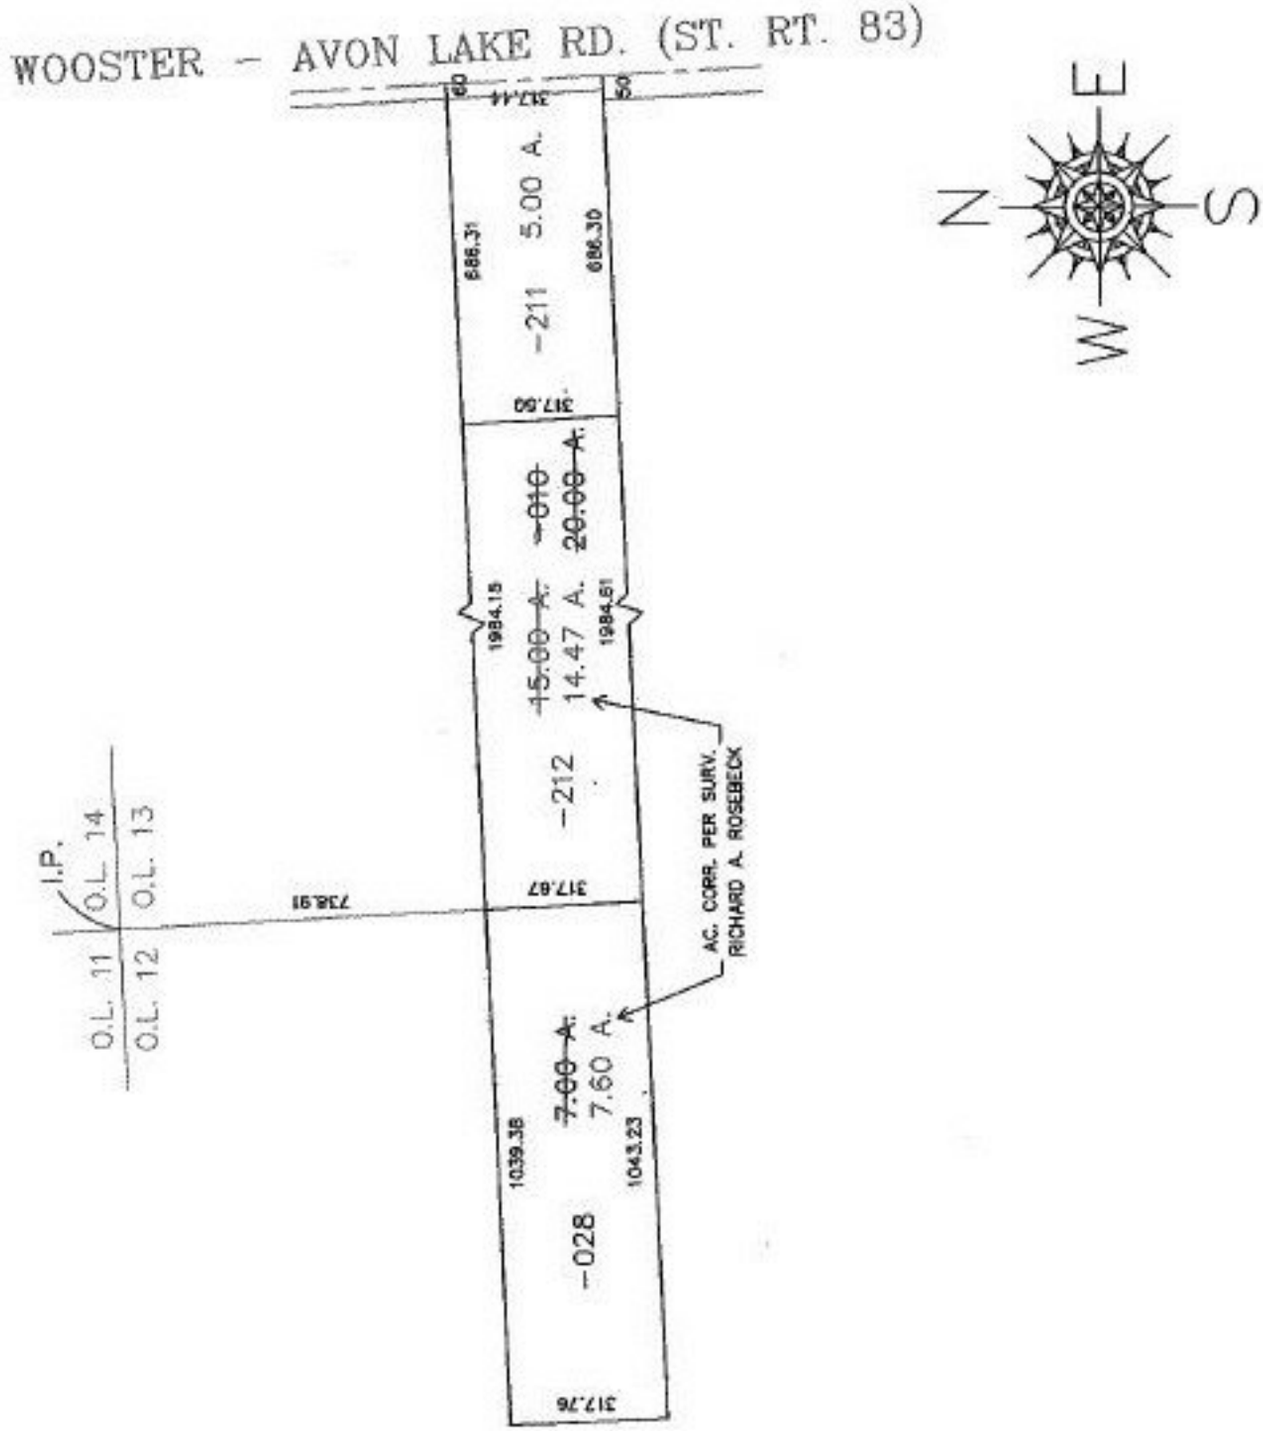

SPLITS/DEEDS PROCESSED

LORAIN COUNTY TAX MAP DEPARTMENT
226 MIDDLE AVE. ELYRIA, OHIO

SURVEYED BY: RICHARD A. ROSEBECK

CLOSURE: 0.05 : 10,000

MAP PAGE(S): 04-00-013-A & B, 04-00-012-0

APPROVED BY: TJS DATE: 07/24/98

SCALE: 1" = 400 PRIOR INSTRUMENT: DV 525/498