PARENT PARCEL: 04-00-013-000-023, 070, 180, & 192, 04-00-012-103-123

CHILD PARCEL: 04-00-013-000-209 & 210, 04-00-012-103-134

STARTING POINT: I.P. FOUND AT THE N.W. CORNER OF O.L. 13

NO. 22601

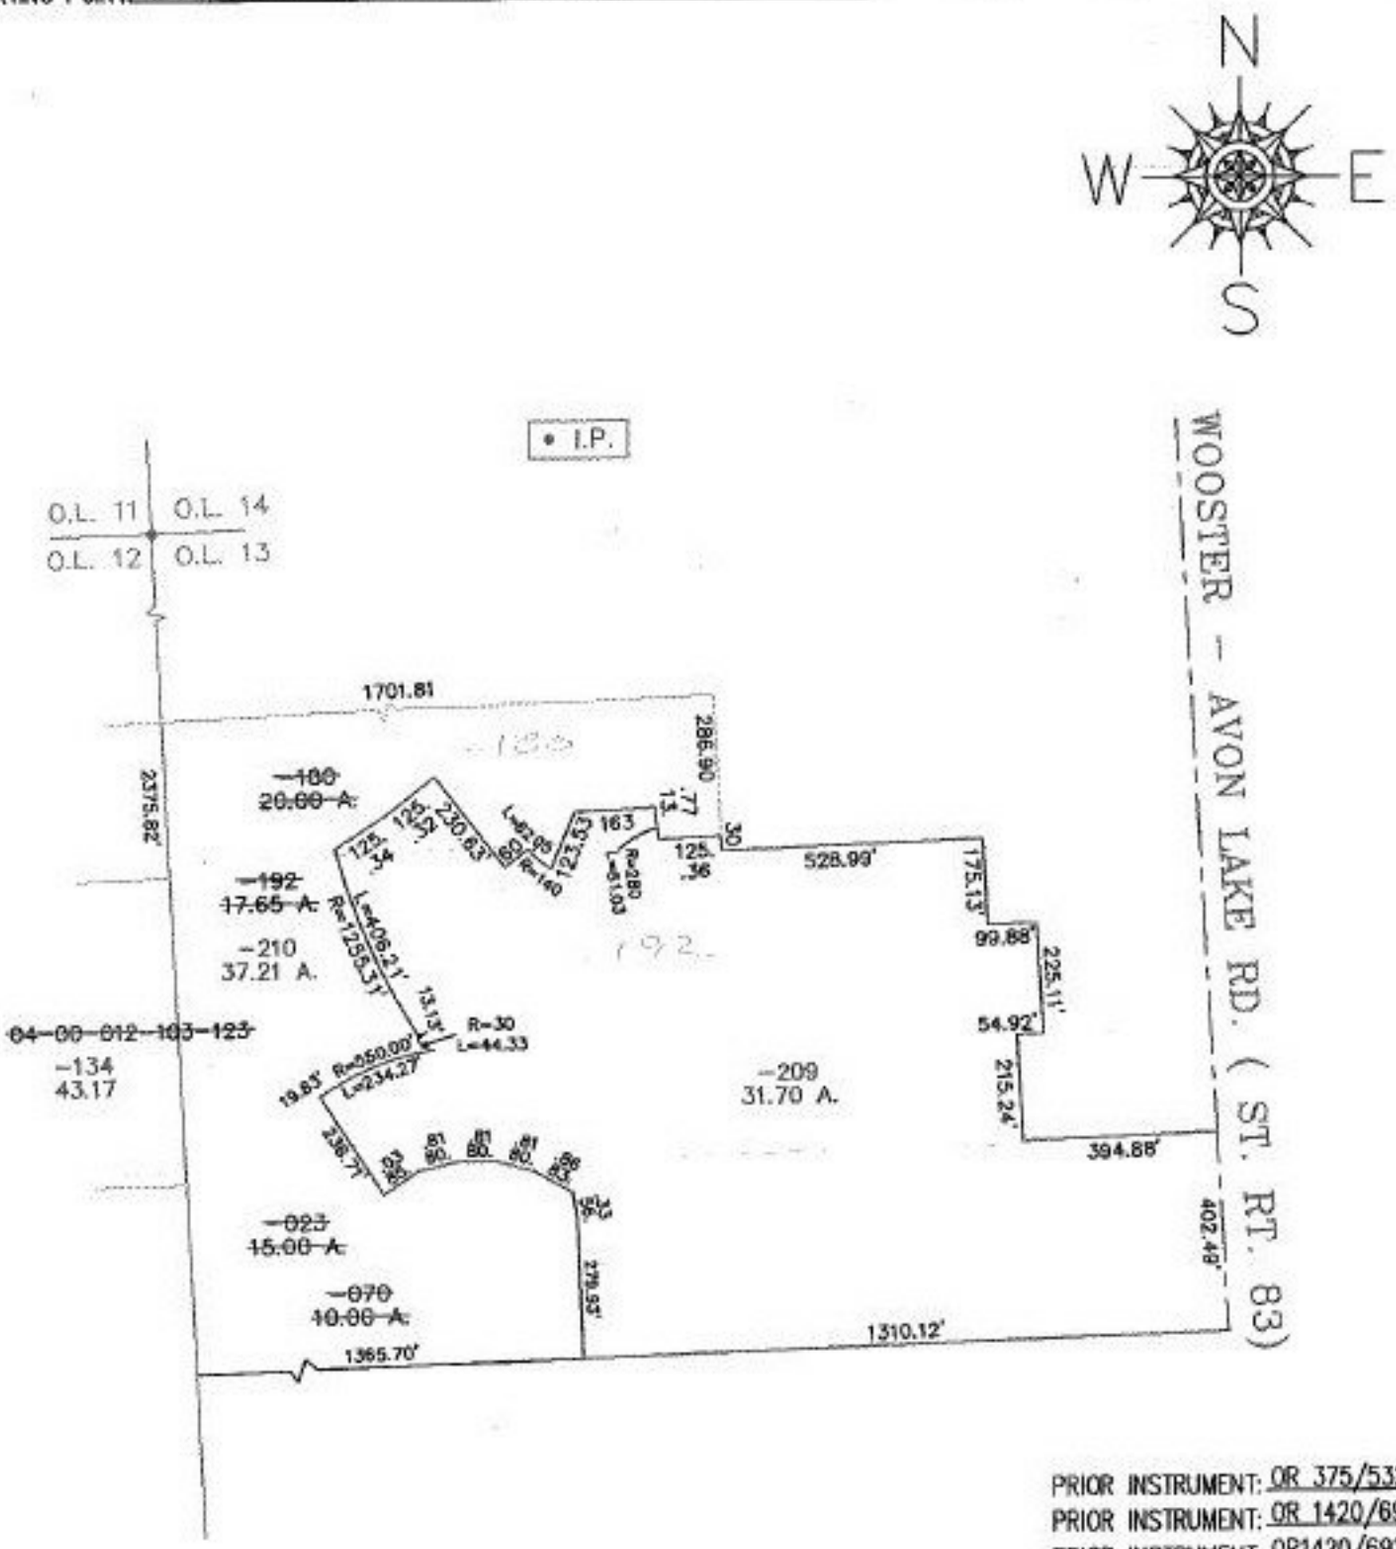

PRIOR INSTRUMENT: OR 375/532

PRIOR INSTRUMENT: OR 1420/694

PRIOR INSTRUMENT: OR1420/692

PRIOR INSTRUMENT: OR 434/790

SPLITS/DEEDS PROCESSED

LORAIN COUNTY TAX MAP DEPARTMENT

226 MIDDLE AVE. ELYRIA, OHIO

SURVEYED BY: RICHARD A. ROSEBECK

CLOSURE: 0.01 : 10,000

MAP PAGE(S): 04-00-013-A & B

APPROVED BY: TJS DATE: 07/23/98

SCALE: 1"= 400 PRIOR INSTRUMENT: OR 547/261