PARENT PARCEL: 01-00-037-103-025 & 028
CHILD PARCEL: 01-00-037-103-029 THRU 031
STARTING POINT: R.R.S. IN THE CL OF CLAUS RD. & CL OF COOPER FOSTER PARK RD.

NO. 22604

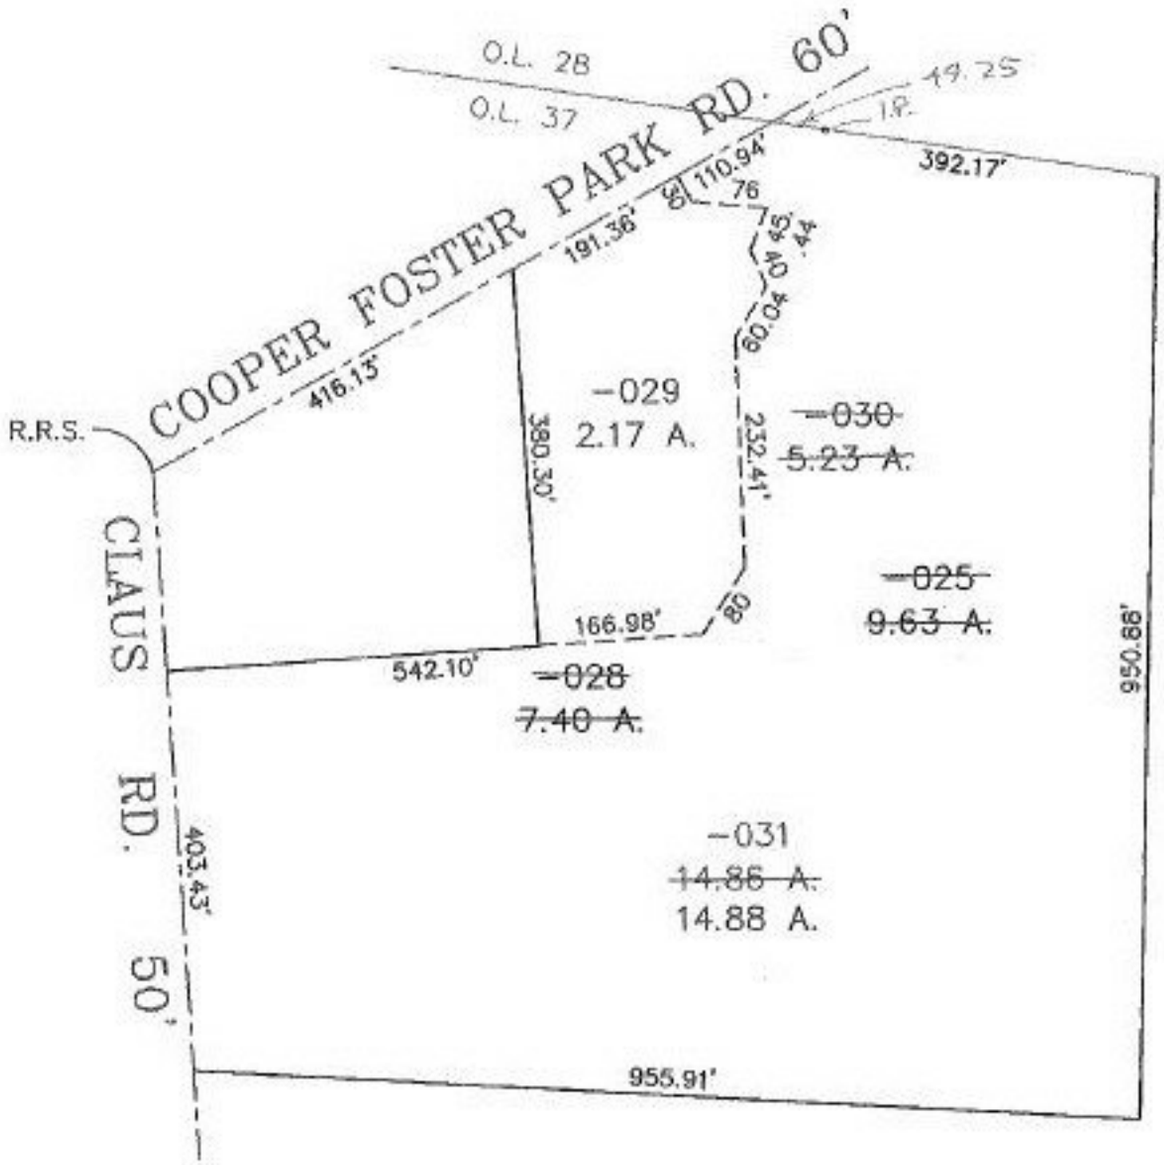

2-19-99

PRIOR INSTRUMENT: OR 1425/796
PRIOR INSTRUMENT: OR 910/154

SPLITS/DEEDS PROCESSED
LORAIN COUNTY TAX MAP DEPARTMENT
226 MIDDLE AVE. ELYRIA, OHIO

SURVEYED BY: RODGER G. SIMON
CLOSURE: 0.04 : 10,000
MAP PAGE(S): 01-00-037-B
APPROVED BY: TJS DATE: 07/29/98
SCALE: 1" = 200