PARENT PARCEL: 15-00-055-101-008, 009, 010

CHILD PARCEL: NONE

STARTING POINT: I.P. FOUND AT THE INTERSECTION OF THE EAST ROW OF CENTER ST. & NORTH ROW OF UNION ST.

NO. 22606-X

N

W E

S

DETAIL N.T.S.

MAP CHANGE ONLY

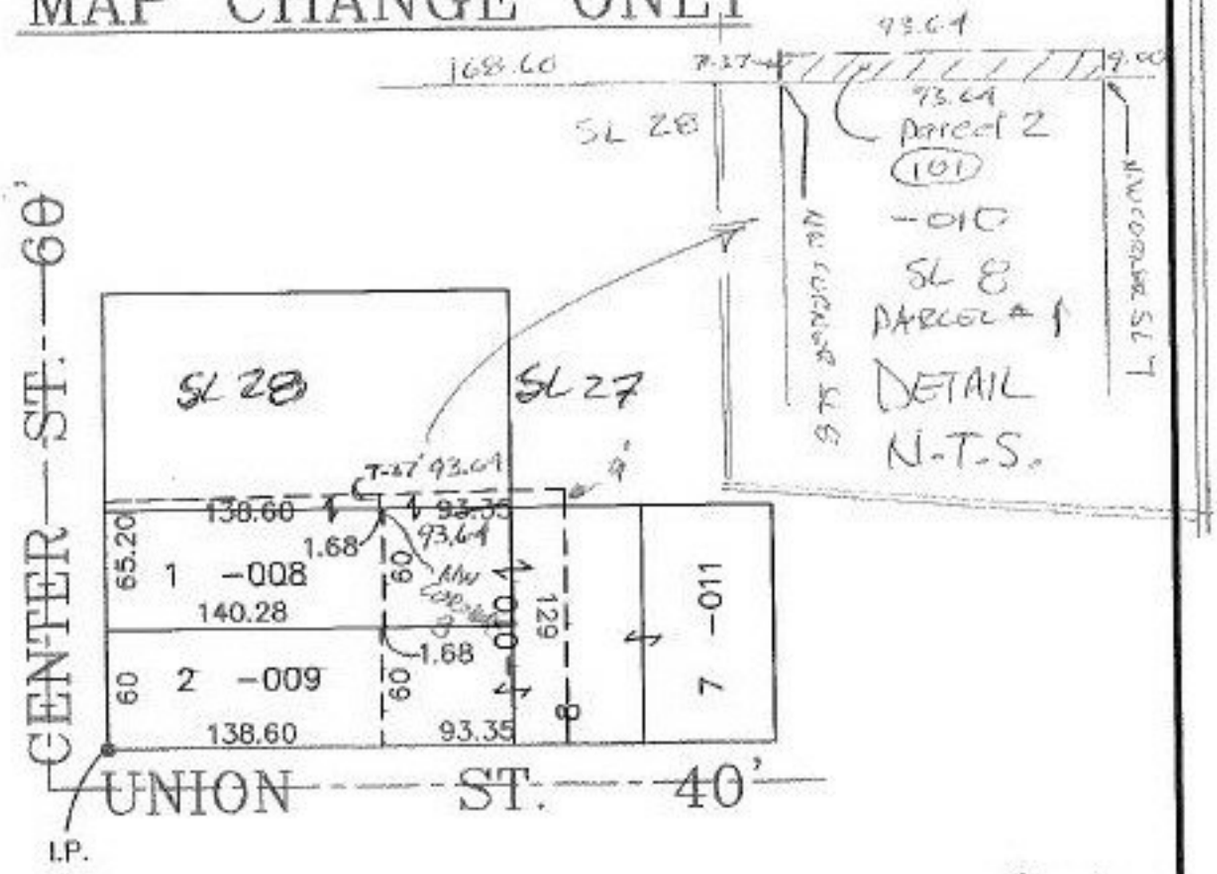

0155 - (101) - 010

PARTS OF 4 Sublots

PART OF SL 8
SL 1
SL 2
SL 27, 28

FB 3-15-00

SPLITS/DEEDS PROCESSED

LORAIN COUNTY TAX MAP DEPARTMENT
226 MIDDLE AVE. ELYRIA, OHIO

SURVEYED BY: DEEDS

CLOSURE: CAN'T RUN

MAP PAGE(S): 15-00-055-A

APPROVED BY: TJS DATE: 07/31/98

SCALE: 1"= 100 PRIOR INSTRUMENT: 970492259

980565234