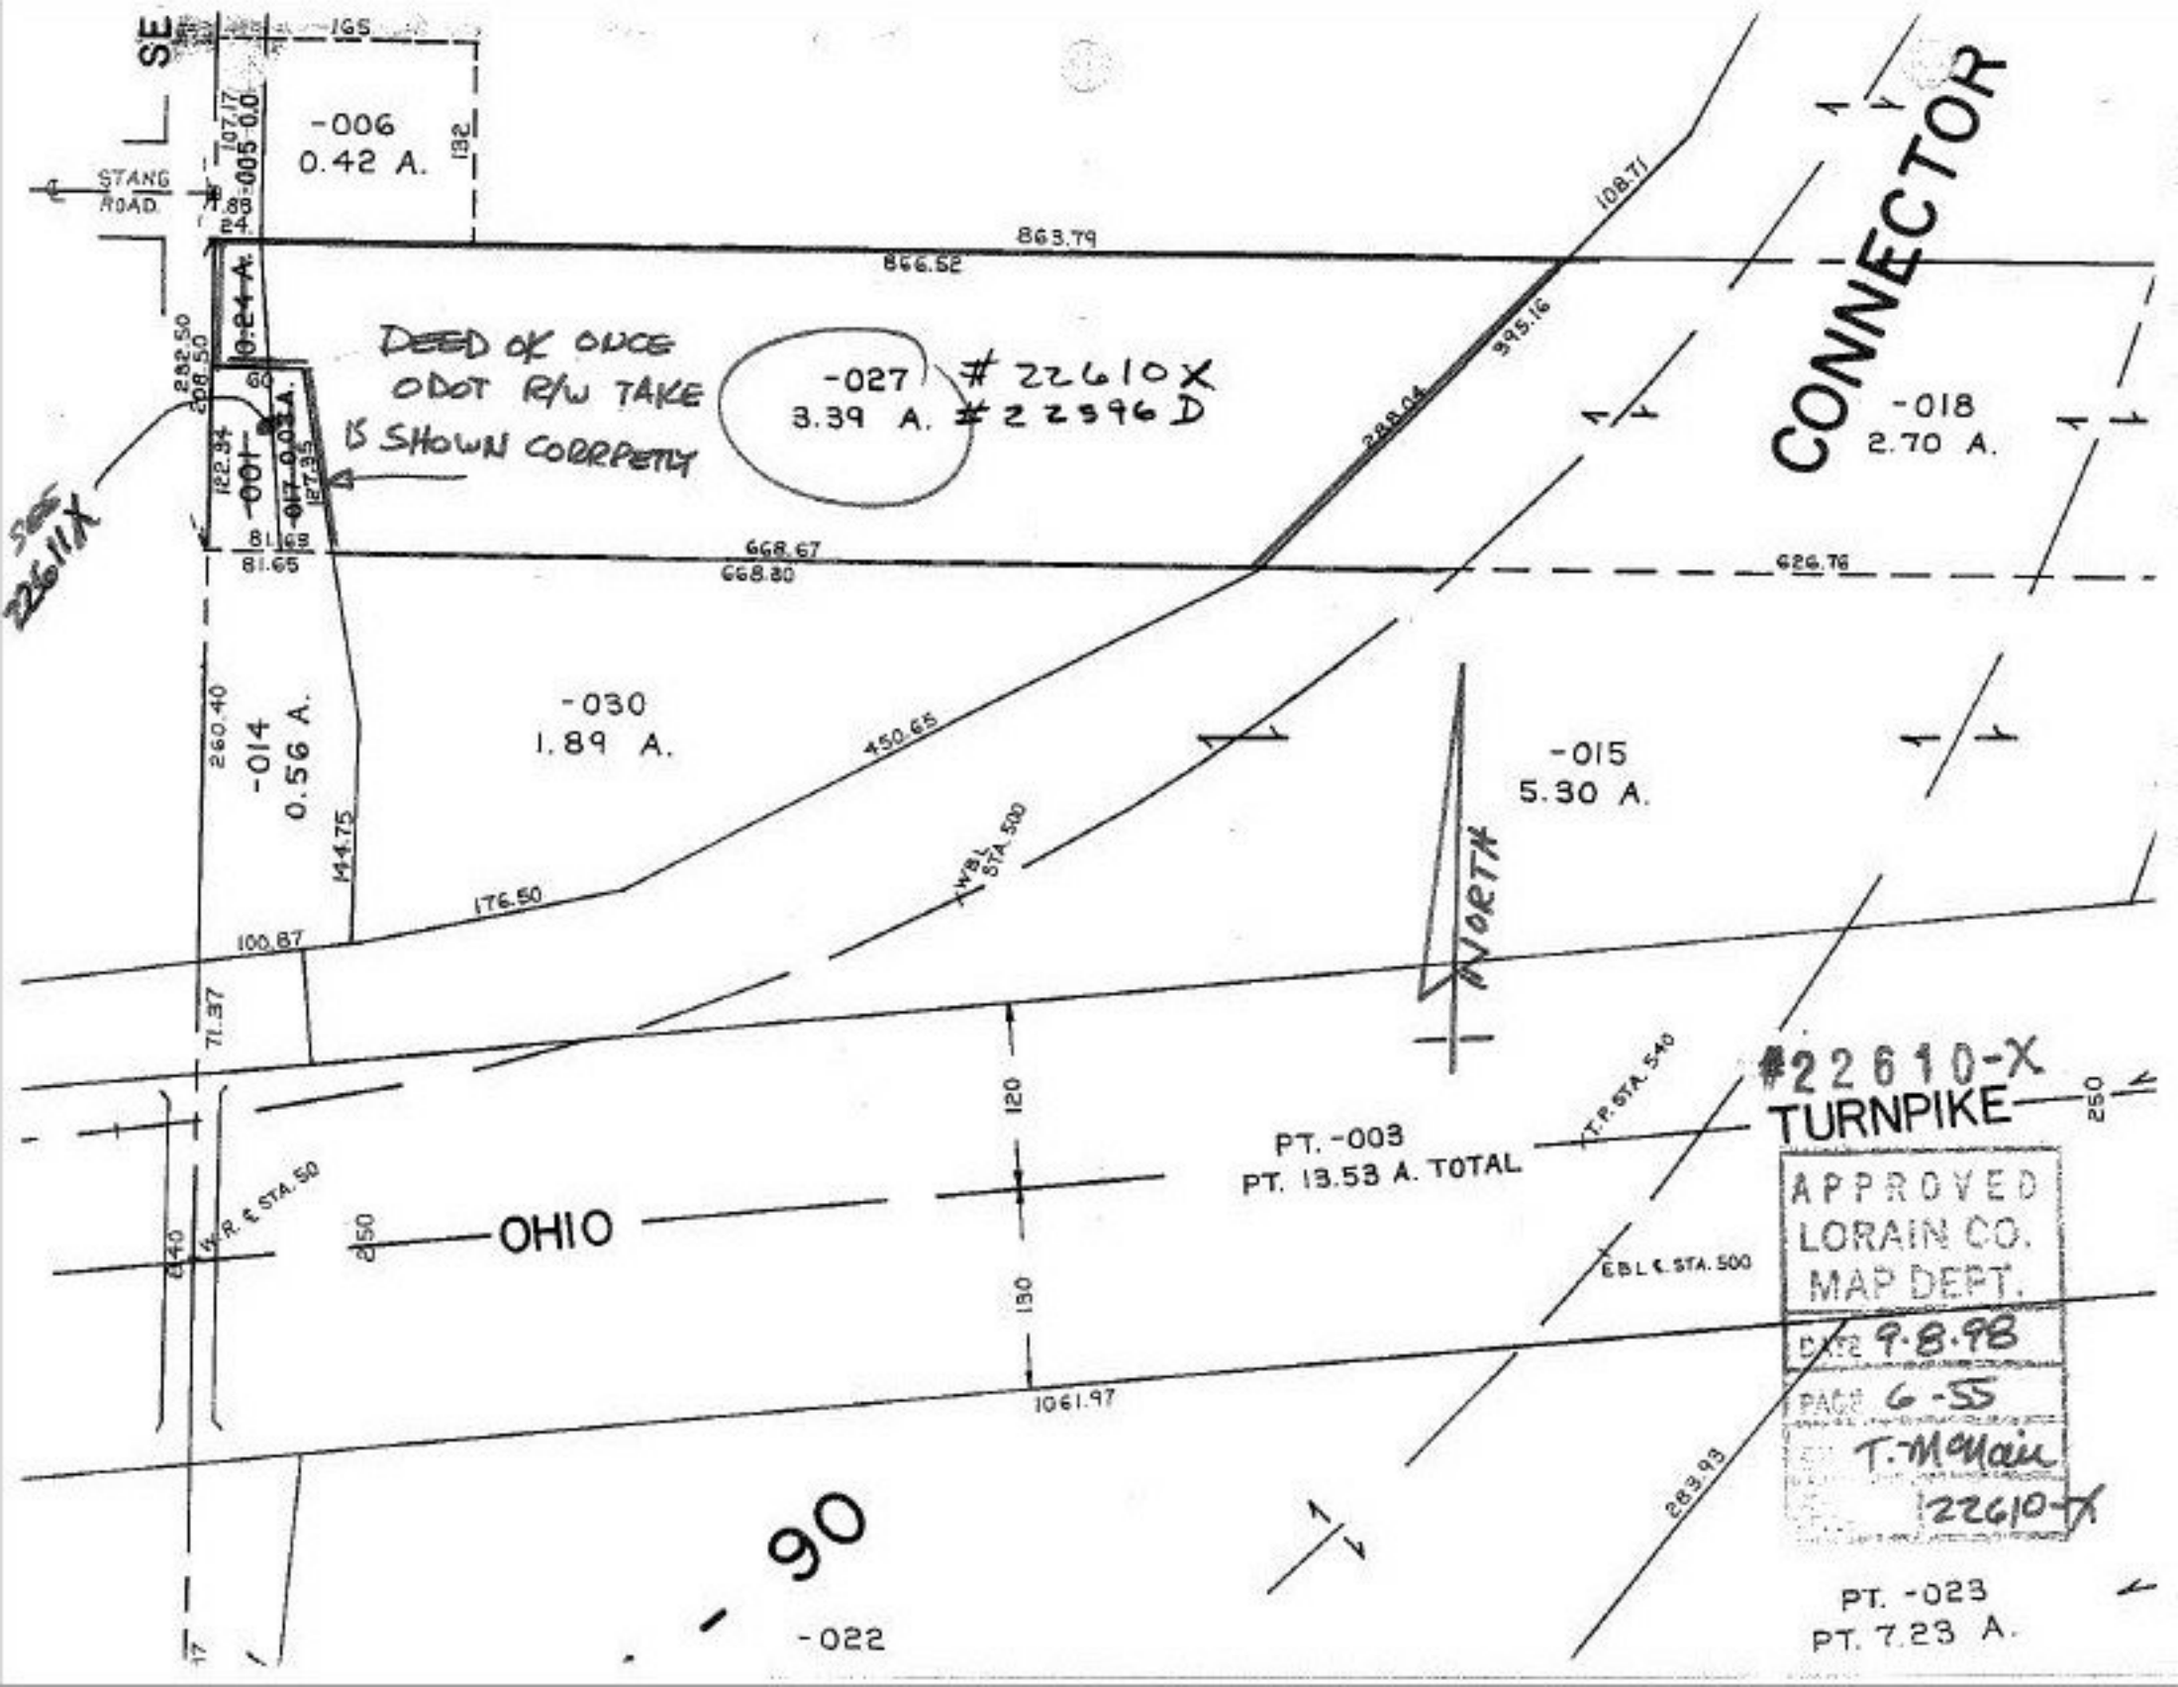
SE
165
-006
0.42 A.
132
107.17
-005 0.0
STANG ROAD
1.88
24
0.24 A.
863.79
866.52
108.71
CONNECTOR
DEED OF ONCE ODOT R/W TAKE IS SHOWN CORRECTLY
-027
3.39 A.
#22610X
#22596D
-018
2.70 A.
395.16
288.04
252.50
208.50
60
122.34
-001
-017 0.03 A.
127.35
81.65
81.65
668.67
668.80
626.76
SEE 22611X
-030
1.89 A.
-014
0.56 A.
260.40
144.75
450.65
176.50
100.87
71.37
-015
5.30 A.
NORTH
WBL STA. 500
#22610-X
TURNPIKE
T.P. STA. 540
120
PT. -003
PT. 13.53 A. TOTAL
250
OHIO
250
640
C/L R.R. & STA. 50
EBL & STA. 500
130
1061.97
283.93
APPROVED
LORAIN CO.
MAP DEPT.
DATE 9-8-98
PAGE 6-55
T. McClain
22610-X
- 90
-022
PT. -023
PT. 7.23 A.