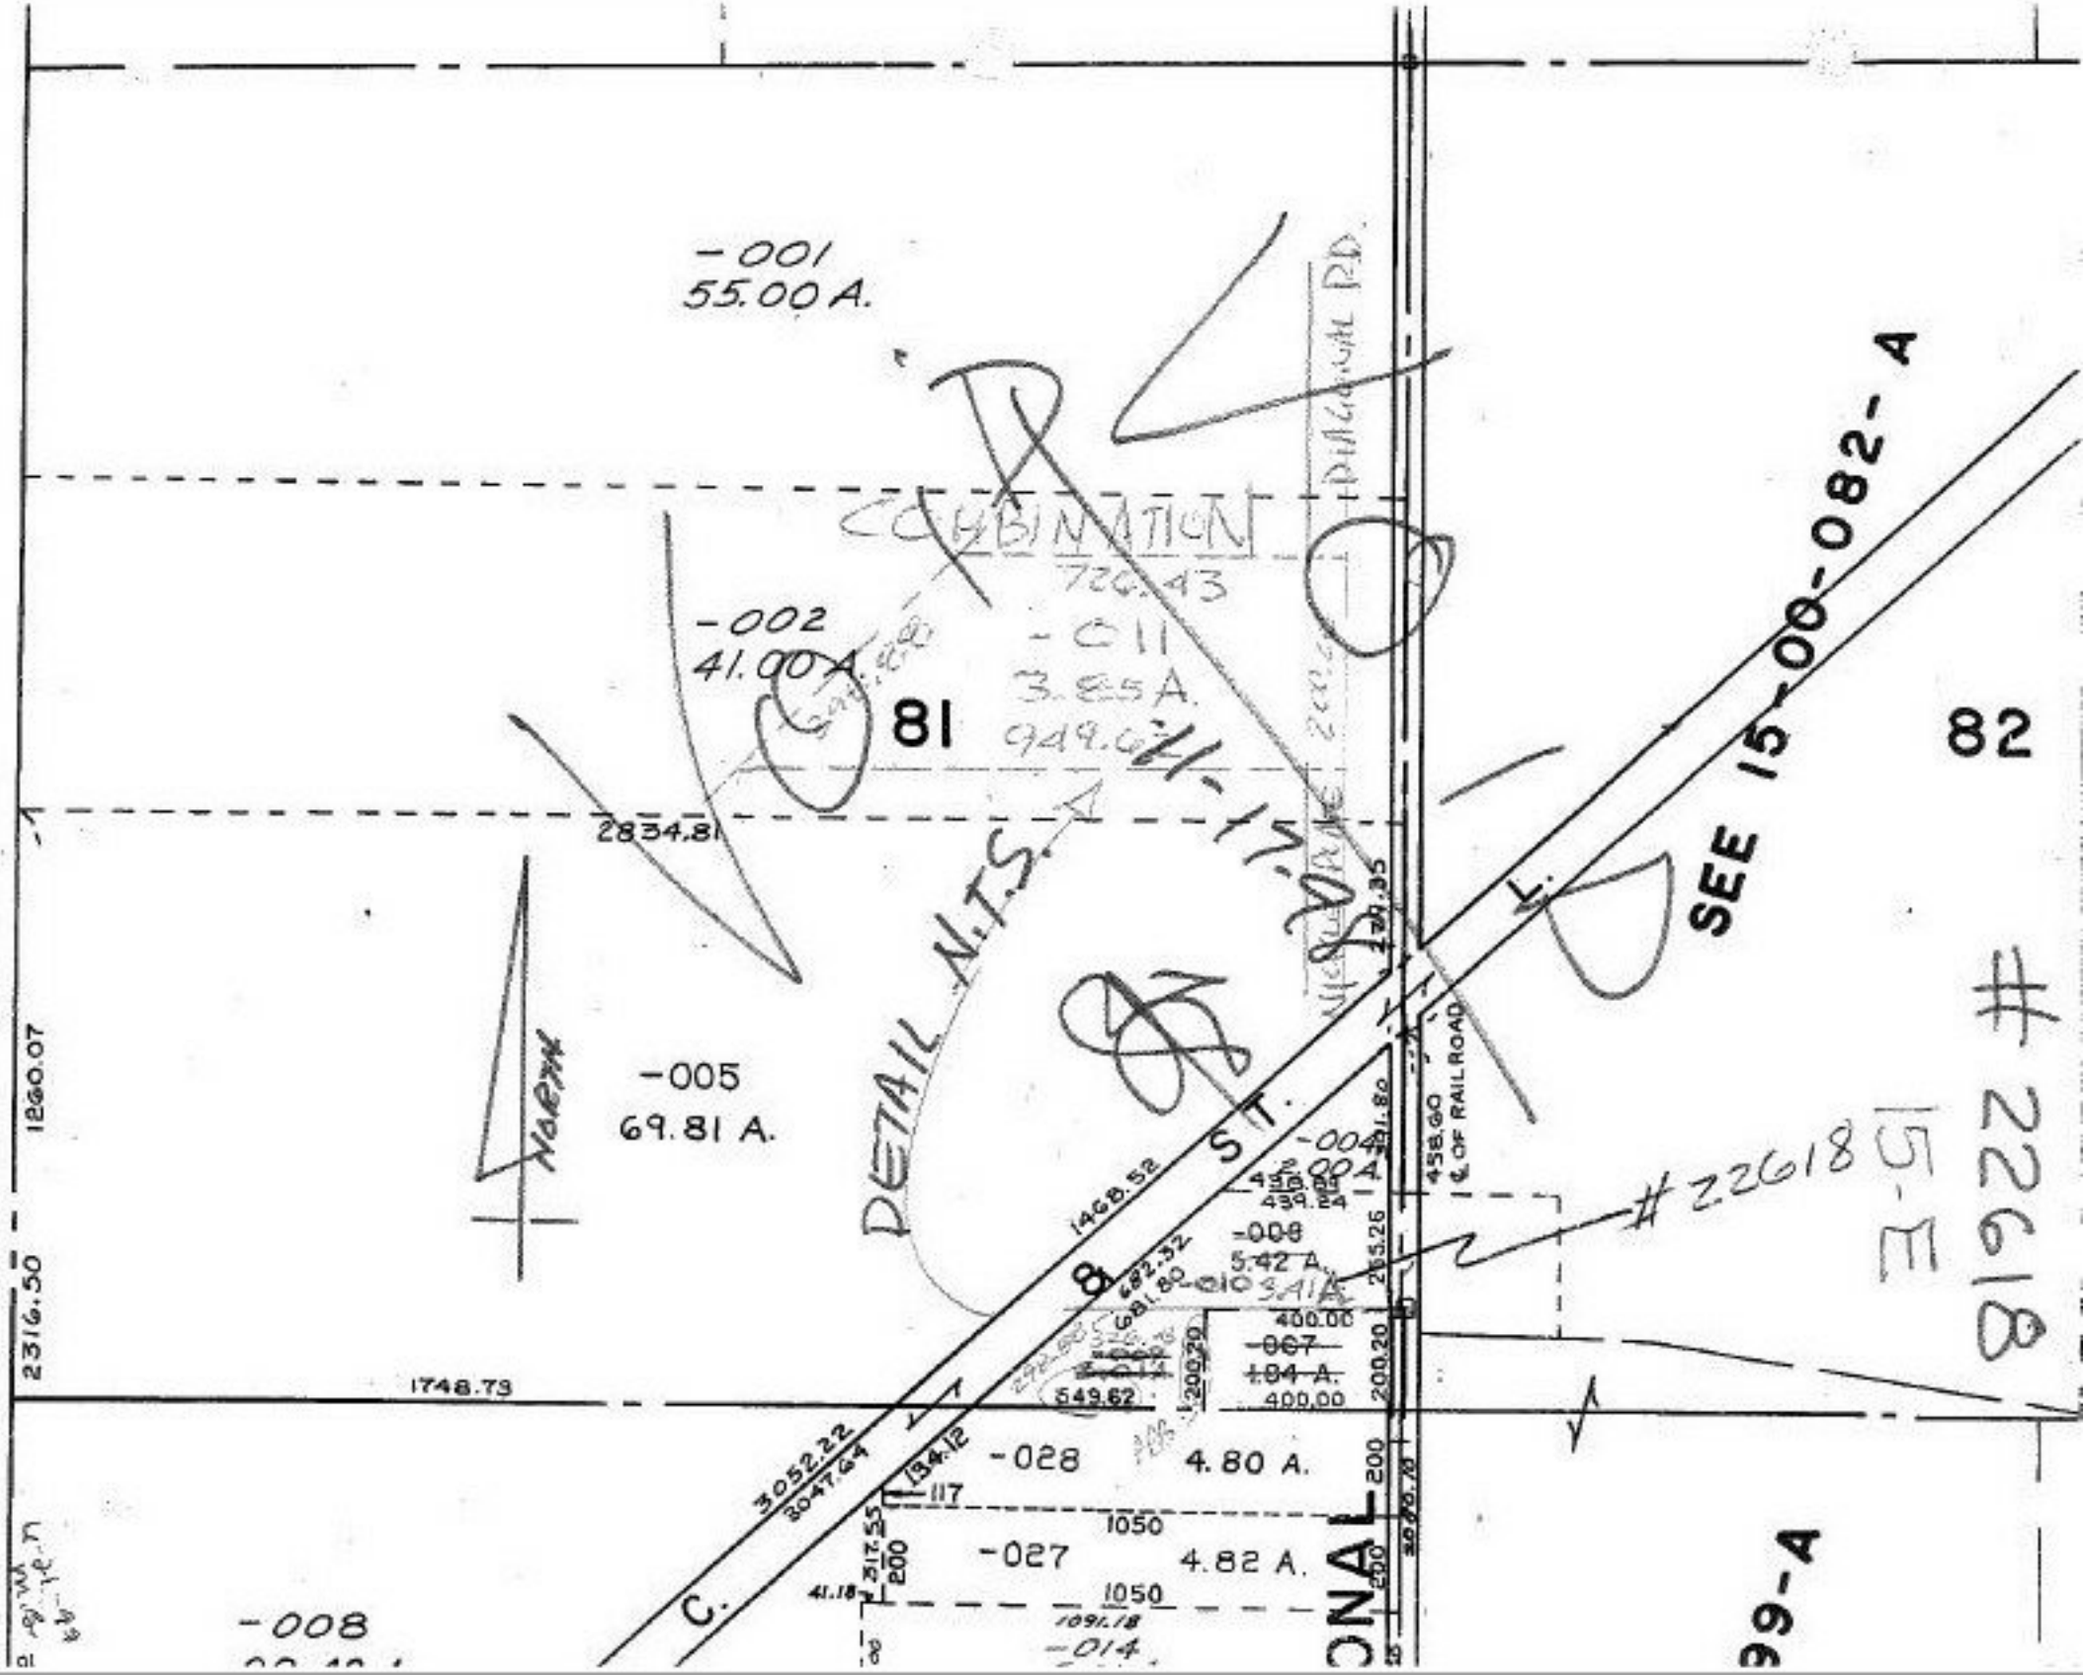
-001
55.00 A.
-002
41.00 A.
81
82
2834.81
1260.07
2316.50
1748.73
-005
69.81 A.
-008
5.42 A.
-028
4.80 A.
-027
4.82 A.
-014
720.43
-011
3.85 A.
949.62
PETAIL N.I.S.
SEE 15-08-082-A
#22618
8122 #
E-51
1468.52
682.32
681.80
549.62
3052.22
3047.64
1091.18
1050
200
400.00
-007
1.84 A.
439.84
458.60
I & OF RAIL ROAD
ST.
C.
ONAL