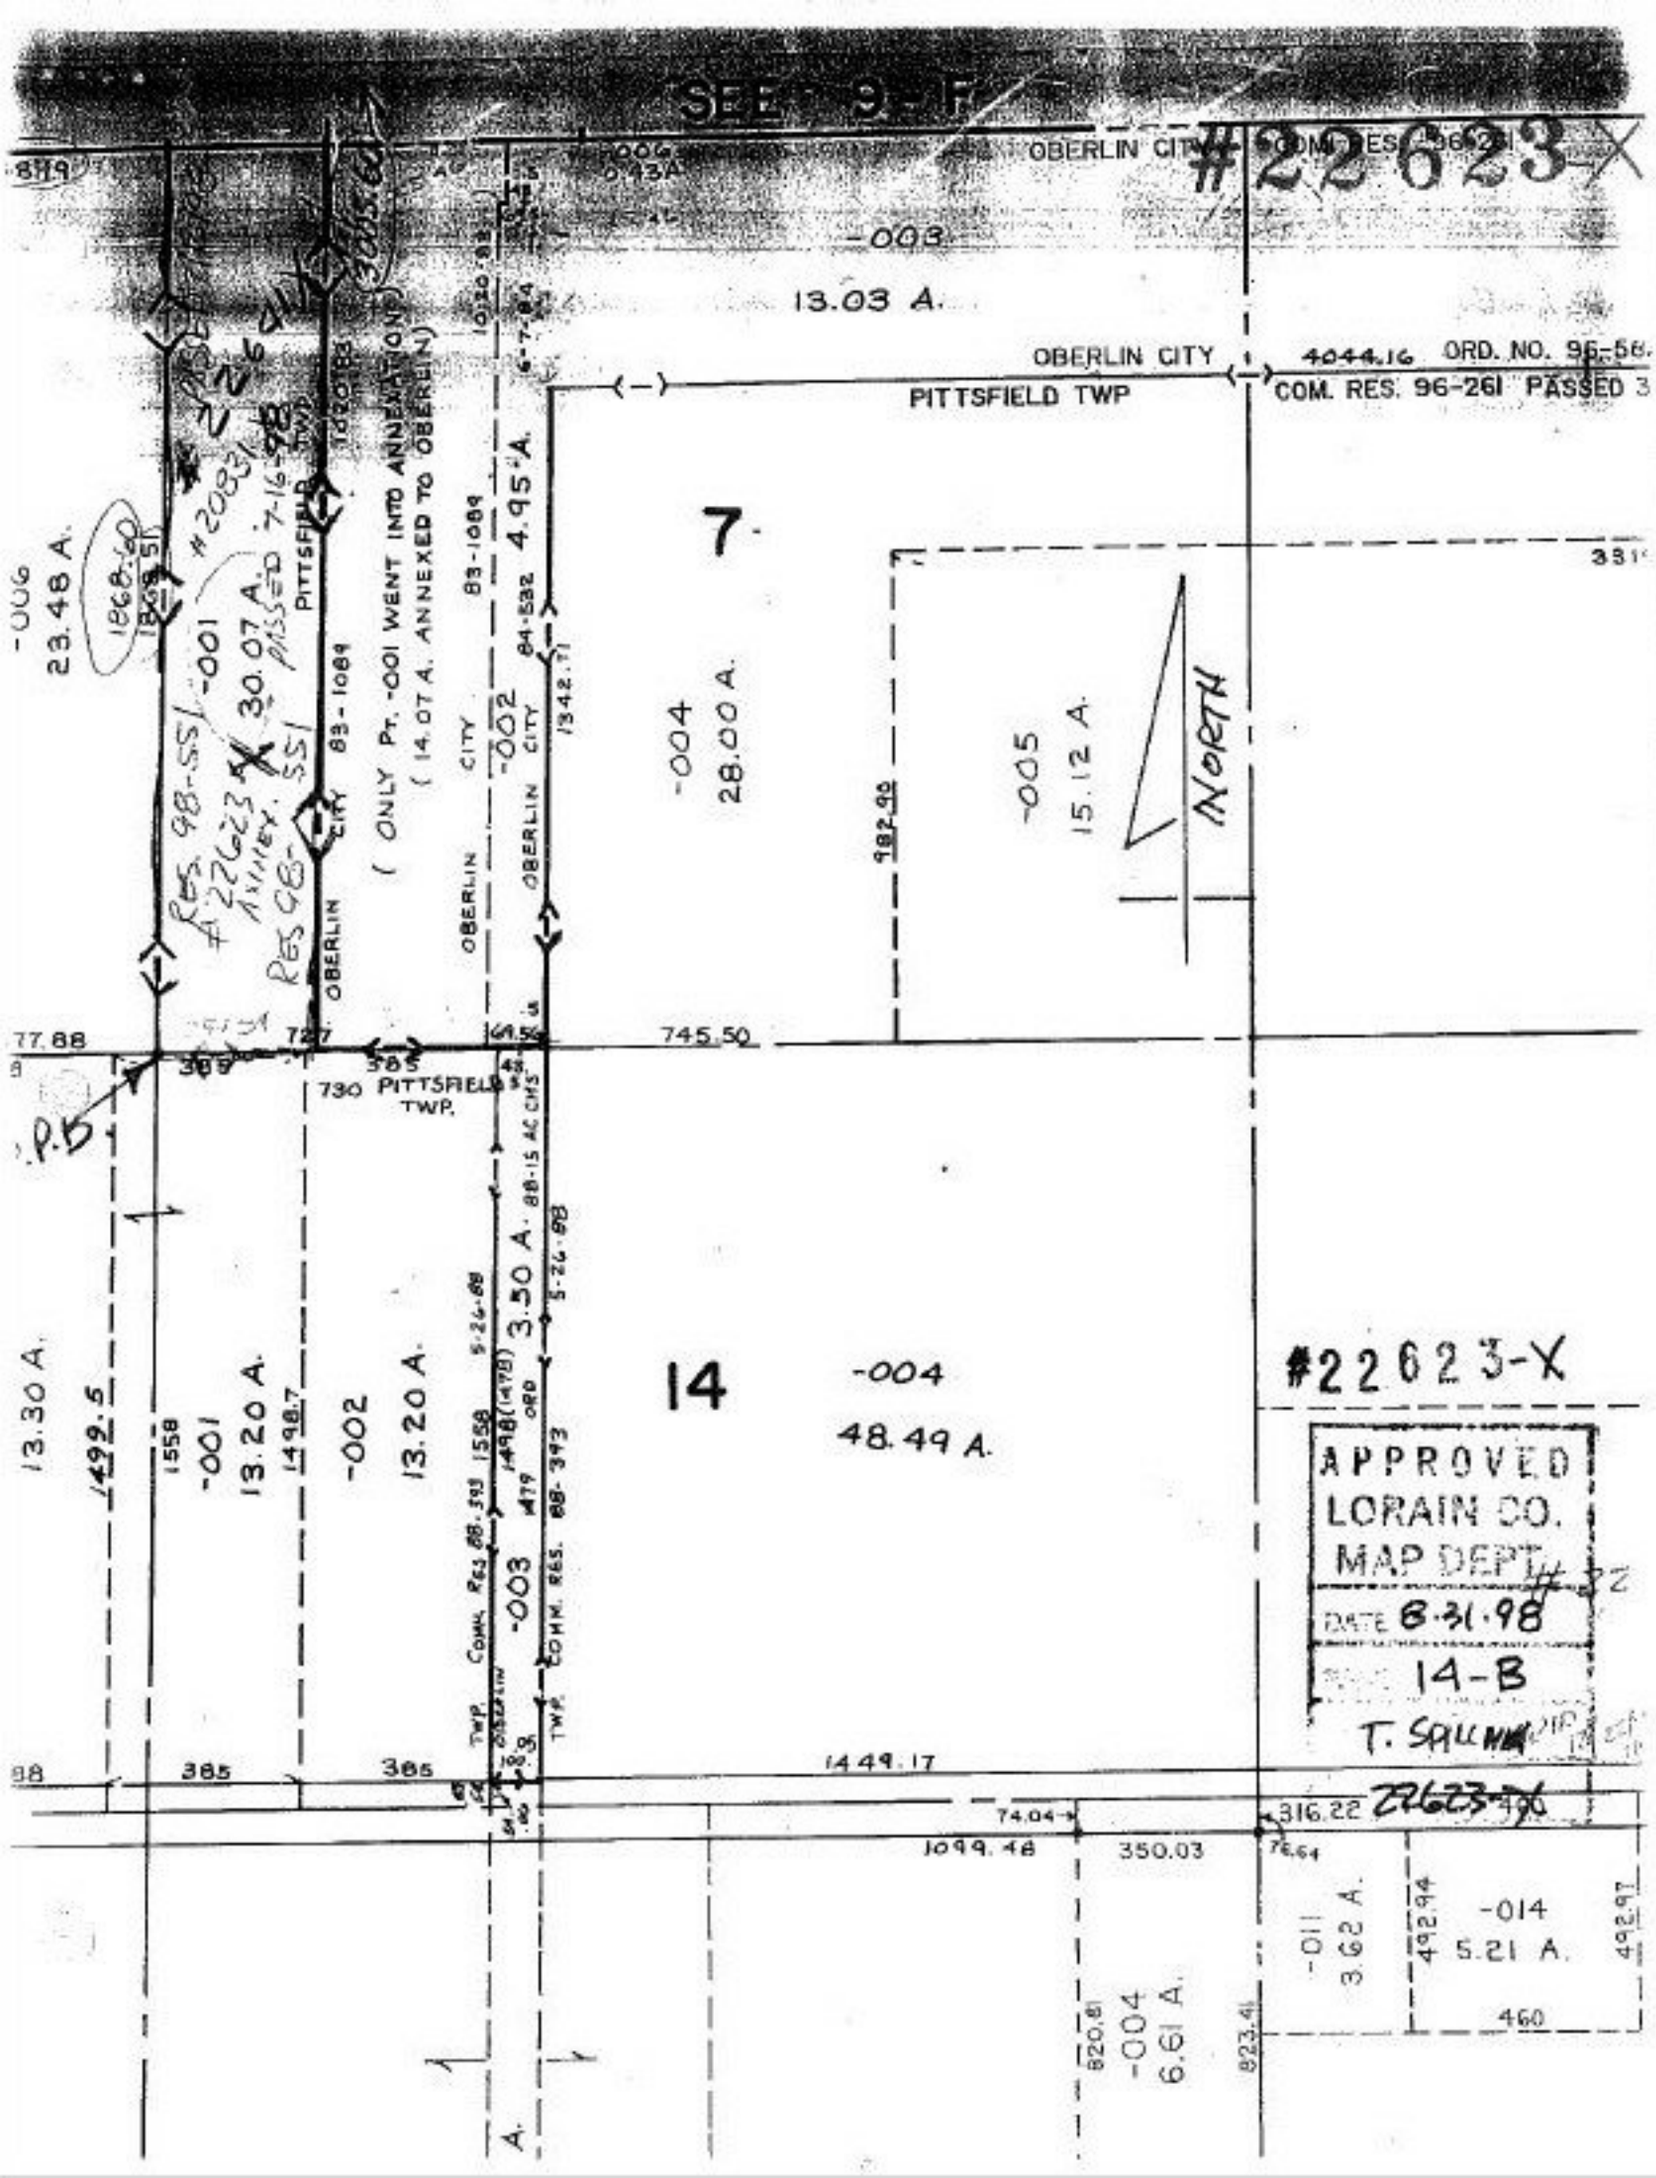
SEE 3-F
#22623-X
OBERLIN CITY
COM. RES. 96-261
-003
13.03 A.
OBERLIN CITY
PITTSFIELD TWP
4044.16
ORD. NO. 96-56.
COM. RES. 96-261 PASSED 3
7
-004
28.00 A.
-005
15.12 A.
NORTH
-006
23.48 A.
-001
30.07 A.
PASSED
4.95 A.
-002
-001
13.20 A.
-002
13.20 A.
13.30 A.
14
-004
48.49 A.
3.50 A.
-003
-011
3.62 A.
-014
5.21 A.
-004
6.61 A.
745.50
1449.17
1099.48
350.03
316.22
APPROVED
LORAIN CO.
MAP DEPT.
DATE 6-31-98
14-B
T. SALL