PARENT PARCEL: 01-00-064-000-074

CHILD PARCEL: 01-00-064-000-075, -076

STARTING POINT: C/L NORTH RIDGE ROAD & E. LINE O.L. 64

NO. 22626

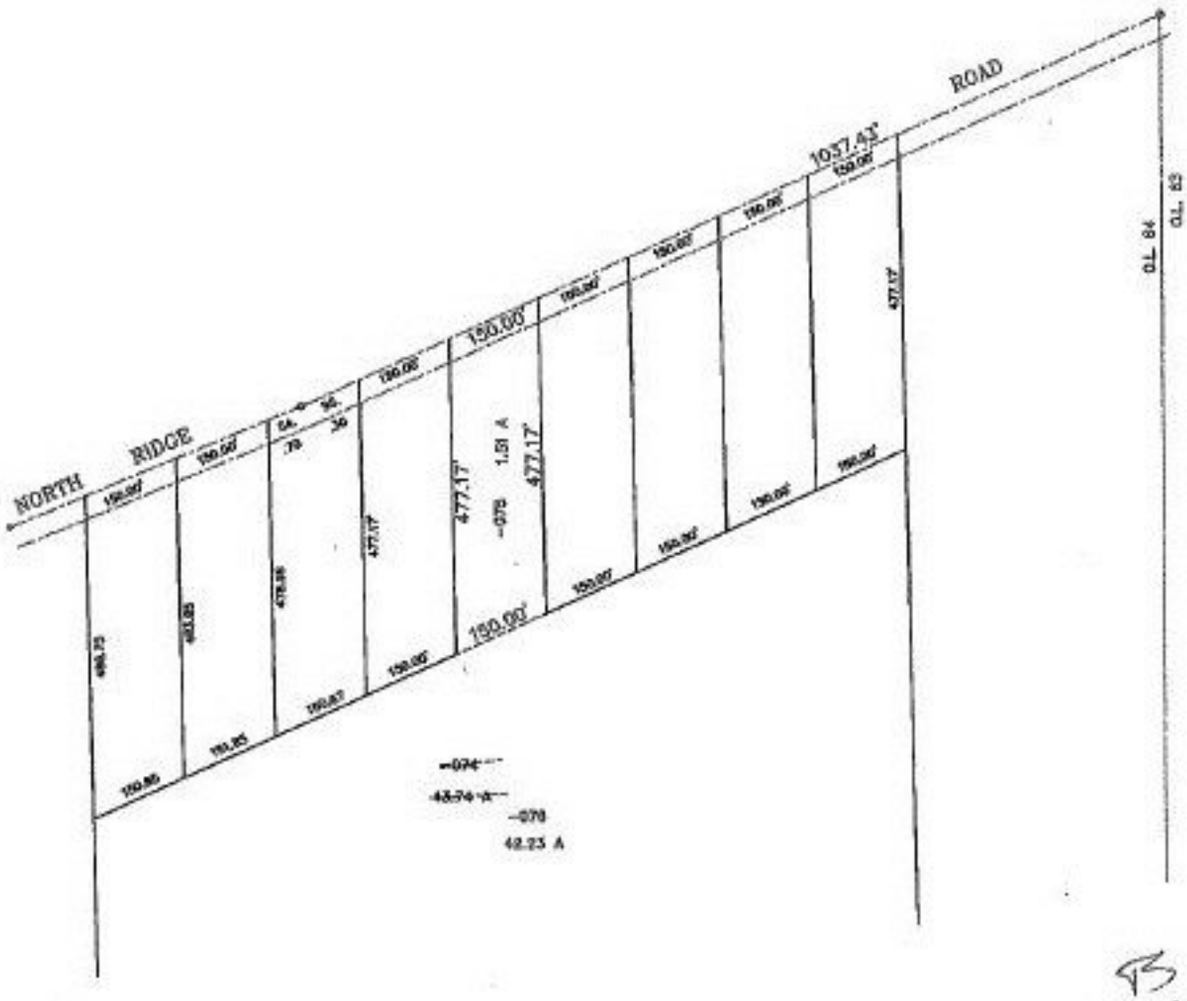

RB
2-19-99

SPLITS/DEEDS PROCESSED

LORAIN COUNTY TAX MAP DEPARTMENT

226 MIDDLE AVE. ELYRIA, OHIO

SURVEYED BY: M. G. HURA

CLOSURE: 0.00 / 10,000

MAP PAGE(S): 1-1

APPROVED BY: F. COLBERT DATE: 8/31/98

SCALE: 1"= 300 PRIOR INSTRUMENT: OR1375/841