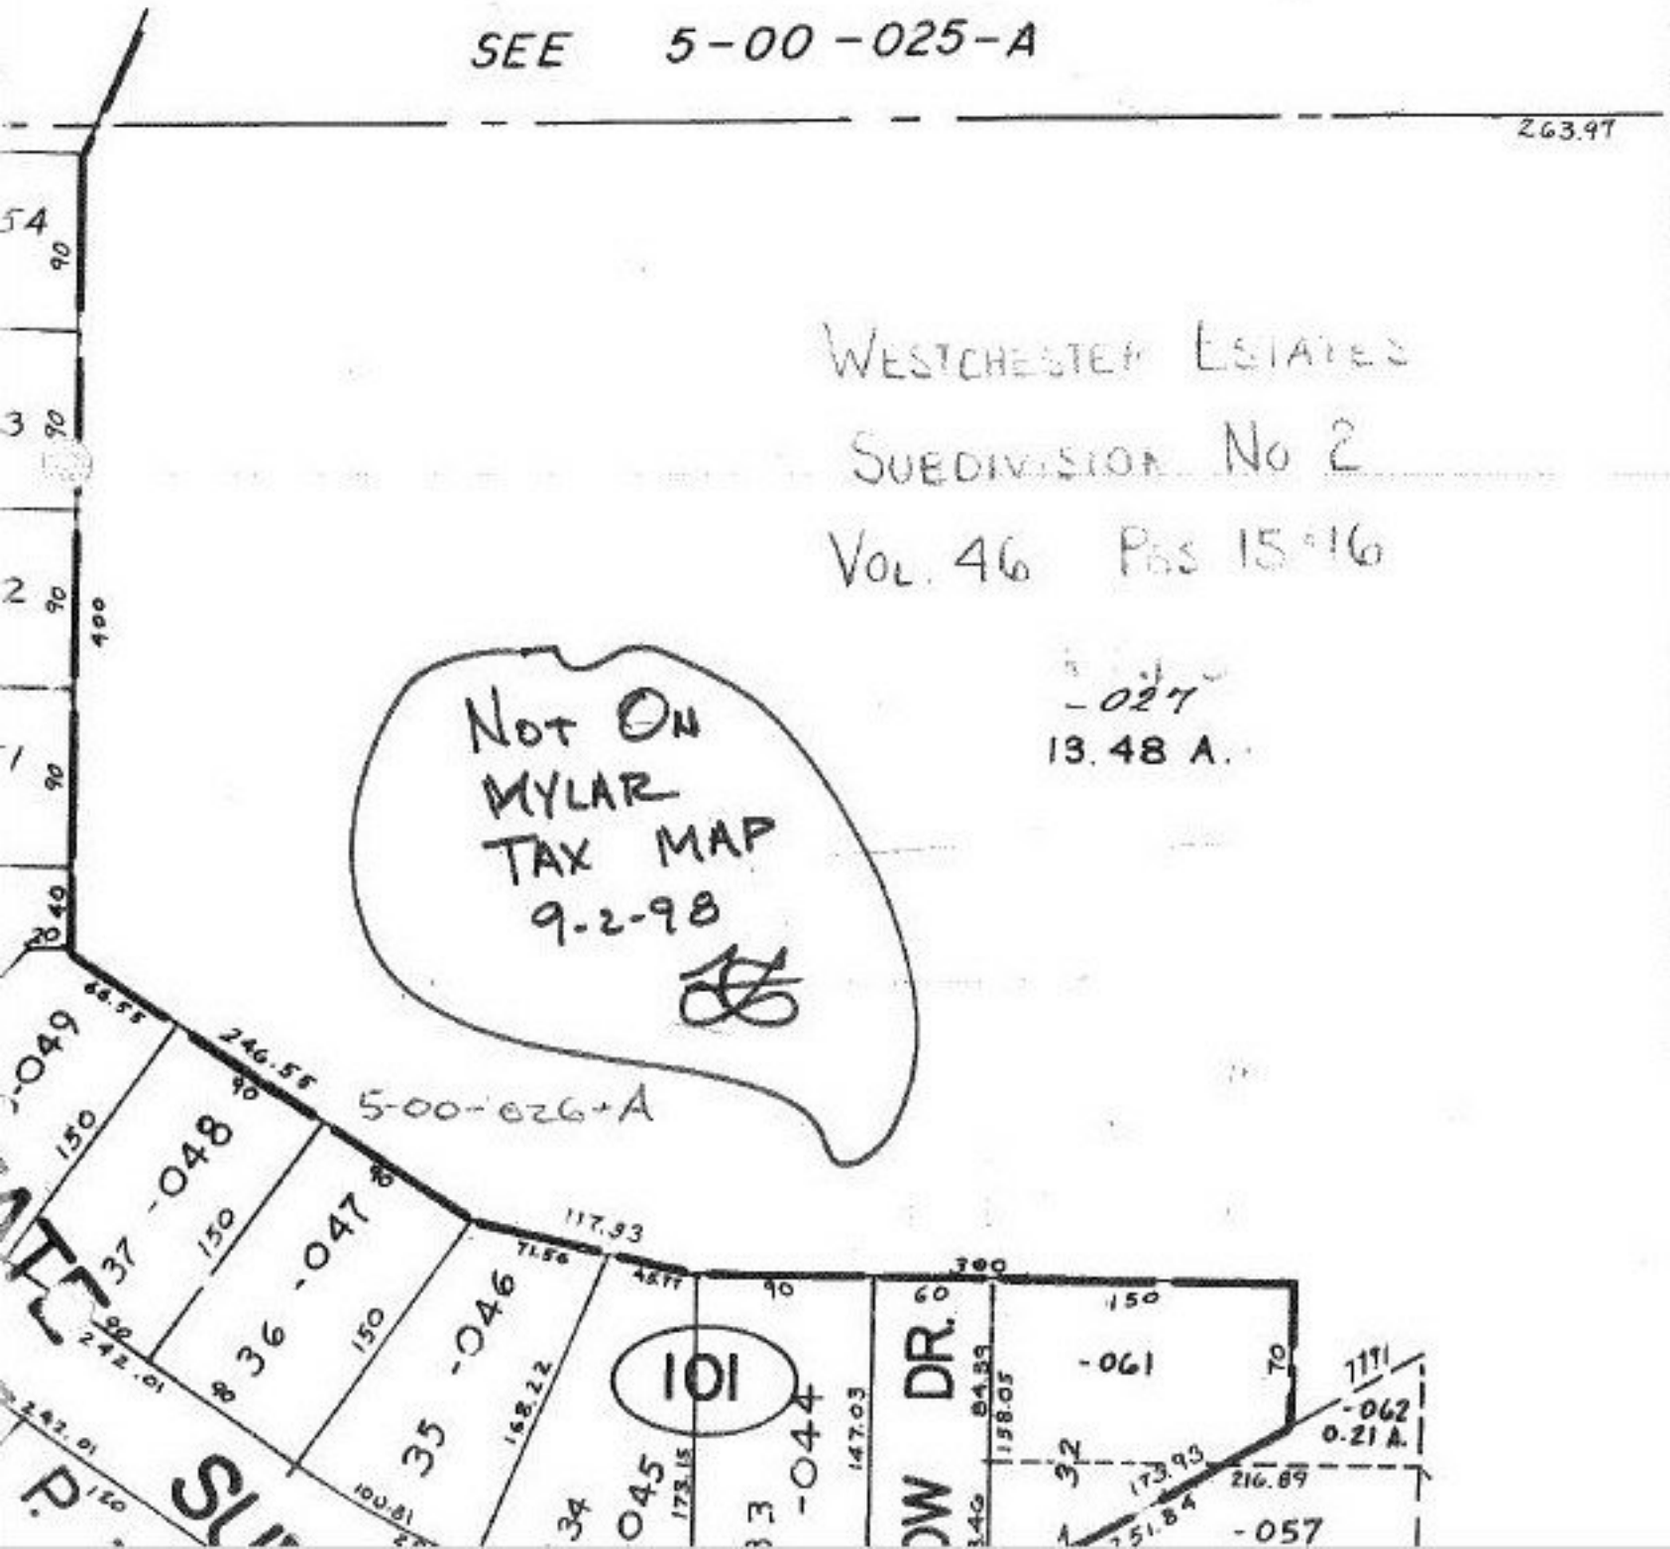
SEE 5-00-025-A
263.97
WESTCHESTER ESTATES
SUBDIVISION No 2
VOL. 46 PGS 15-16
-027
13.48 A.
NOT ON
MYLAR
TAX MAP
9-2-98
5-00-026-A
-049
-048
-047
-046
-044
-045
-061
-062
0.21 A.
-057
101
DR.
246.56
117.93
242.01
158.22
147.03
216.89
173.93