PARENT PARCEL: 18-00-003-000-009, 022, 023
CHILD PARCEL: 18-00-003-000-029, 030, 031
STARTING POINT: C/Ls OF MEDINA-NORWALK ROAD & WEST ROAD

NO. 22636

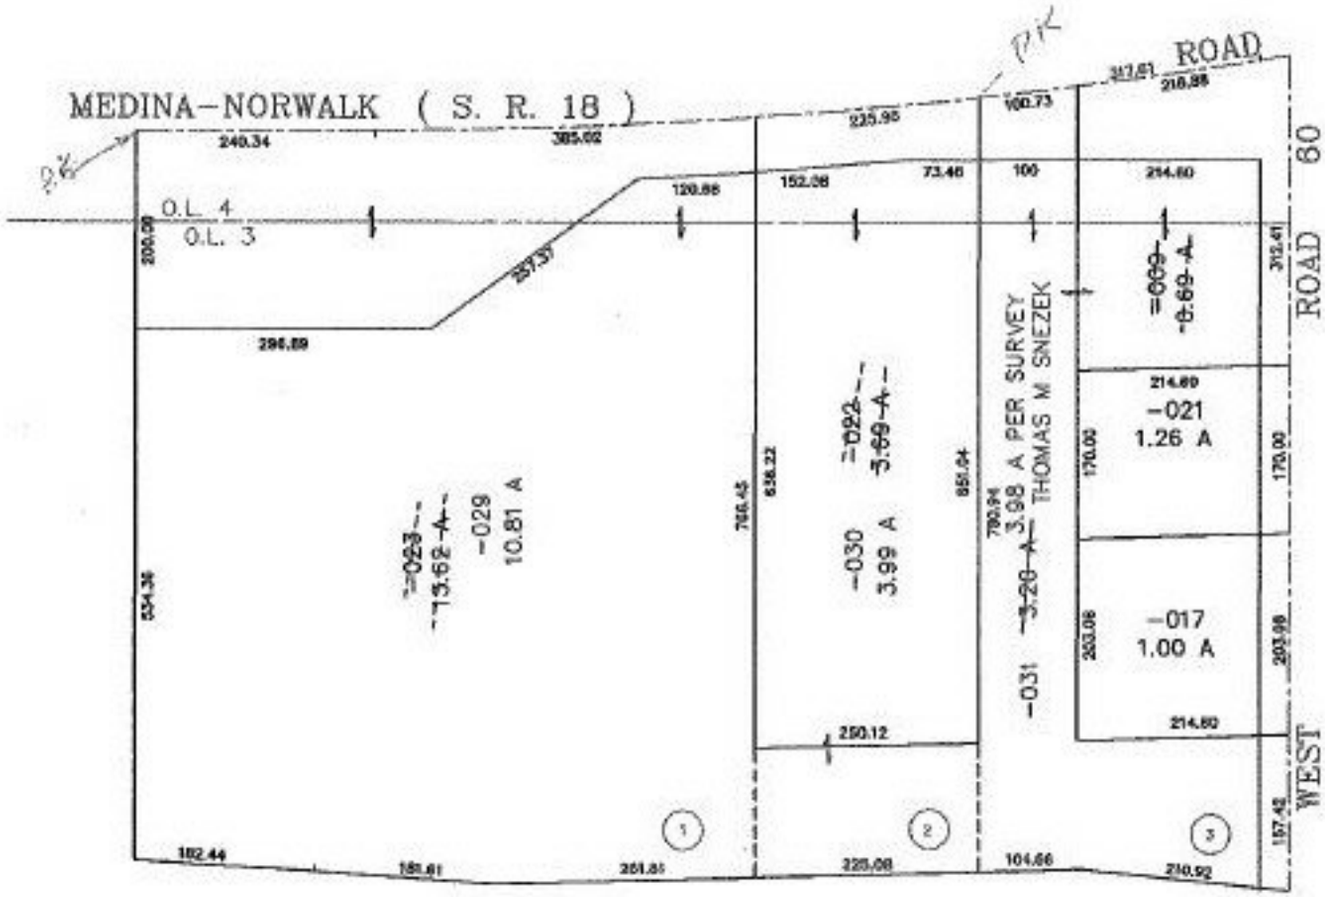

SPLITS/DEEDS PROCESSED
LORAIN COUNTY TAX MAP DEPARTMENT
226 MIDDLE AVE. ELYRIA, OHIO

SURVEYED BY: THOMAS M SNEZEK
CLOSURE: 0.35 / 10,000
MAP PAGE(S): 18-D & 18-H
APPROVED BY: F. COLBERT DATE: 9/3/98
SCALE: 1"= 200 PRIOR INSTRUMENT: OR1424/510