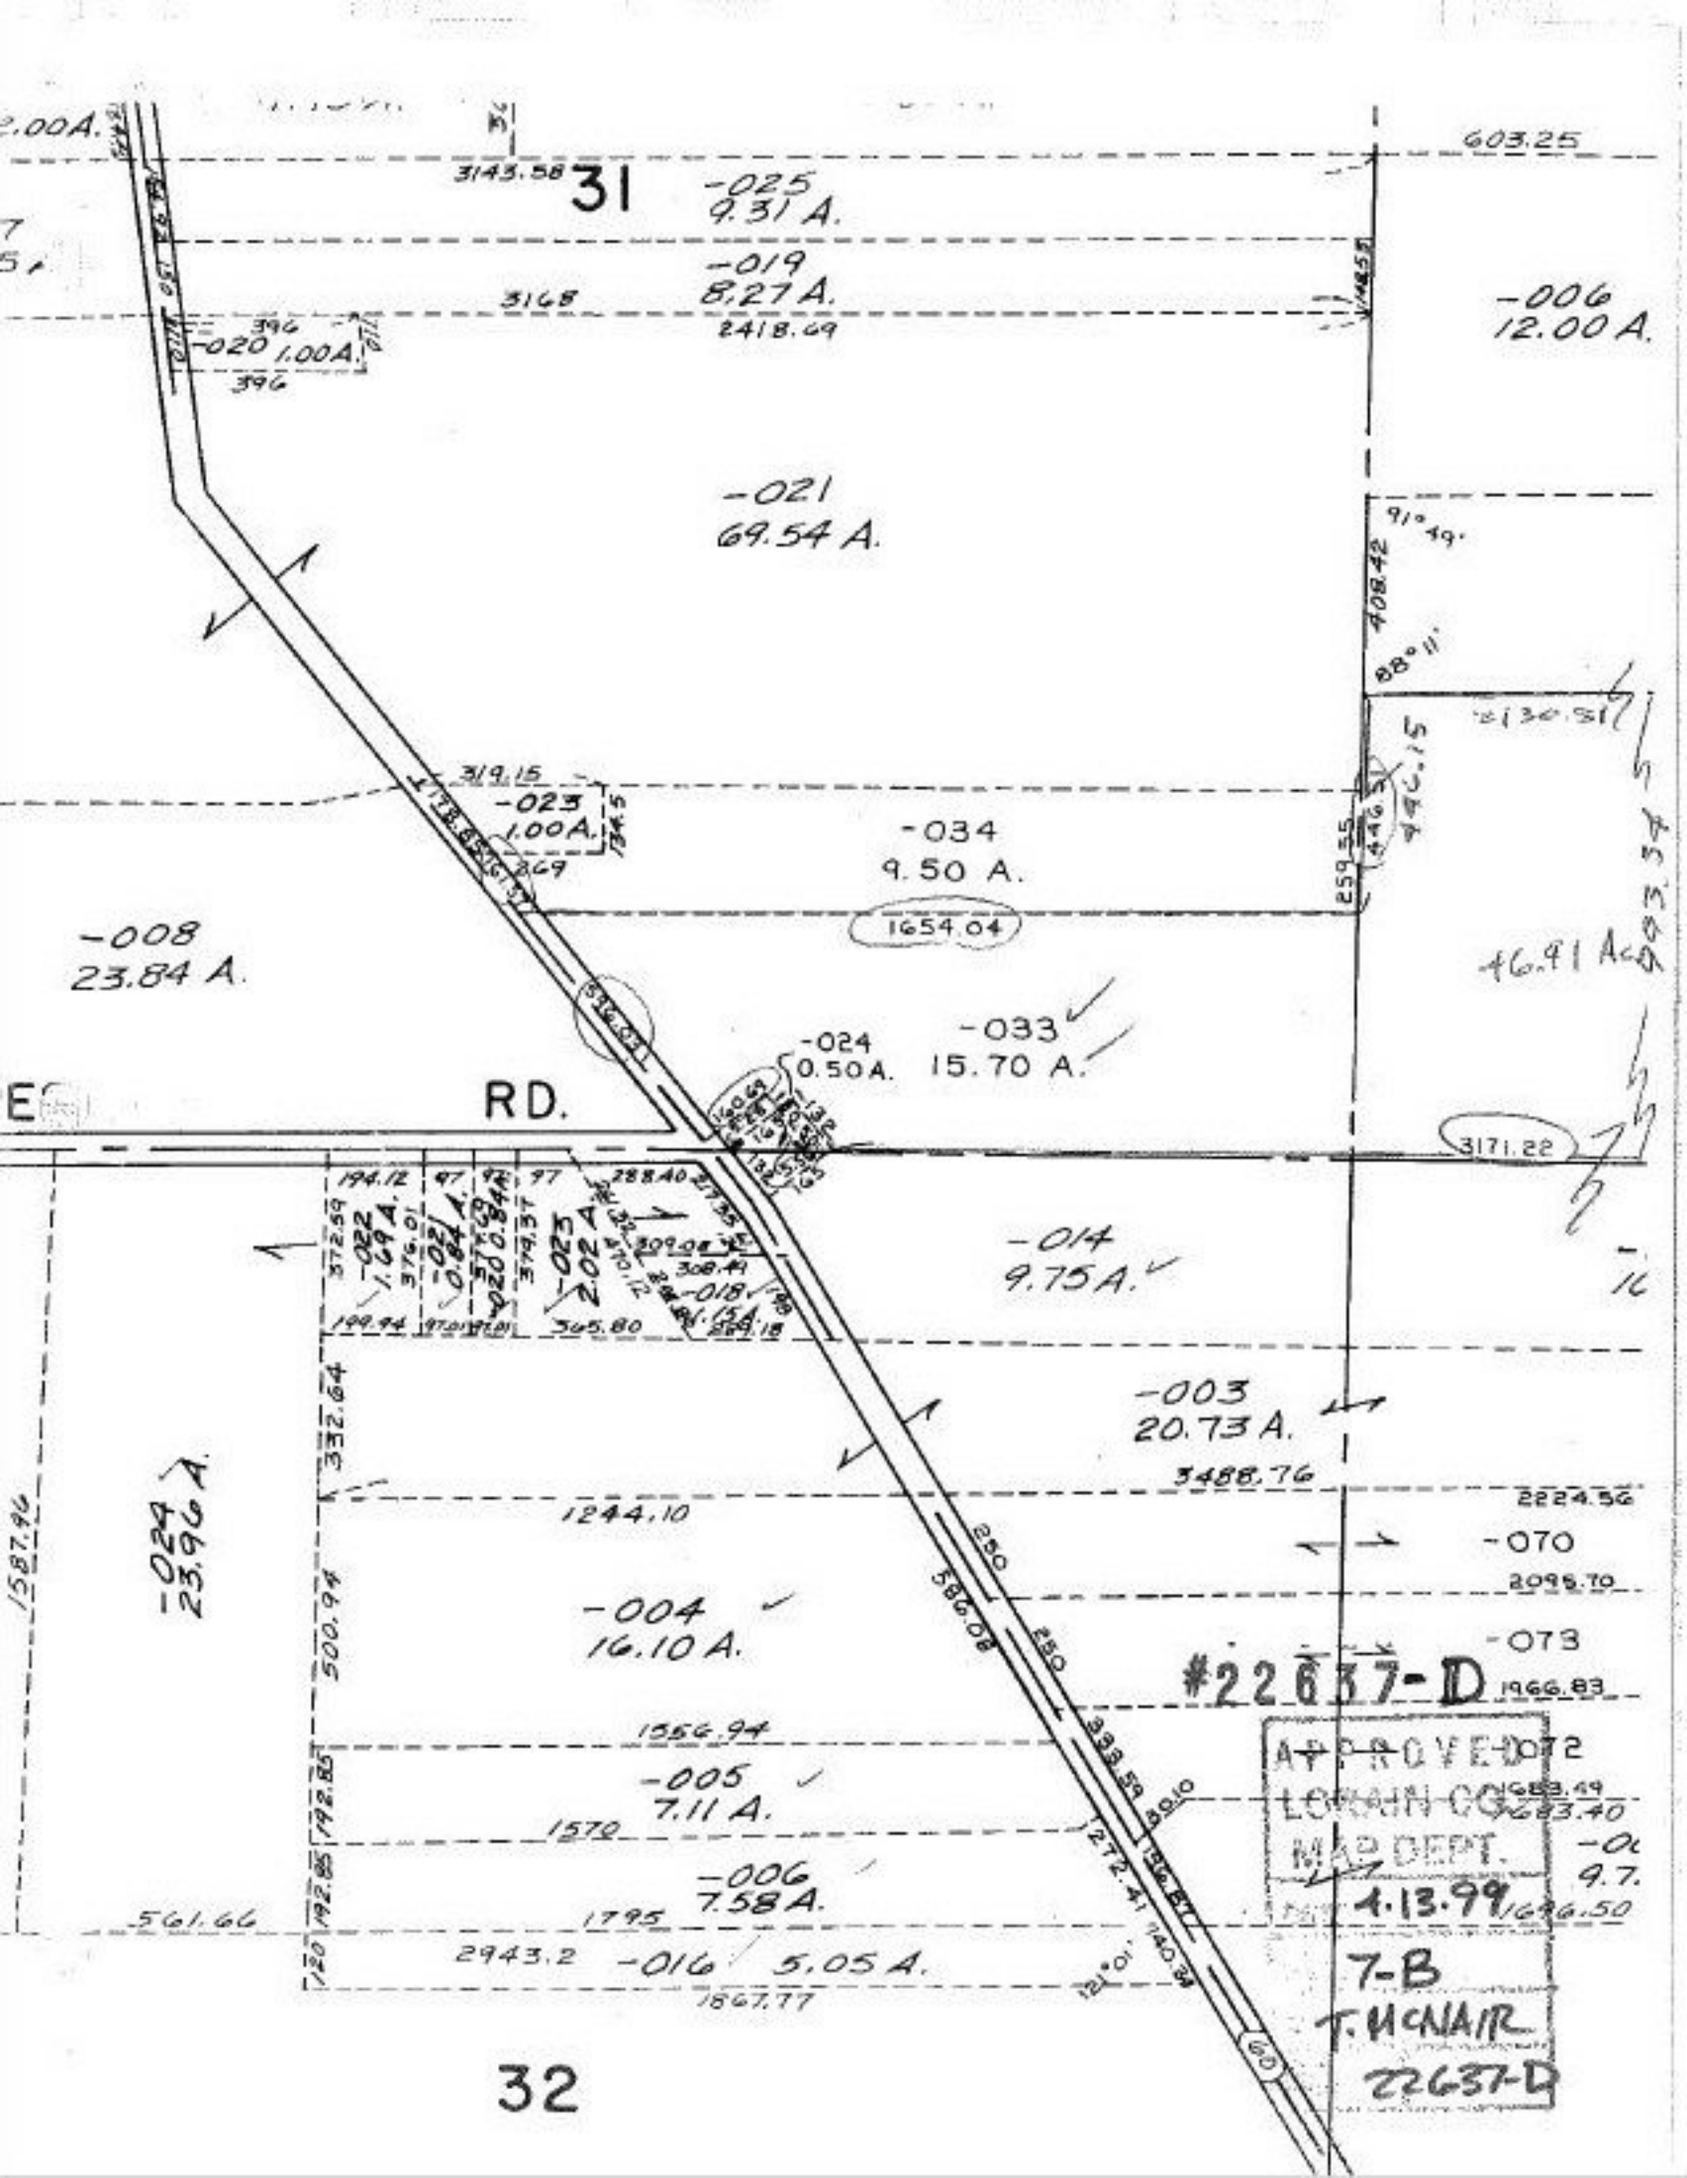
31
-025
9.31 A.
-019
8.27 A.
-020 1.00A.
-006
12.00 A.
-021
69.54 A.
-023
1.00A.
-034
9.50 A.
-008
23.84 A.
-024
0.50A.
-033
15.70 A.
RD.
46.91 Ac
-022
1.69 A.
-023
2.02 A.
-014
9.75 A.
-003
20.73 A.
-024
23.96 A.
-004
16.10 A.
-070
-073
#22637-D
-005
7.11 A.
-006
7.58 A.
-016
5.05 A.
APPROVED
MAP DEPT.
4.13.99
7-B
T. McNAIR
22637-D
32