PARENT PARCEL: 14-00-011-000-002, 14-00-030-000-008, 009, 024
CHILD PARCEL: 14-00-011-000-004, 005, 14-00-030-000-044
STARTING POINT: MONUMENT BOX AT THE SE CORNER OF O.L. 11

NO. 22638

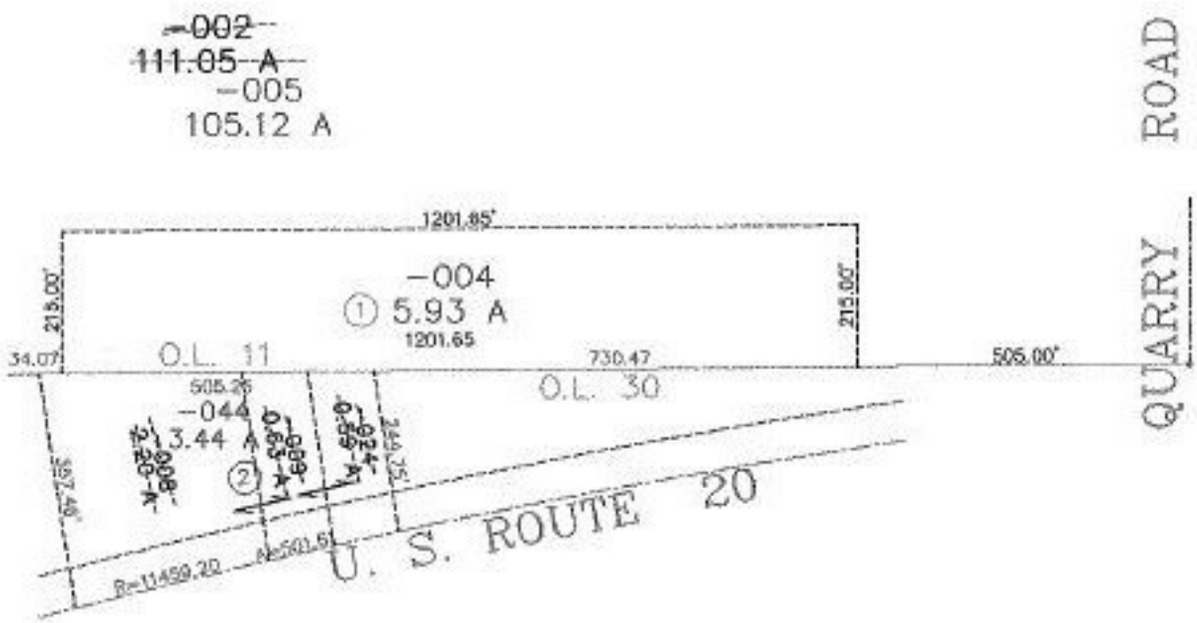


6-24-99
M.B.

SPLITS/DEEDS PROCESSED
LORAIN COUNTY TAX MAP DEPARTMENT
226 MIDDLE AVE. ELYRIA, OHIO

SURVEYED BY: DAVID L. ELWELL
CLOSURE: 0.00 / 10,000
MAP PAGE(S): 14-A
APPROVED BY: F. COLBERT DATE: 9/11/98
SCALE: 1"= 300 PRIOR INSTRUMENT: 00003/311 00300/207