PARENT PARCEL: 09-00-104-000-021, 022, & 14-00-007-000-001

CHILD PARCEL: XX-XX-XXX-XXX-XXX

STARTING POINT: I.P. AT THE S.W. CORNER OF O.L. 7

NO. 22641-X

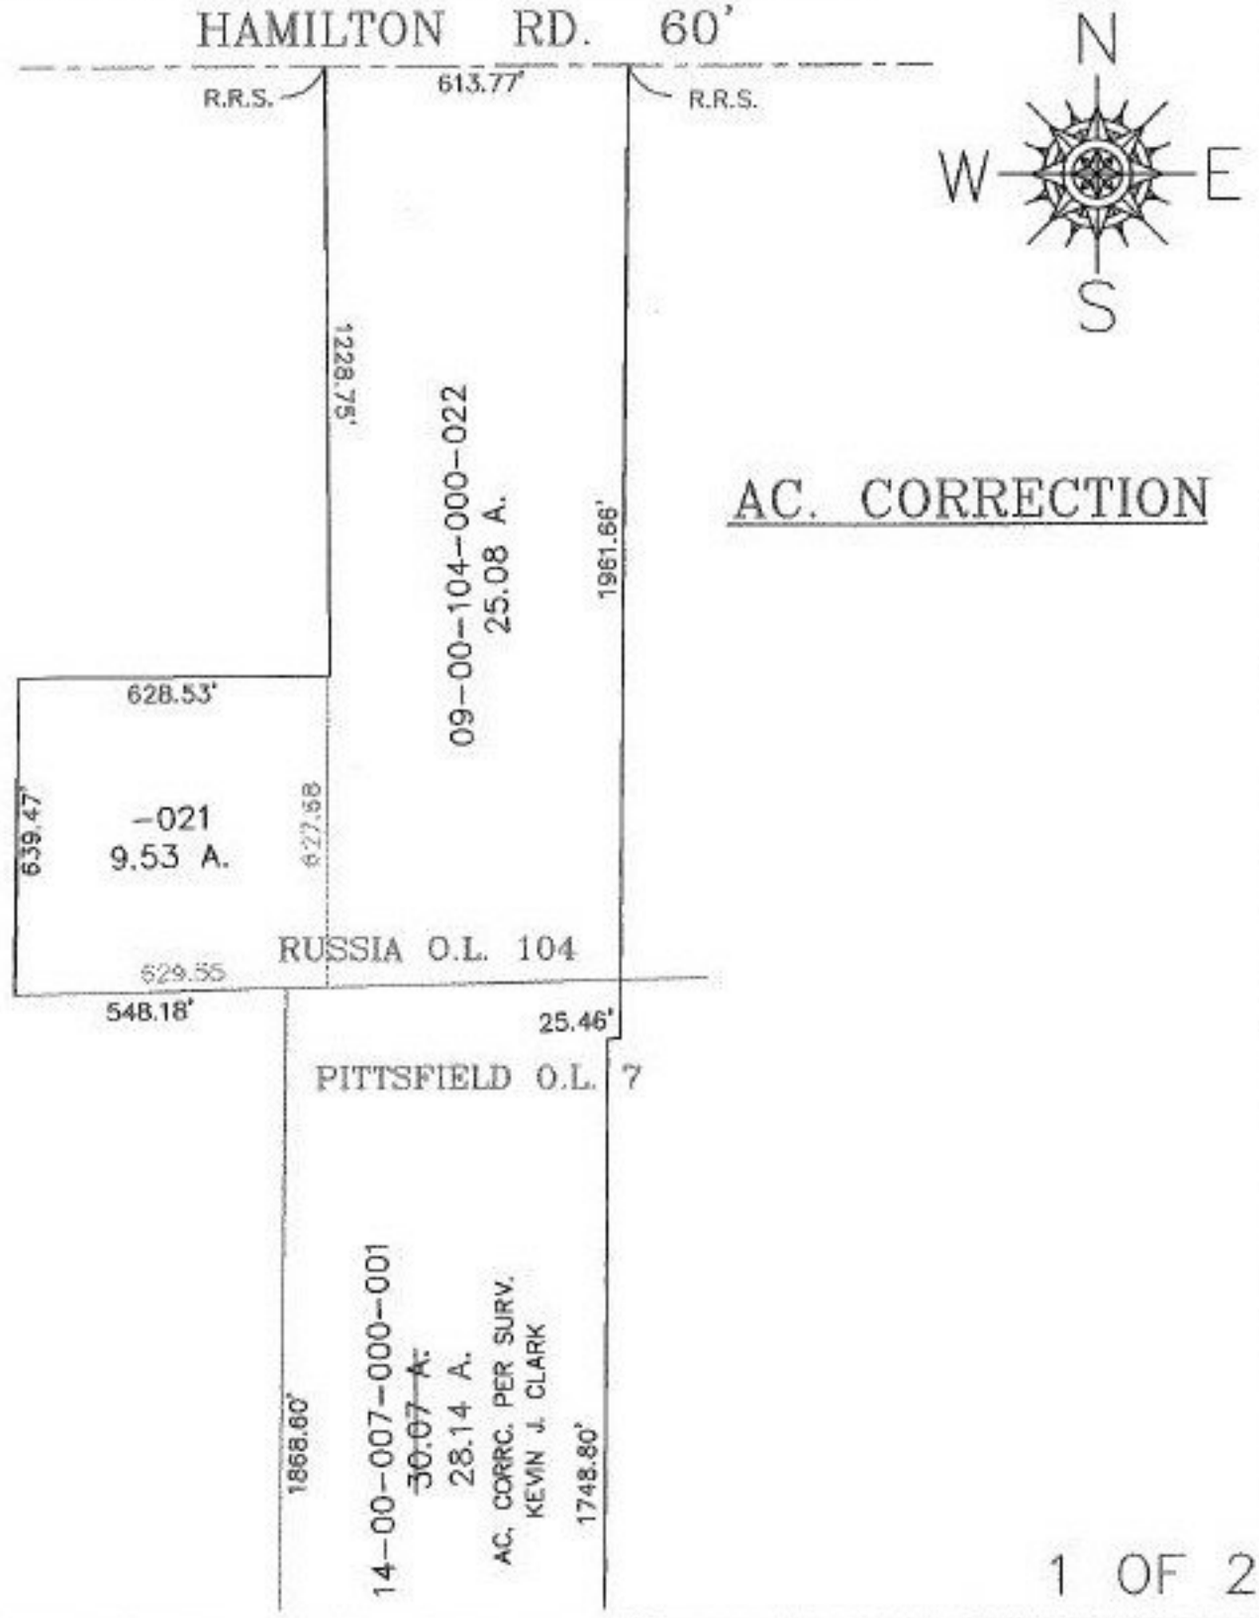

1 OF 2

SPLITS/DEEDS PROCESSED

LORAIN COUNTY TAX MAP DEPARTMENT

226 MIDDLE AVE. ELYRIA, OHIO

SURVEYED BY: KEVIN J. CLARK

CLOSURE: 0.01 : 10,000

MAP PAGE(S): 14-B & 09-00-104-A & B

APPROVED BY: TJS DATE: 09/08/98

SCALE: 1"= 400 PRIOR INSTRUMENT: OR 909/912

6-21-99