PARENT PARCEL: 03-00-113-107-046

CHILD PARCEL: 03-00-1130107-053, 054

STARTING POINT: C/Ls NORTH RIDGE ROAD & CAREK COURT

NO. 22655

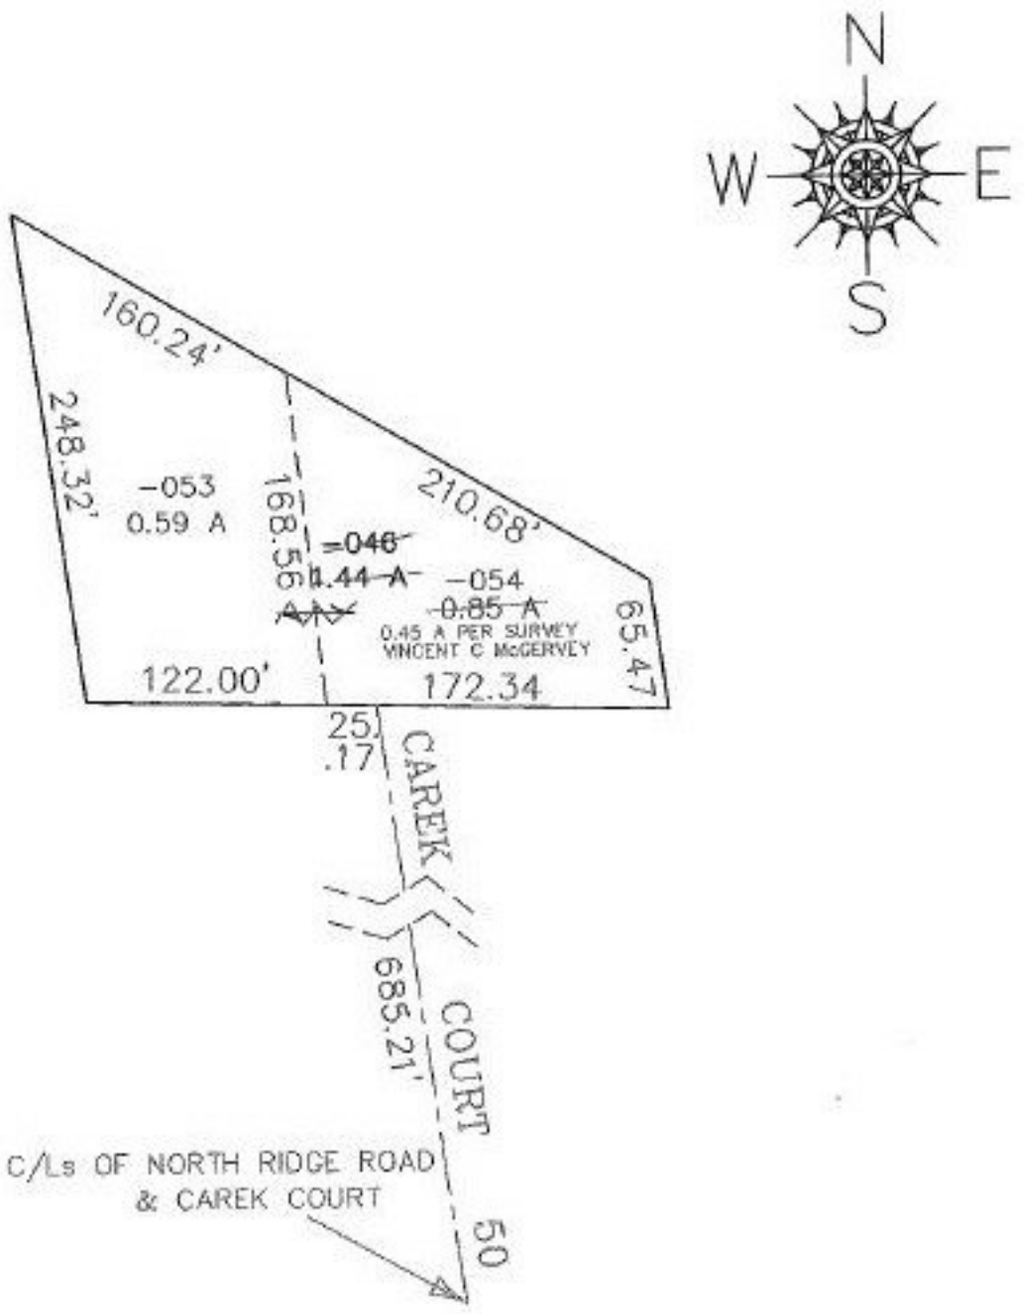

TB
4-30-99

SPLITS/DEEDS PROCESSED

LORAIN COUNTY TAX MAP DEPARTMENT
226 MIDDLE AVE. ELYRIA, OHIO

SURVEYED BY: VINCENT C McGERVEY

CLOSURE: .013 / 10.000

MAP PAGE(S): 3-00-113-B

APPROVED BY: F. COLBERT DATE: 9/23/98

SCALE: 1"= 100 PRIOR INSTRUMENT: 970500112