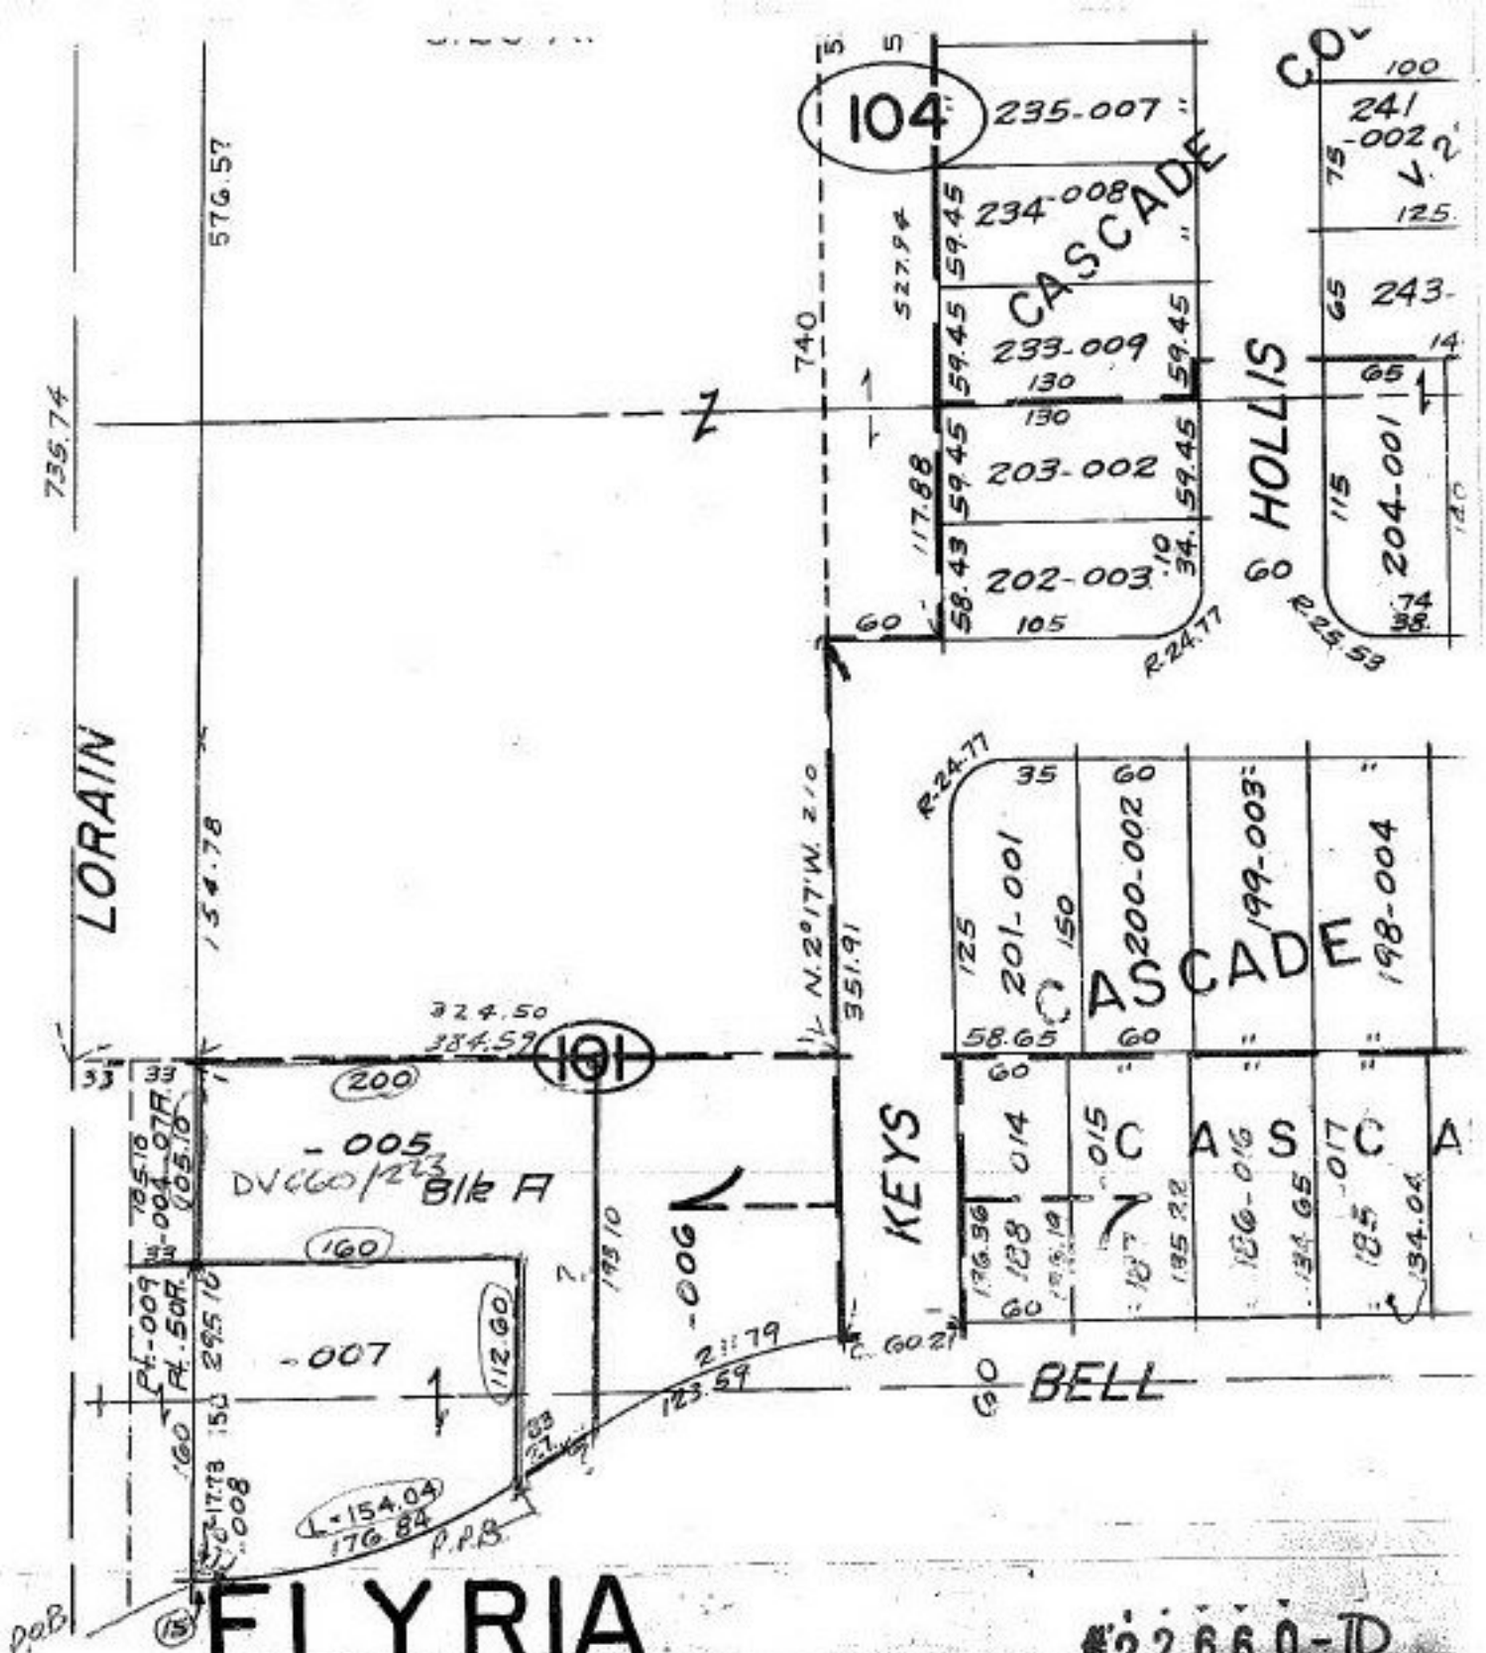

#22660-D

APPROVED
LORAIN CO.
MAP DEPT.
DATE 9.30-98
BY: G-64
T-SPILLMAN TAM
22660-D

SURVEY & UPDATE
LEGAL BEFORE NEXT
TRANSFER.